




# MONROE COAL MINING COMPANY COLUMNAR SECTION EDWARDS SHAFT. MINE NO. 32

## REVLOC, PA.

Scale: 1/8" = 1'-0"

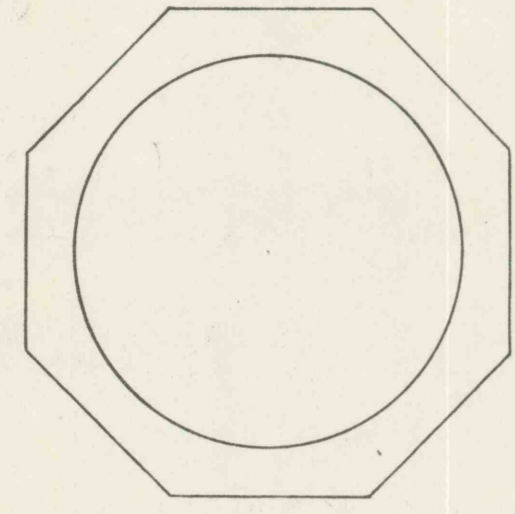

### CONCRETING LOG

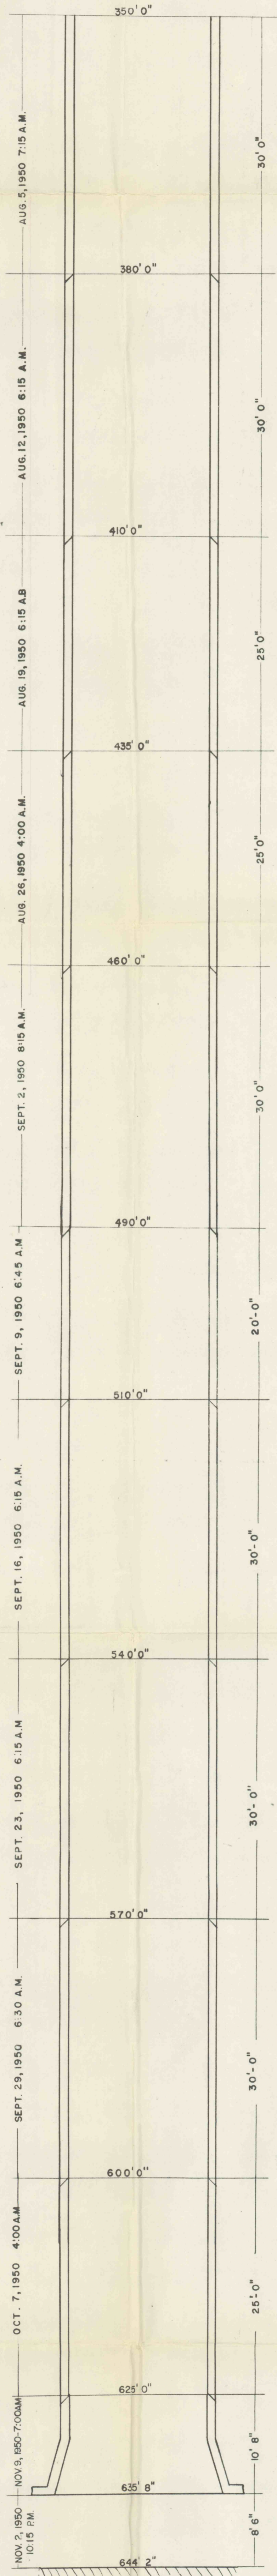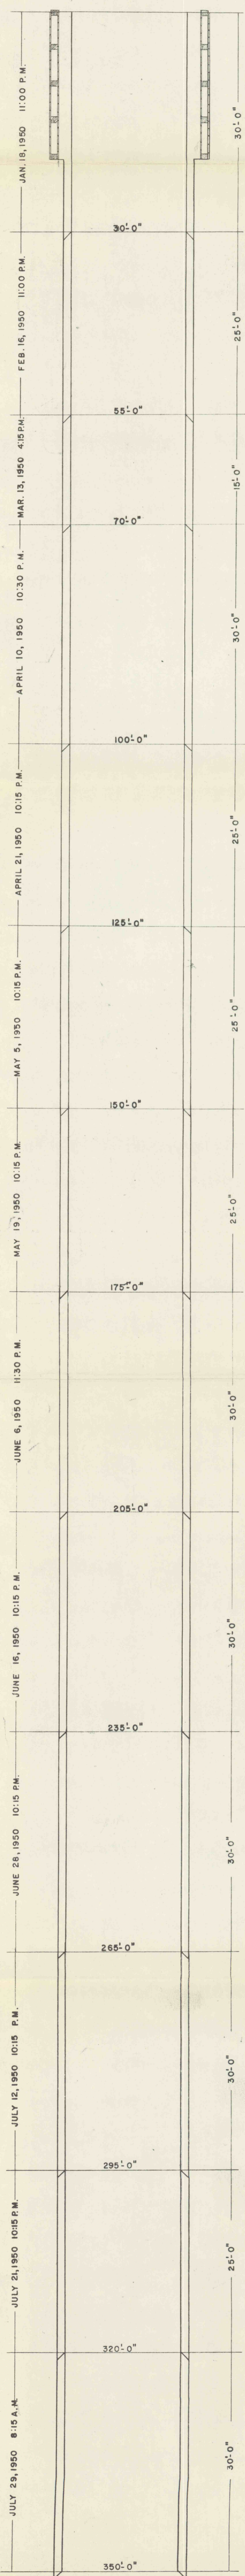

DEC. 14, 1949  
ELEV. TOP COPING 2064.00  
ELEV. BOTTOM COAL 1419.82  
TOTAL DEPTH 644.18

### SHAFT SINKING LOG

