

MORRONE COAL COMPANY
STRIP NO. II
 SURVEY BY: T. HOWORTH
 MAPPED BY: M.L.B. & J.M.M.C.
 SCALE: 1" = 200'
 REVISED (SECTION I)
 MAY 20, 1963

ENGINEER

C.B.C. CORP. - FEE

J. HINES TRACT
C.B.C. CORP. - FEE

JOHN MC KENDRICK TRACT
C.B.C. CORP. - 2/3 INT.
R.C. CO. - 1/3 INT.

JAMES MC KENDRICK TRACT
C.B.C. CORP. - 2/3 INT.
R.C. CO. - 1/3 INT.

IRVIN GIBSON TRACT

NOTE - A
 OFFICE OF MINE DRAINAGE SECTION, PA. DEPT. OF HEALTH,
 GREENSBURG, PA. SEPT. 27, 1960 - AGREEMENT
 BETWEEN THE CLYMER CITIZENS WATER CO. AND
 MORRONE COAL CO. FOR THE PURPOSE OF PROTECTING
 THE WATER SUPPLY LINES, THERE IS TO BE NO STRIPPING
 FOR A MINIMUM OF 700 FT. EXTENDING IN A NORTHEAST WARD
 DIRECTION FROM THE VICTOR NO 47 PORTAL LOCATION.


NOTE - B
 AS REQUESTED BY THE IMPERIAL COAL CORP., 560' FT.
 OF EXPOSED COAL FACE ALONG THE HIGHWALL WAS NOT
 COVERED TO PROVIDE SPACE FOR THE CHERYHILL NO. 1
 MINE OPENINGS.

NOTE C
 ADDITIONAL GRADING OF ORIGINAL SPOIL IN THIS
 AREA WAS NECESSARY FOR ROADS, DRAINS,
 STRUCTURES, ETC., FOR THE CHERYHILL
 NO. 1 MINE

NOTE D
 AFFECTED STRIP LAND IN THIS AREA
 FOR MINE REFUSE FROM THE CHERYHILL
 NO. 1 MINE

SECTION (1) TO 5-7-63
 SURFACE NOW - CLYMER CITIZENS WATER CO.
 COAL - C.B.C. CORP. 2/3 ; K. LEASURE 1/3.
 5-7-63 - 1,627 A.
 5-7-63 - 2,352 A.

CLYMER BORO

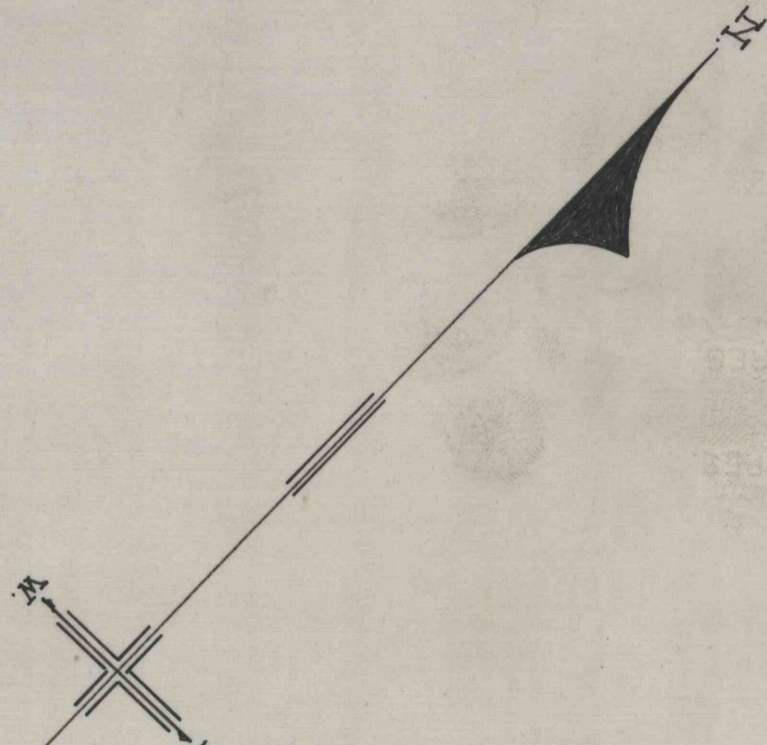

SECTION (2) OF MORRONE NO. 11 STRIP OPERATION

SECTION (1) OF MORRONE NO. 11 STRIP OPERATION

9.33 A.

SECTION (2) WITH 50' 2ND CUT WILL MAKE APPROX. 22 A.

DIRECTED BY