



NOTE  
 STRIPPING AREA ON ROY C BURKHART TRACTS  
 HAS BEEN BACKFILLED AND APPROVED  
 REFERENCE:  
 PLAN N<sup>o</sup> 56-9-67 (1"=100')  
 PLAN N<sup>o</sup> 57-5-122 (1"=100')

LEGEND

- MINING GEOLOGY
- UPPER FREEPORT OR E SEAM
  - LOWER FREEPORT OR D SEAM
  - MIDDLE KITTANNING OR C SEAM
  - LOWER KITTANNING OR B SEAM
  - BROOKVILLE OR A SEAM


32.88 ACRES BACKFILLED - OCT. 14, 1959

AFFECTED AREA		
LETTER	SURVEY DATE	ACREAGE
A	Sept. 16, 1957	26.177
B	Dec. 3, 1958	31.03

MAP SHOWING  
 BITUMINOUS COAL STRIPPING OPERATIONS  
 OF  
 ROY C. BURKHART

SITUATE IN  
 ALLEGHENY TWP, BLAIR CO., PENNA.  
 SCALE 1 IN. = 400 FT.

LEWIS L. GWIN - CONSULTING ENGINEERS  
 JOHN W. FOREMAN, MINING ENGINEER  
 ALTOONA, PENNSYLVANIA

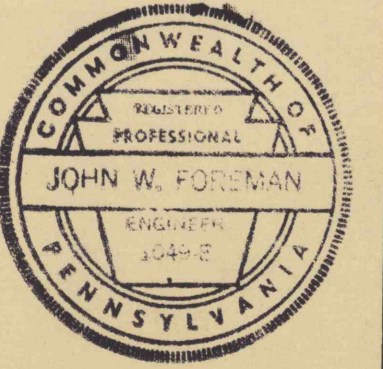

PLAN N<sup>o</sup> 58-12-76