

Warrant # 4185

Penna. Dept. of Forests and Waters
Warrant # 4889


Warrant # 5062

Warrant # 5061

3/29/64 - Add The Spoil

Confidential

COMPASS COAL CO.	
WILSON #1	
HUSTON TOWNSHIP CLEARFIELD CO., PA	
SCALE — 1 inch = 400 feet	
FEBRUARY 23, 1966 CLEARFIELD, PA.	JOHN W. HESS ENGINEER

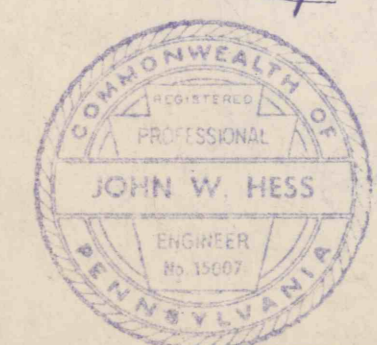

L. Bird

Senior L.P.