

COLOR	PERMIT NO.	ACREAGE
[White]	1137-4(C)	45.0
[White]	1137-5	8.3
[Yellow]	MDR	
[Orange]	Banded Area	
[White]	COMPLETION	
[White]	DELETION	
[White]	TOPSOIL	
[White]	PREVIOUSLY AFFECTED	

LEGEND

DWELLING ■ OTHER □

ROADS ——— OR - - - - -


PROPERTY LINE - - - - -

CONTOUR LINE - - - - - 1200 - - - - -

CREEKS ———

GAS WELLS ⊕ ⊕

BARRIER LINE ———

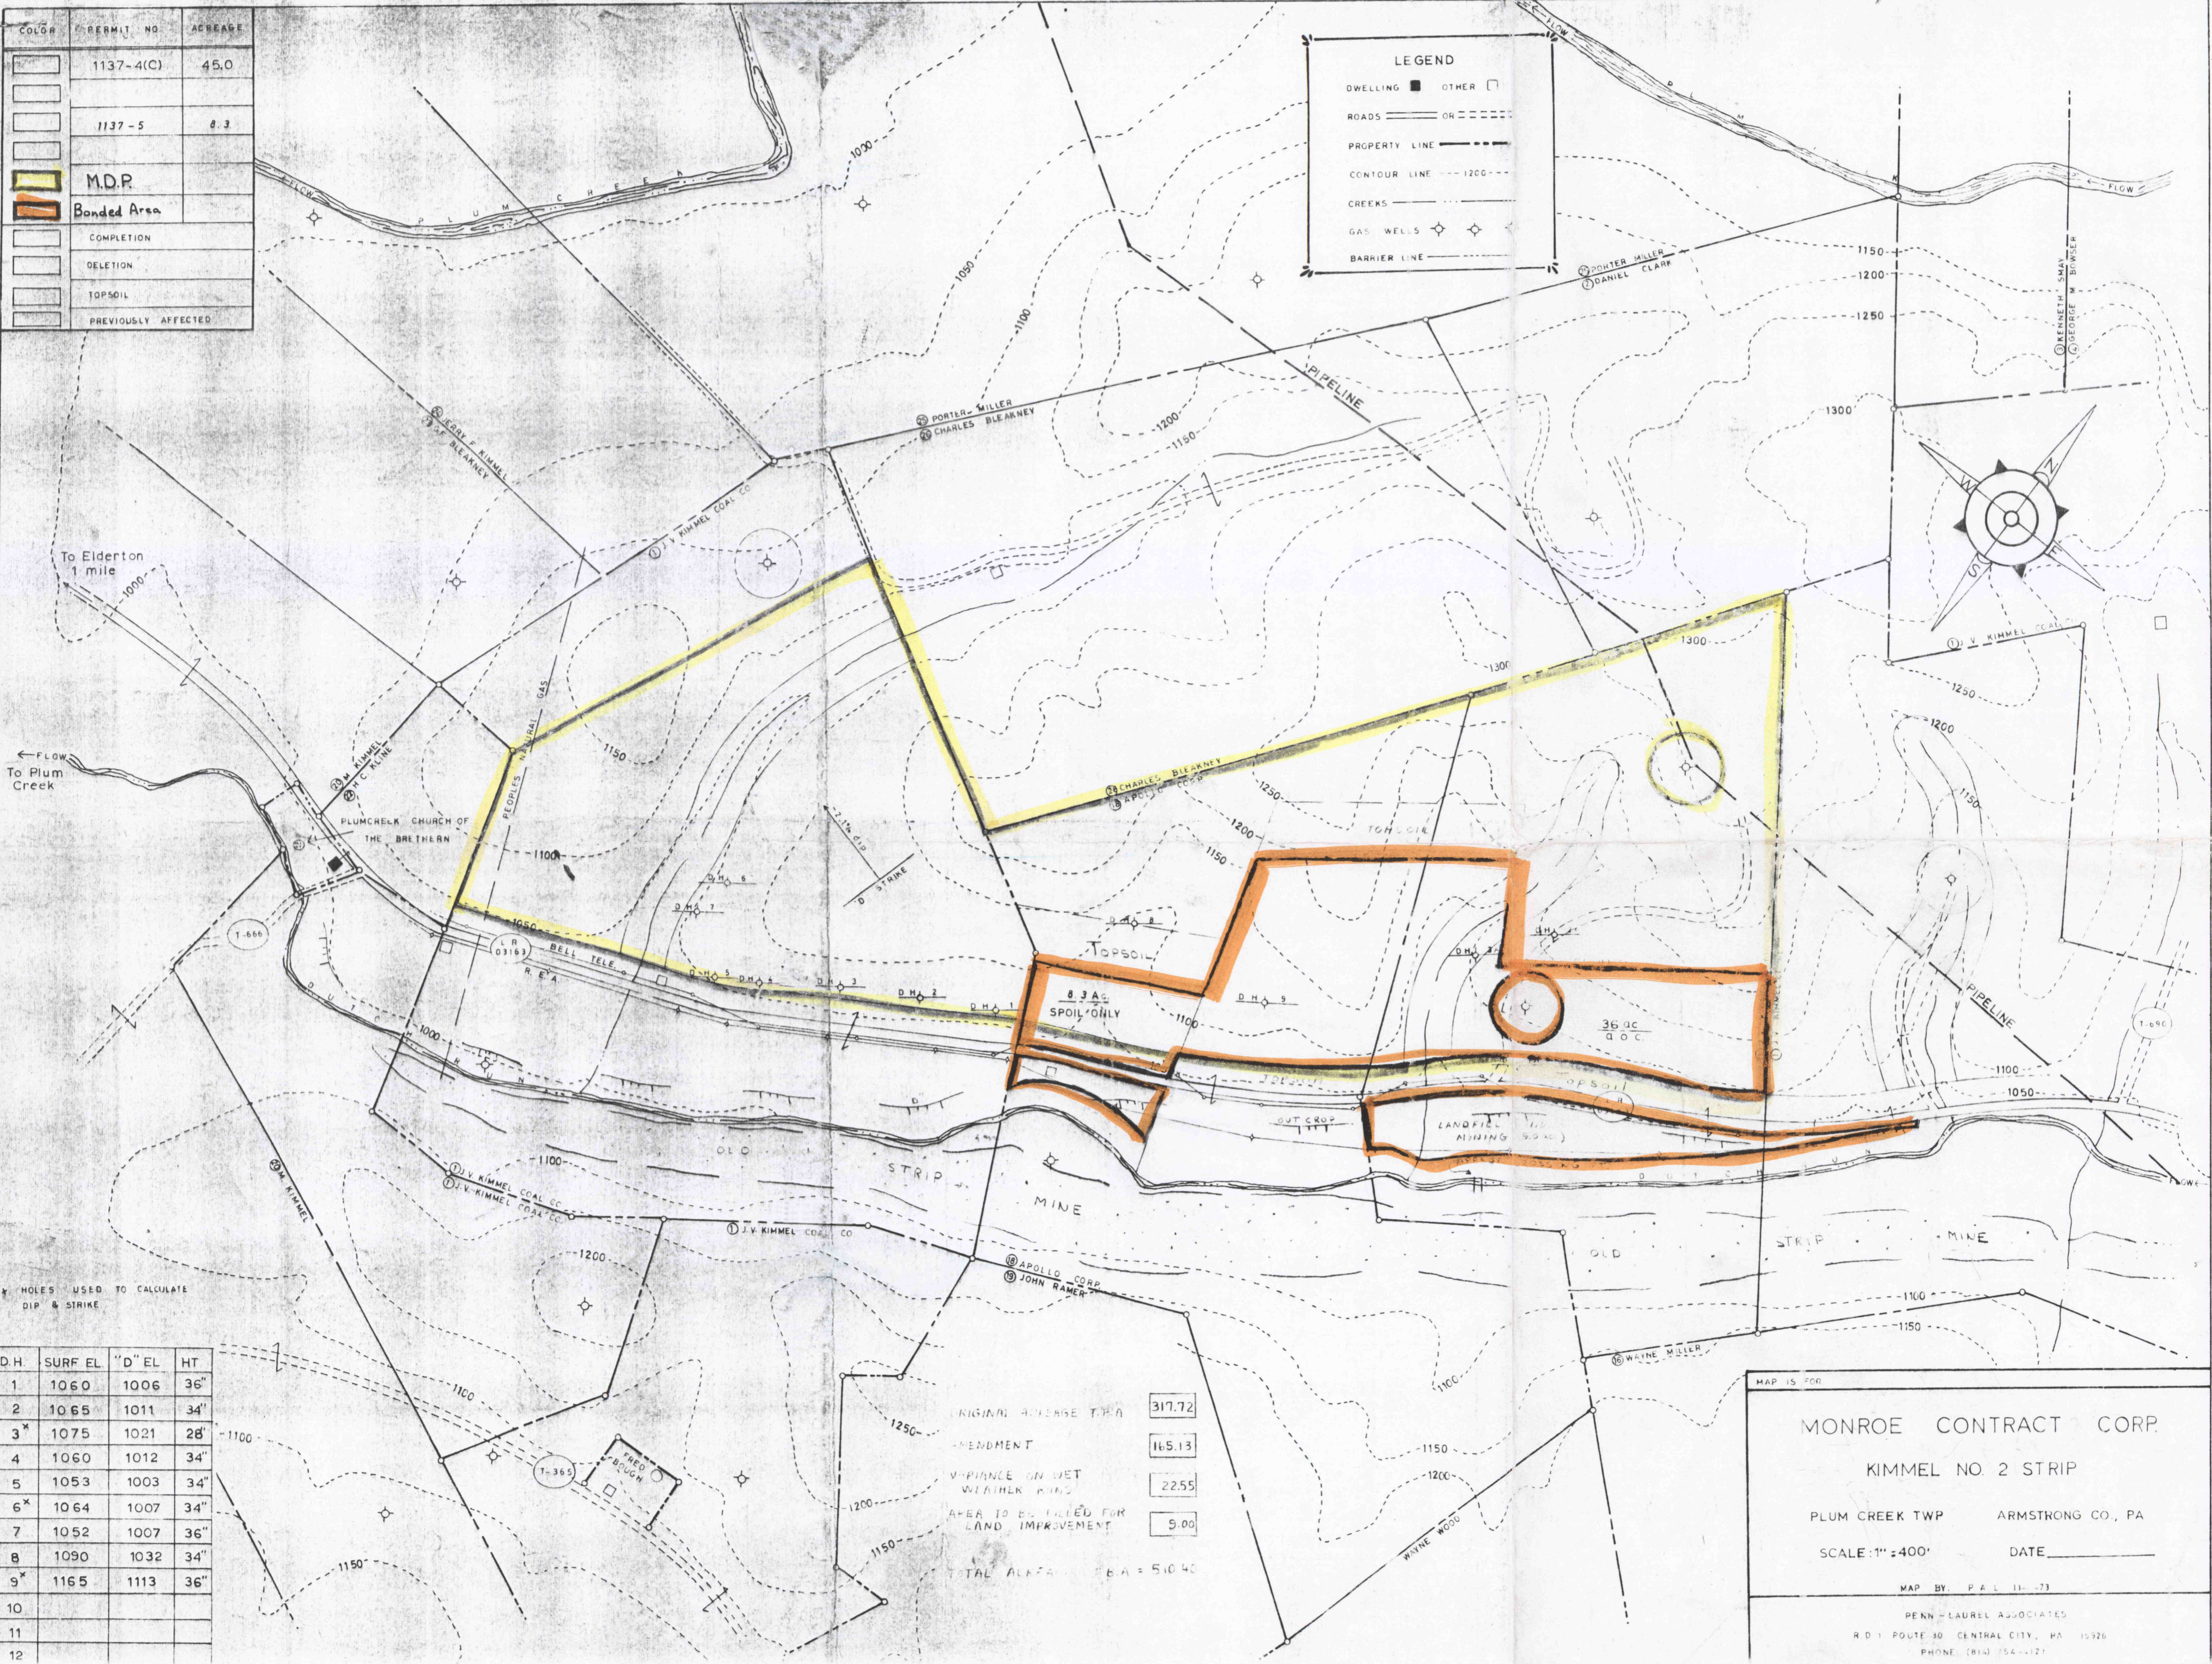

HOLES USED TO CALCULATE DIP & STRIKE

D.H.	SURF EL.	"D" EL.	HT.
1	1060	1006	36"
2	1065	1011	34"
3*	1075	1021	28"
4	1060	1012	34"
5	1053	1003	34"
6*	1064	1007	34"
7	1052	1007	36"
8	1090	1032	34"
9*	1165	1113	36"
10			
11			
12			

ORIGINAL AVERAGE T.P.A.	317.72
AMENDMENT	165.13
VARIANCE ON NET WEATHER KING	22.55
AREA TO BE FILLED FOR LAND IMPROVEMENT	9.00
TOTAL AVERAGE T.P.A. =	510.40

MAP IS FOR

MONROE CONTRACT CORP.

KIMMEL NO. 2 STRIP

PLUM CREEK TWP ARMSTRONG CO., PA

SCALE: 1" = 400' DATE _____

MAP BY: P.A.L. 11-73

PENN - LAUREL ASSOCIATES
R.D. 1, ROUTE 30, CENTRAL CITY, PA 16926
PHONE: (814) 754-1171