



4506



WOODED

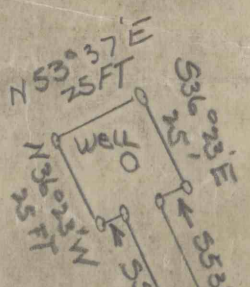

R/W FOR PIPE LINE TO DAMTENDERS DWELLING
 S 36° 23' E → 416.30
 N 36° 23' W ← 416.47

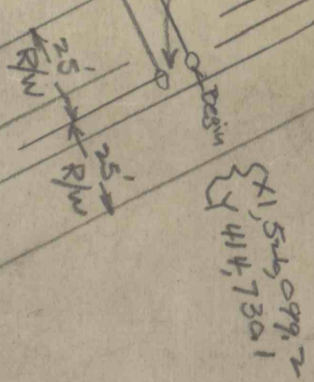

Route No 185
 N 52° 39' E
 PUBLIC MACADAM ROAD
 3/7.2

Loyalhanna 5809
 4 RAILROAD SPIKES
 X 1,525, 796.5
 + Y 414, 499.5

SCALE 1" = 50'

L.H. 5869