


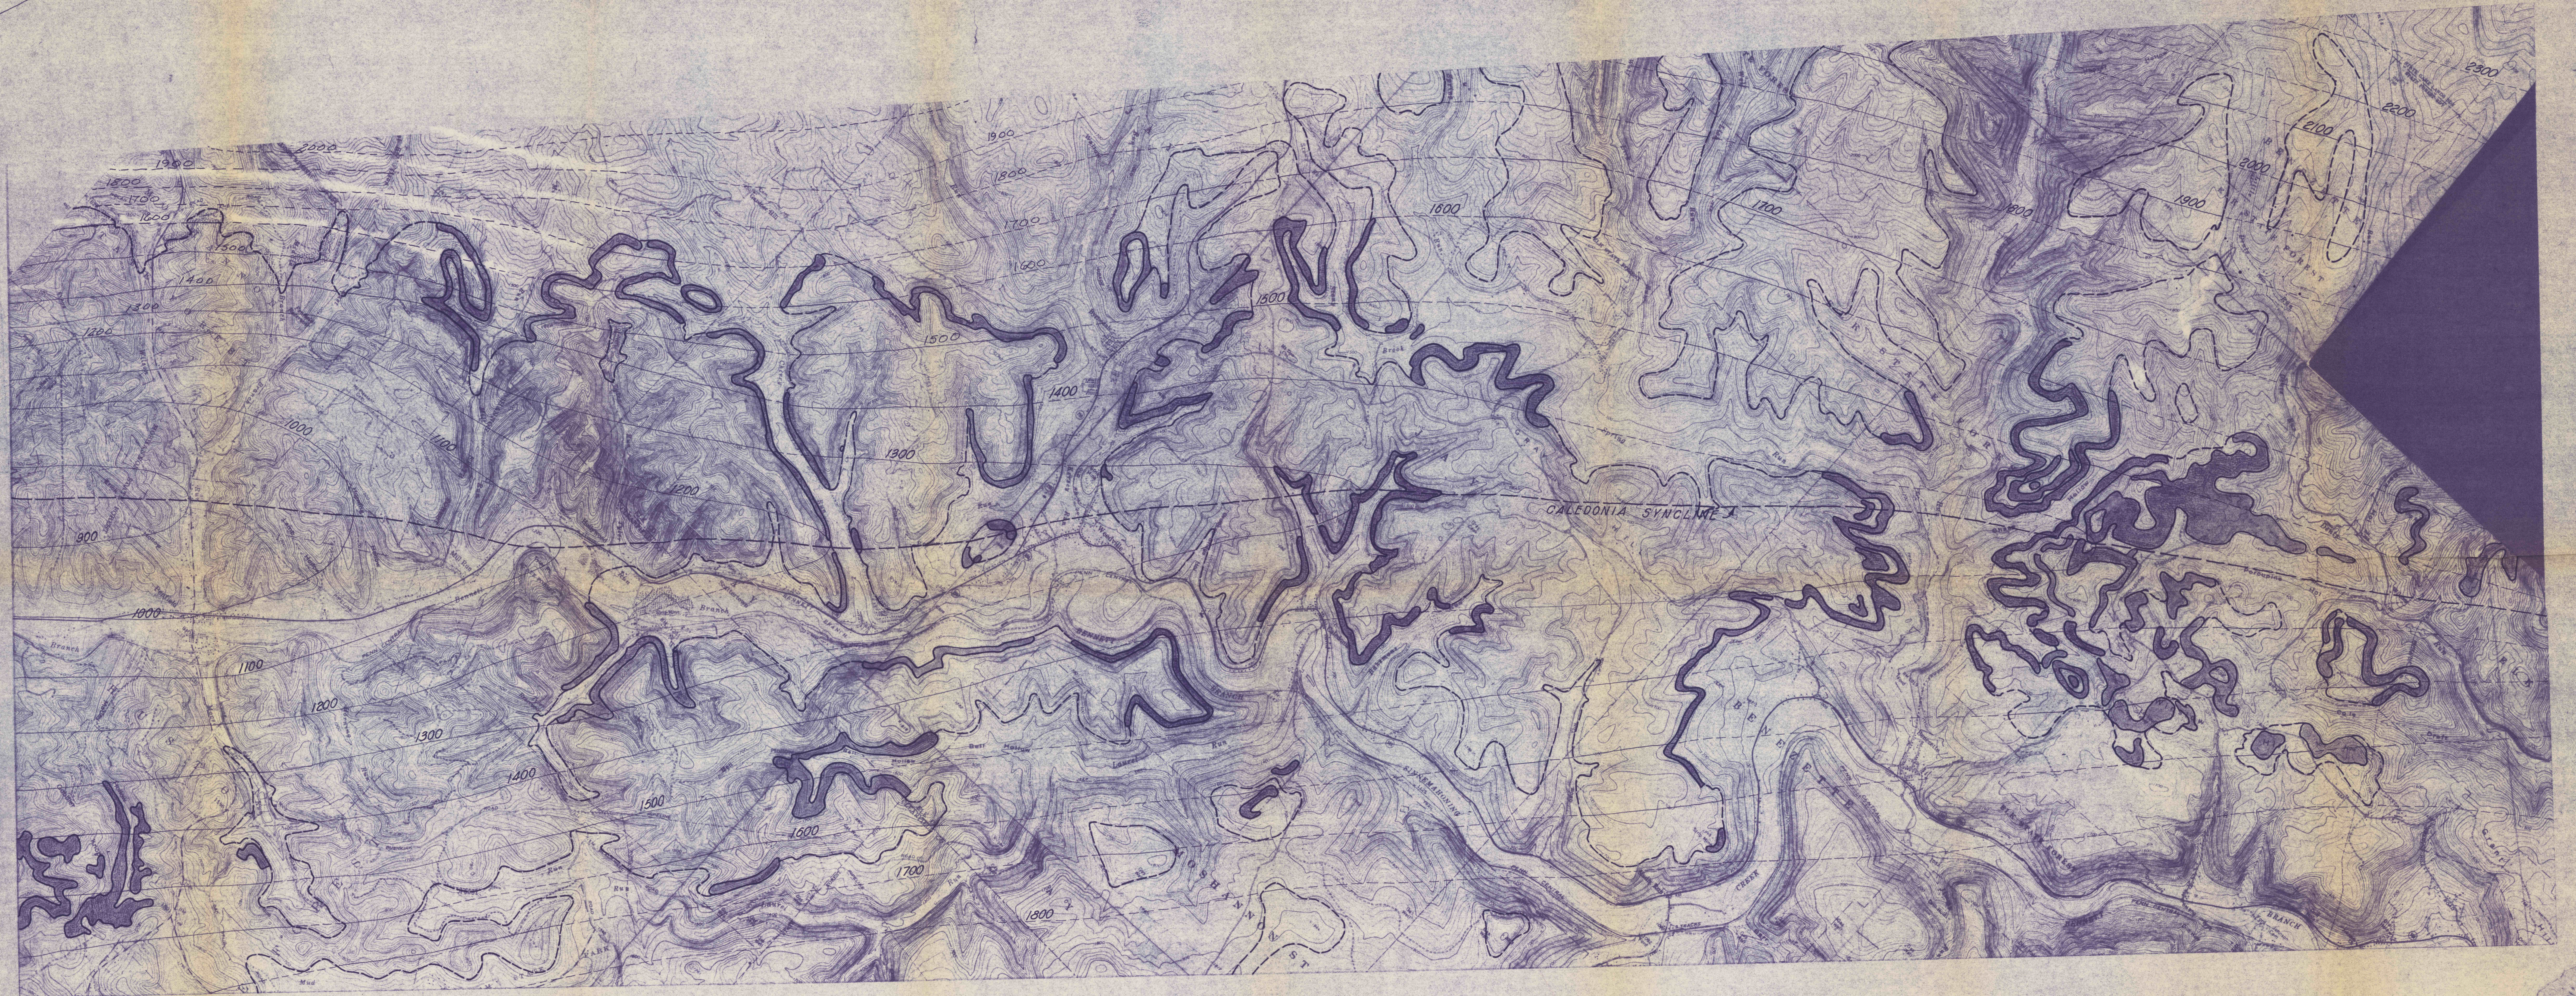

#558
6-25-99
C.C.

Clearfield & Elk Counties
Various Strip Mine Locations

PGS - 325489

Strippings
&
Coal Con tours

ZEA

Photocopy of original