


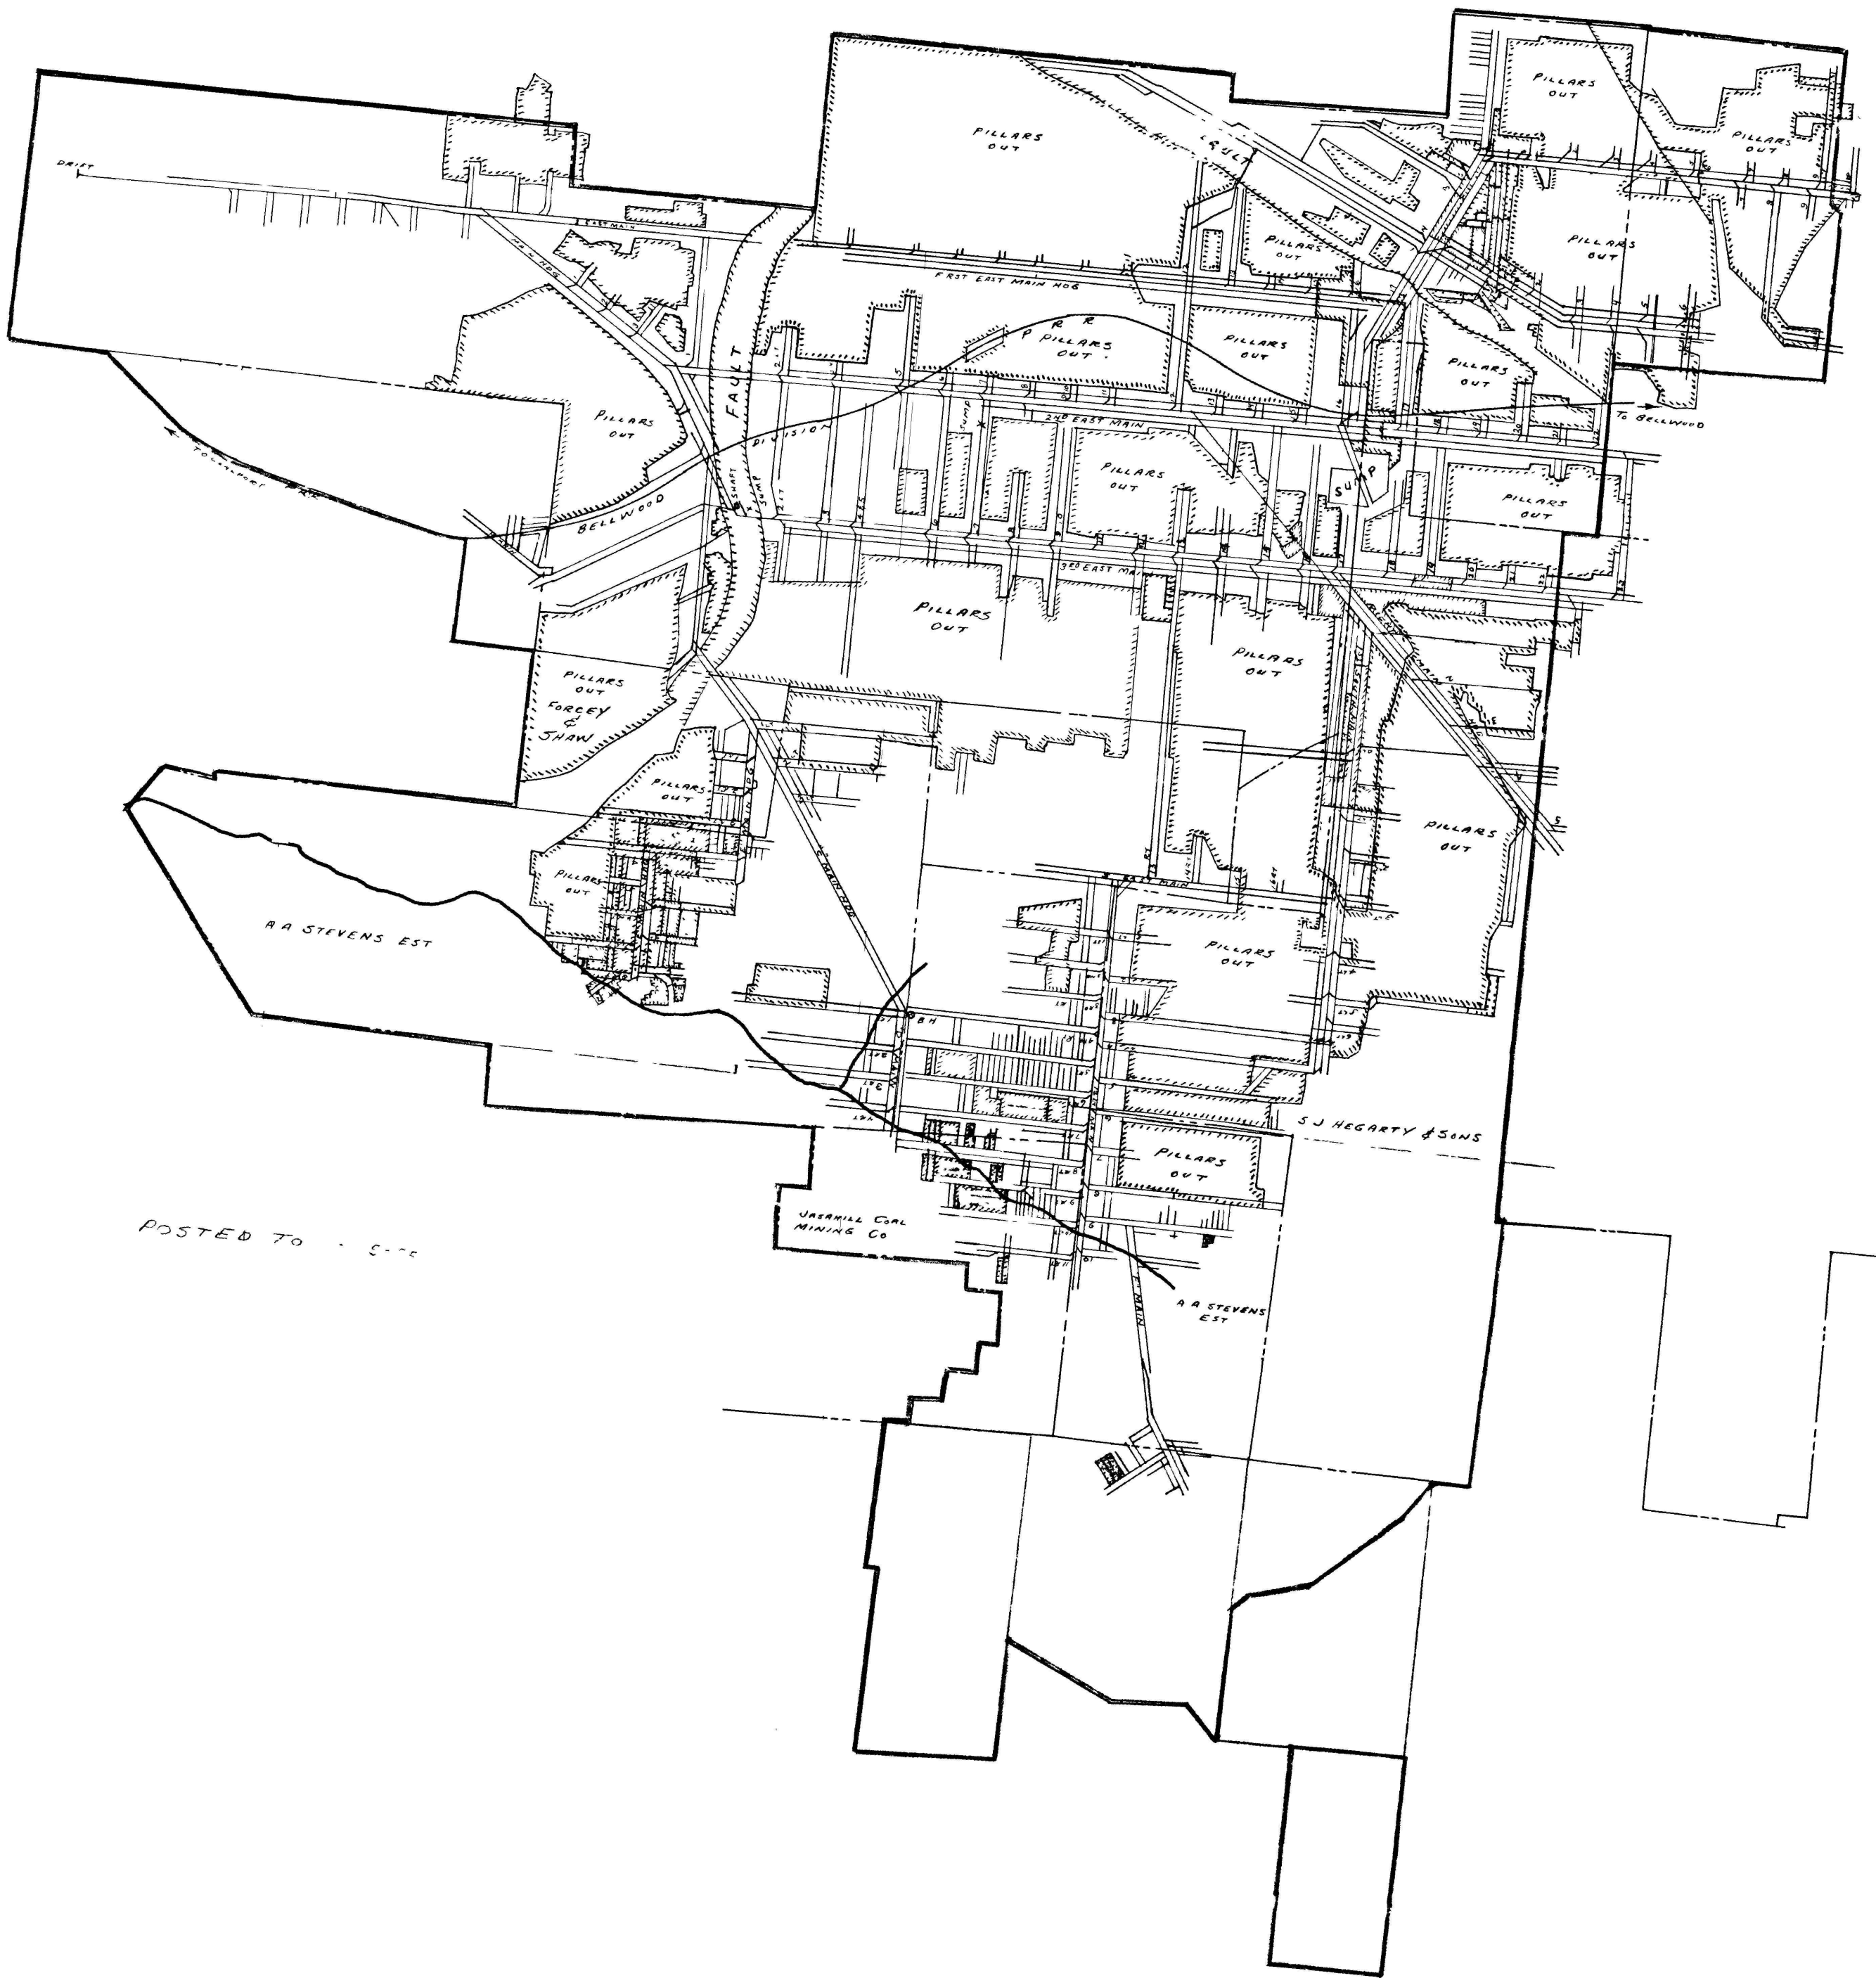

POSTED TO - S-11

INDICATES COAL FIELD

NOTE: No gas or oil wells

Agnes Coal Co
Cambria Smokeless No. 1
District 27 1954 Annual
MAP SHOWING
MINING OPERATIONS 27-1951
OF
CAMBRIA SMOKELESS COAL CO.
SITUATE IN Co. RITT.
BECCARIA, TWP. CLEARFIELD Co., PA
FEB. 8, 1952 SCALE 1"=1000'
FETTERMAN ENG. CO.