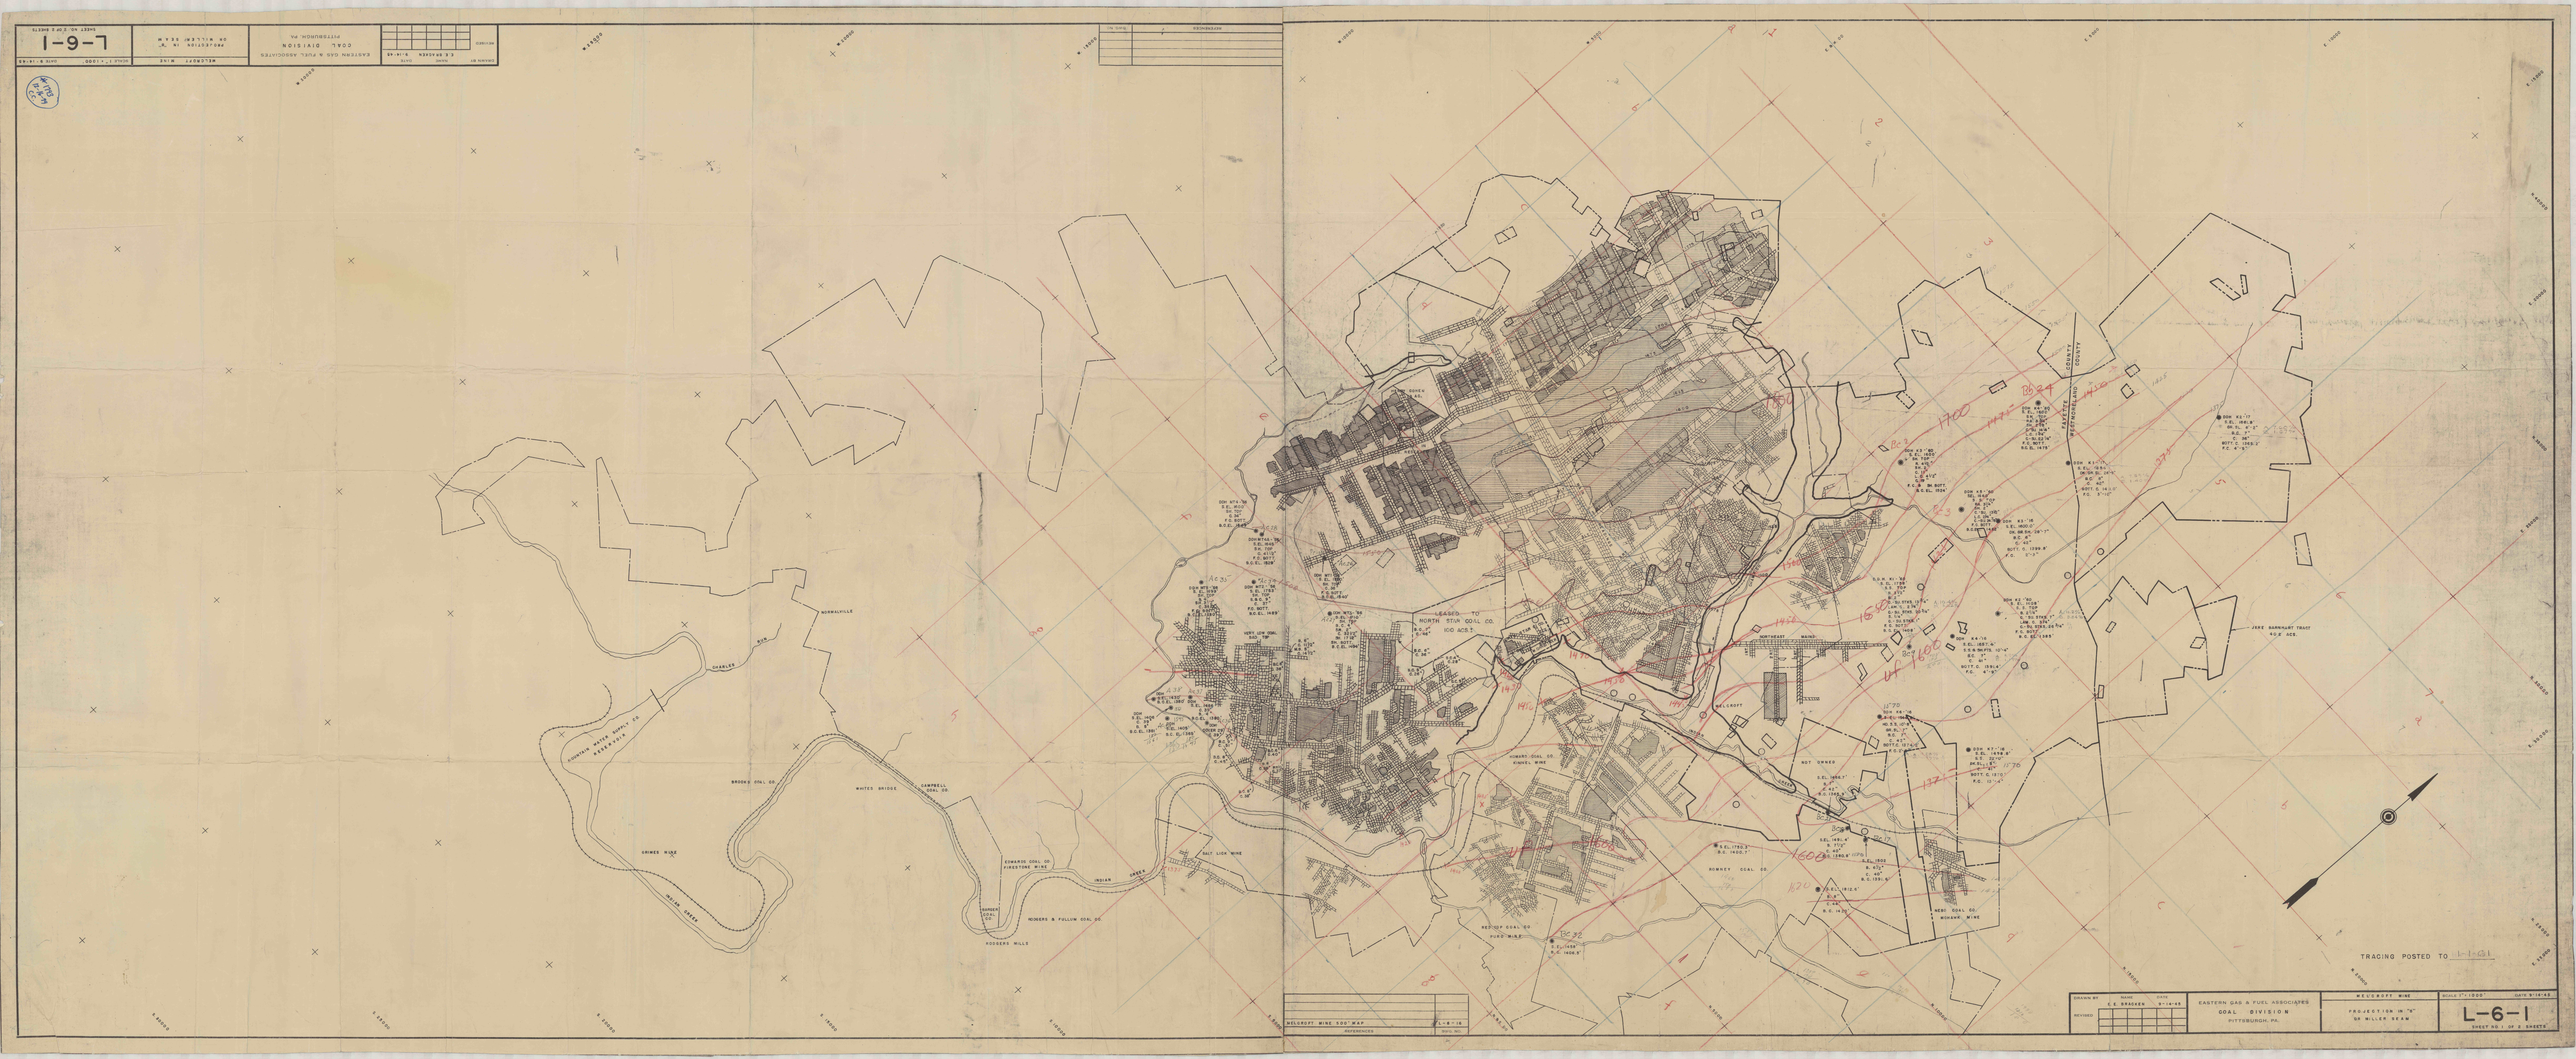
L-6-1
SHEET NO. 2 OF 2 SHEETS
MELCROFT MINE
PROJECTION IN "A" ON MILLER SEAM
EASTERN GAS & FUEL ASSOCIATES
COAL DIVISION
PITTSBURGH, PA.
DRAWN BY
E.E. BRADEN
9-14-48
REVISED
MELCROFT MINE 500' MAP
REFERENCES
L-6-1-16
DWG. NO.
SCALE 1" = 1200'
DATE 9-14-48
SHEET NO. / OF 2 SHEETS
TRACING POSTED TO
LEASED TO NORTH STAR COAL CO. 100 ACS.
NORTHEAST MAINS
MELCROFT
NOT OWNED
NEBC COAL CO. MOHAWK MINE
HUMBERT COAL CO.
EDMARCO COAL CO. KINNEL MINE
REDFORD COAL CO. PURE MINE
EDMARCO COAL CO. FIRESTONE MINE
ROGERS & PULLUM COAL CO.
ROGERS MILLS
SALT LICK MINE
INDIAN CREEK
WHITES BRIDGE
CAMPBELL COAL CO.
BROOKS COAL CO.
SHINER MINE
CHARLES
FAYETTE COUNTY
JESSE BARNHART TRACT 40.8 ACS.