


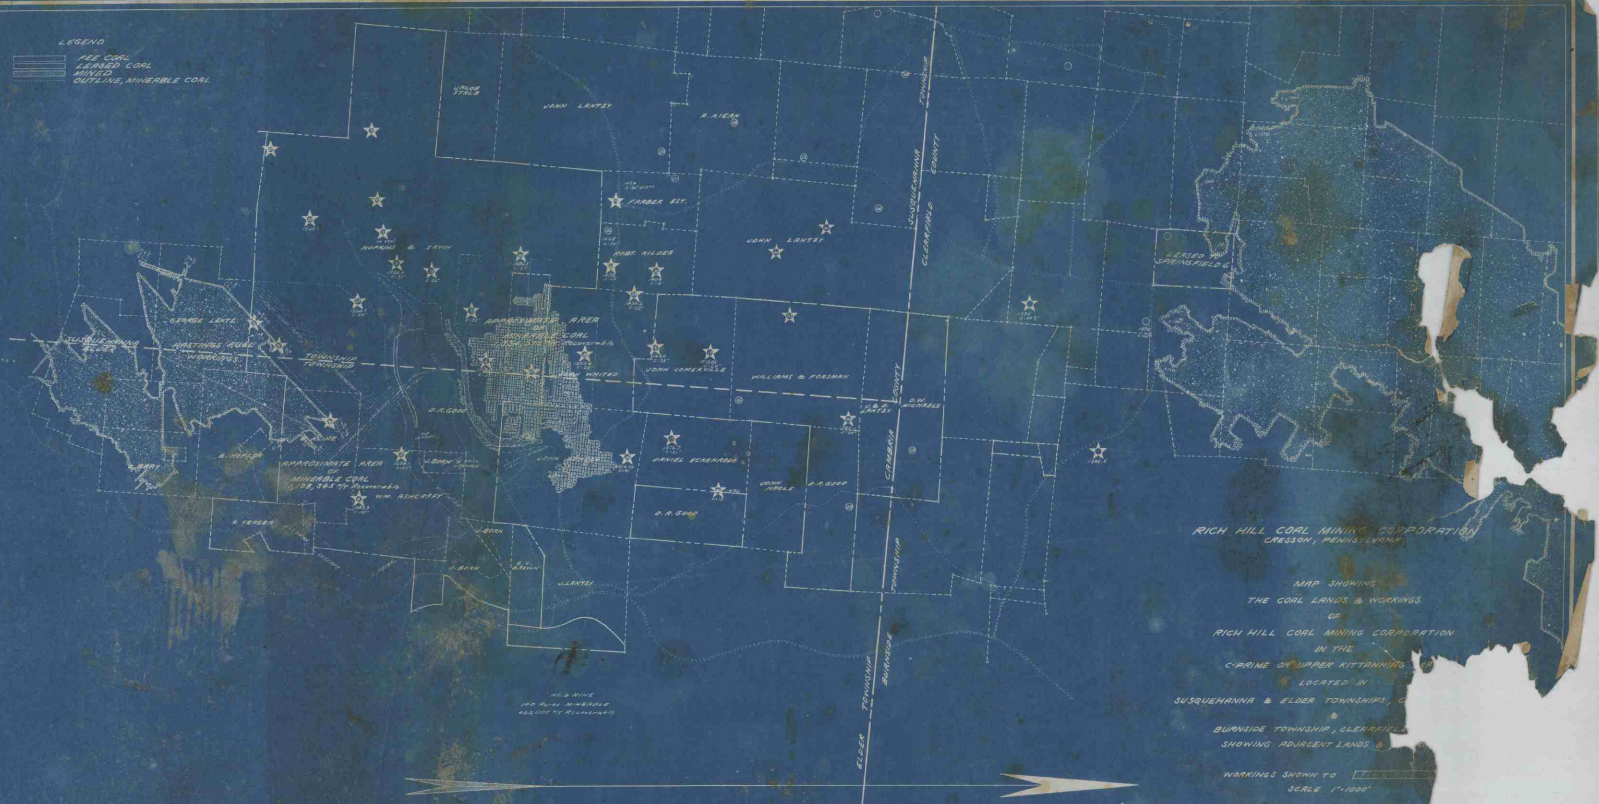

MAP SHOWING
THE COAL LANDS & WORKINGS
OF
RICH HILL COAL MINING CORPORATION
IN THE
LOCATED IN
JUSQUEHANNA & ELDER TOWNSHIPS, C
&
SHOWING ADJACENT LANDS &