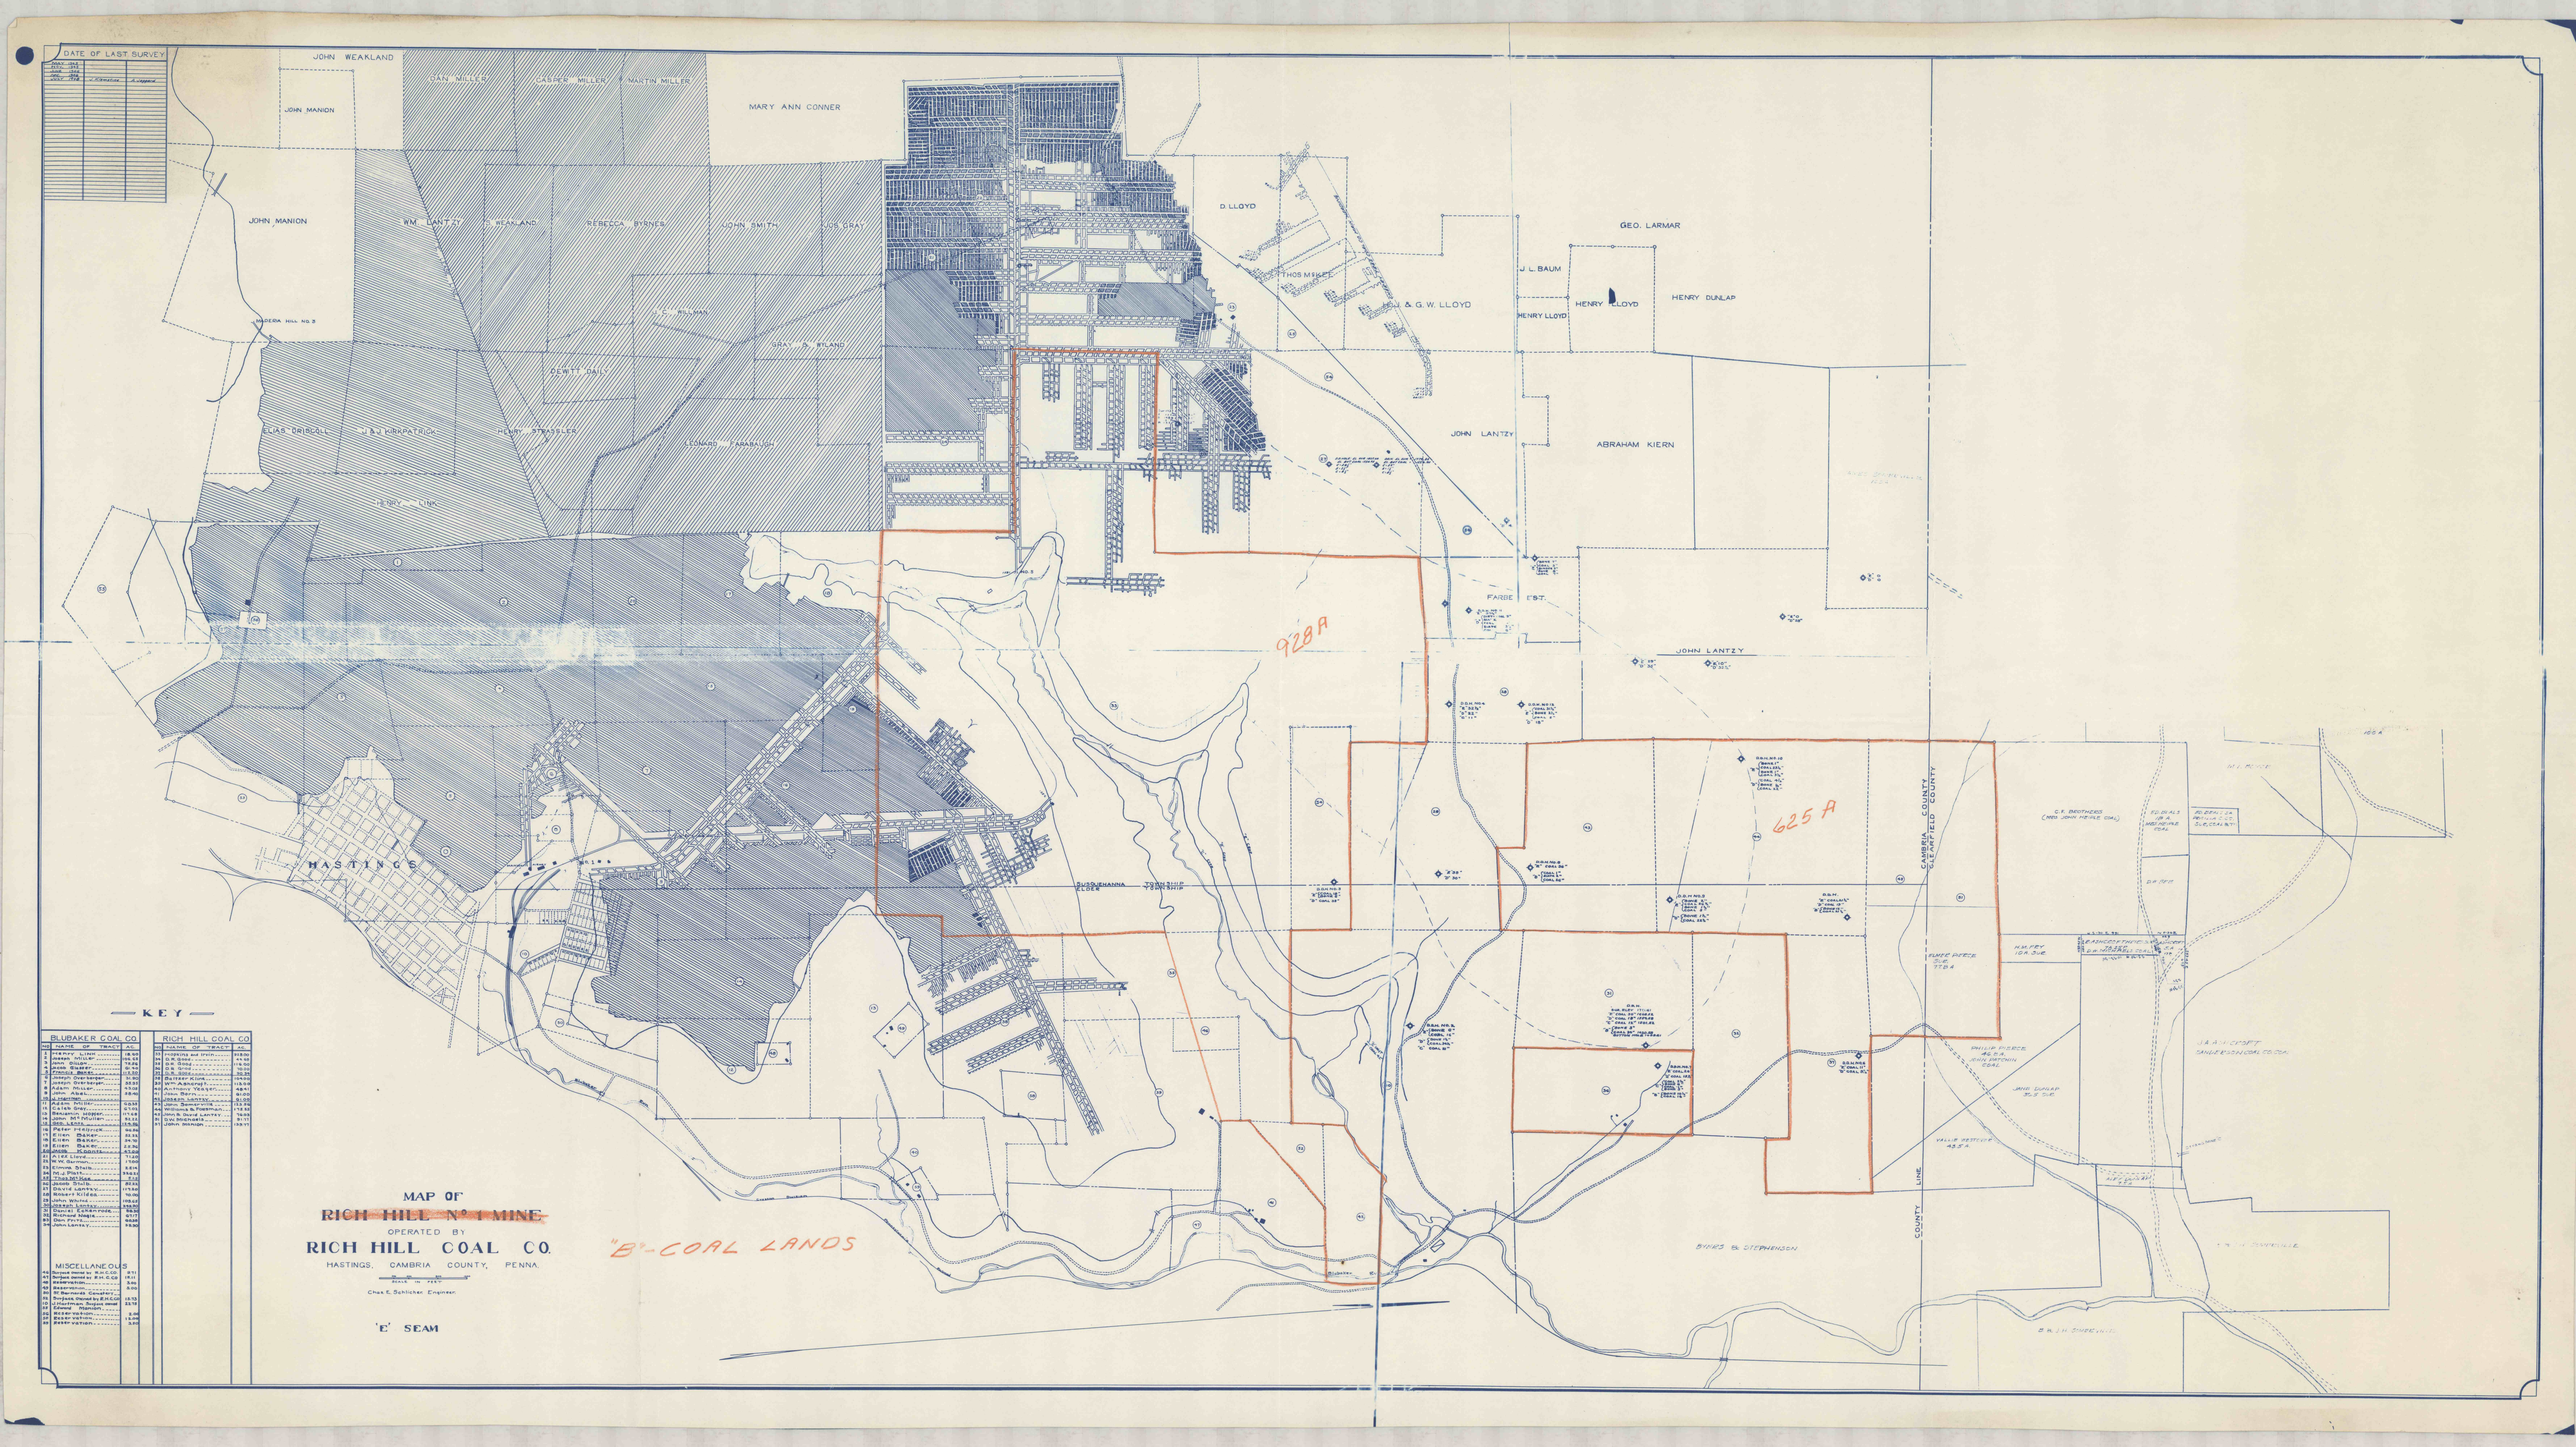
DATE OF LAST SURVEY
JOHN WEAKLAND
JOHN MANION
MARY ANN CONNER
D. LLOYD
THOS MERLE
GEO. LARMAR
J. L. BAUM
HENRY LLOYD
HENRY DUNLAP
JOHN LANTZY
ABRAHAM KIERN
FARBE EST.
928 A
625 A
HASTINGS
CAMBRIA COUNTY
CLEARFIELD COUNTY
COUNTY LINE
"B" COAL LANDS
KEY
BLUBAKER COAL CO
RICH HILL COAL CO
MISCELLANEOUS
MAP OF
RICH HILL No 1 MINE
OPERATED BY
RICH HILL COAL CO.
HASTINGS, CAMBRIA COUNTY, PENNA.
Chas. E. Schlicker, Engineer.
'E' SEAM