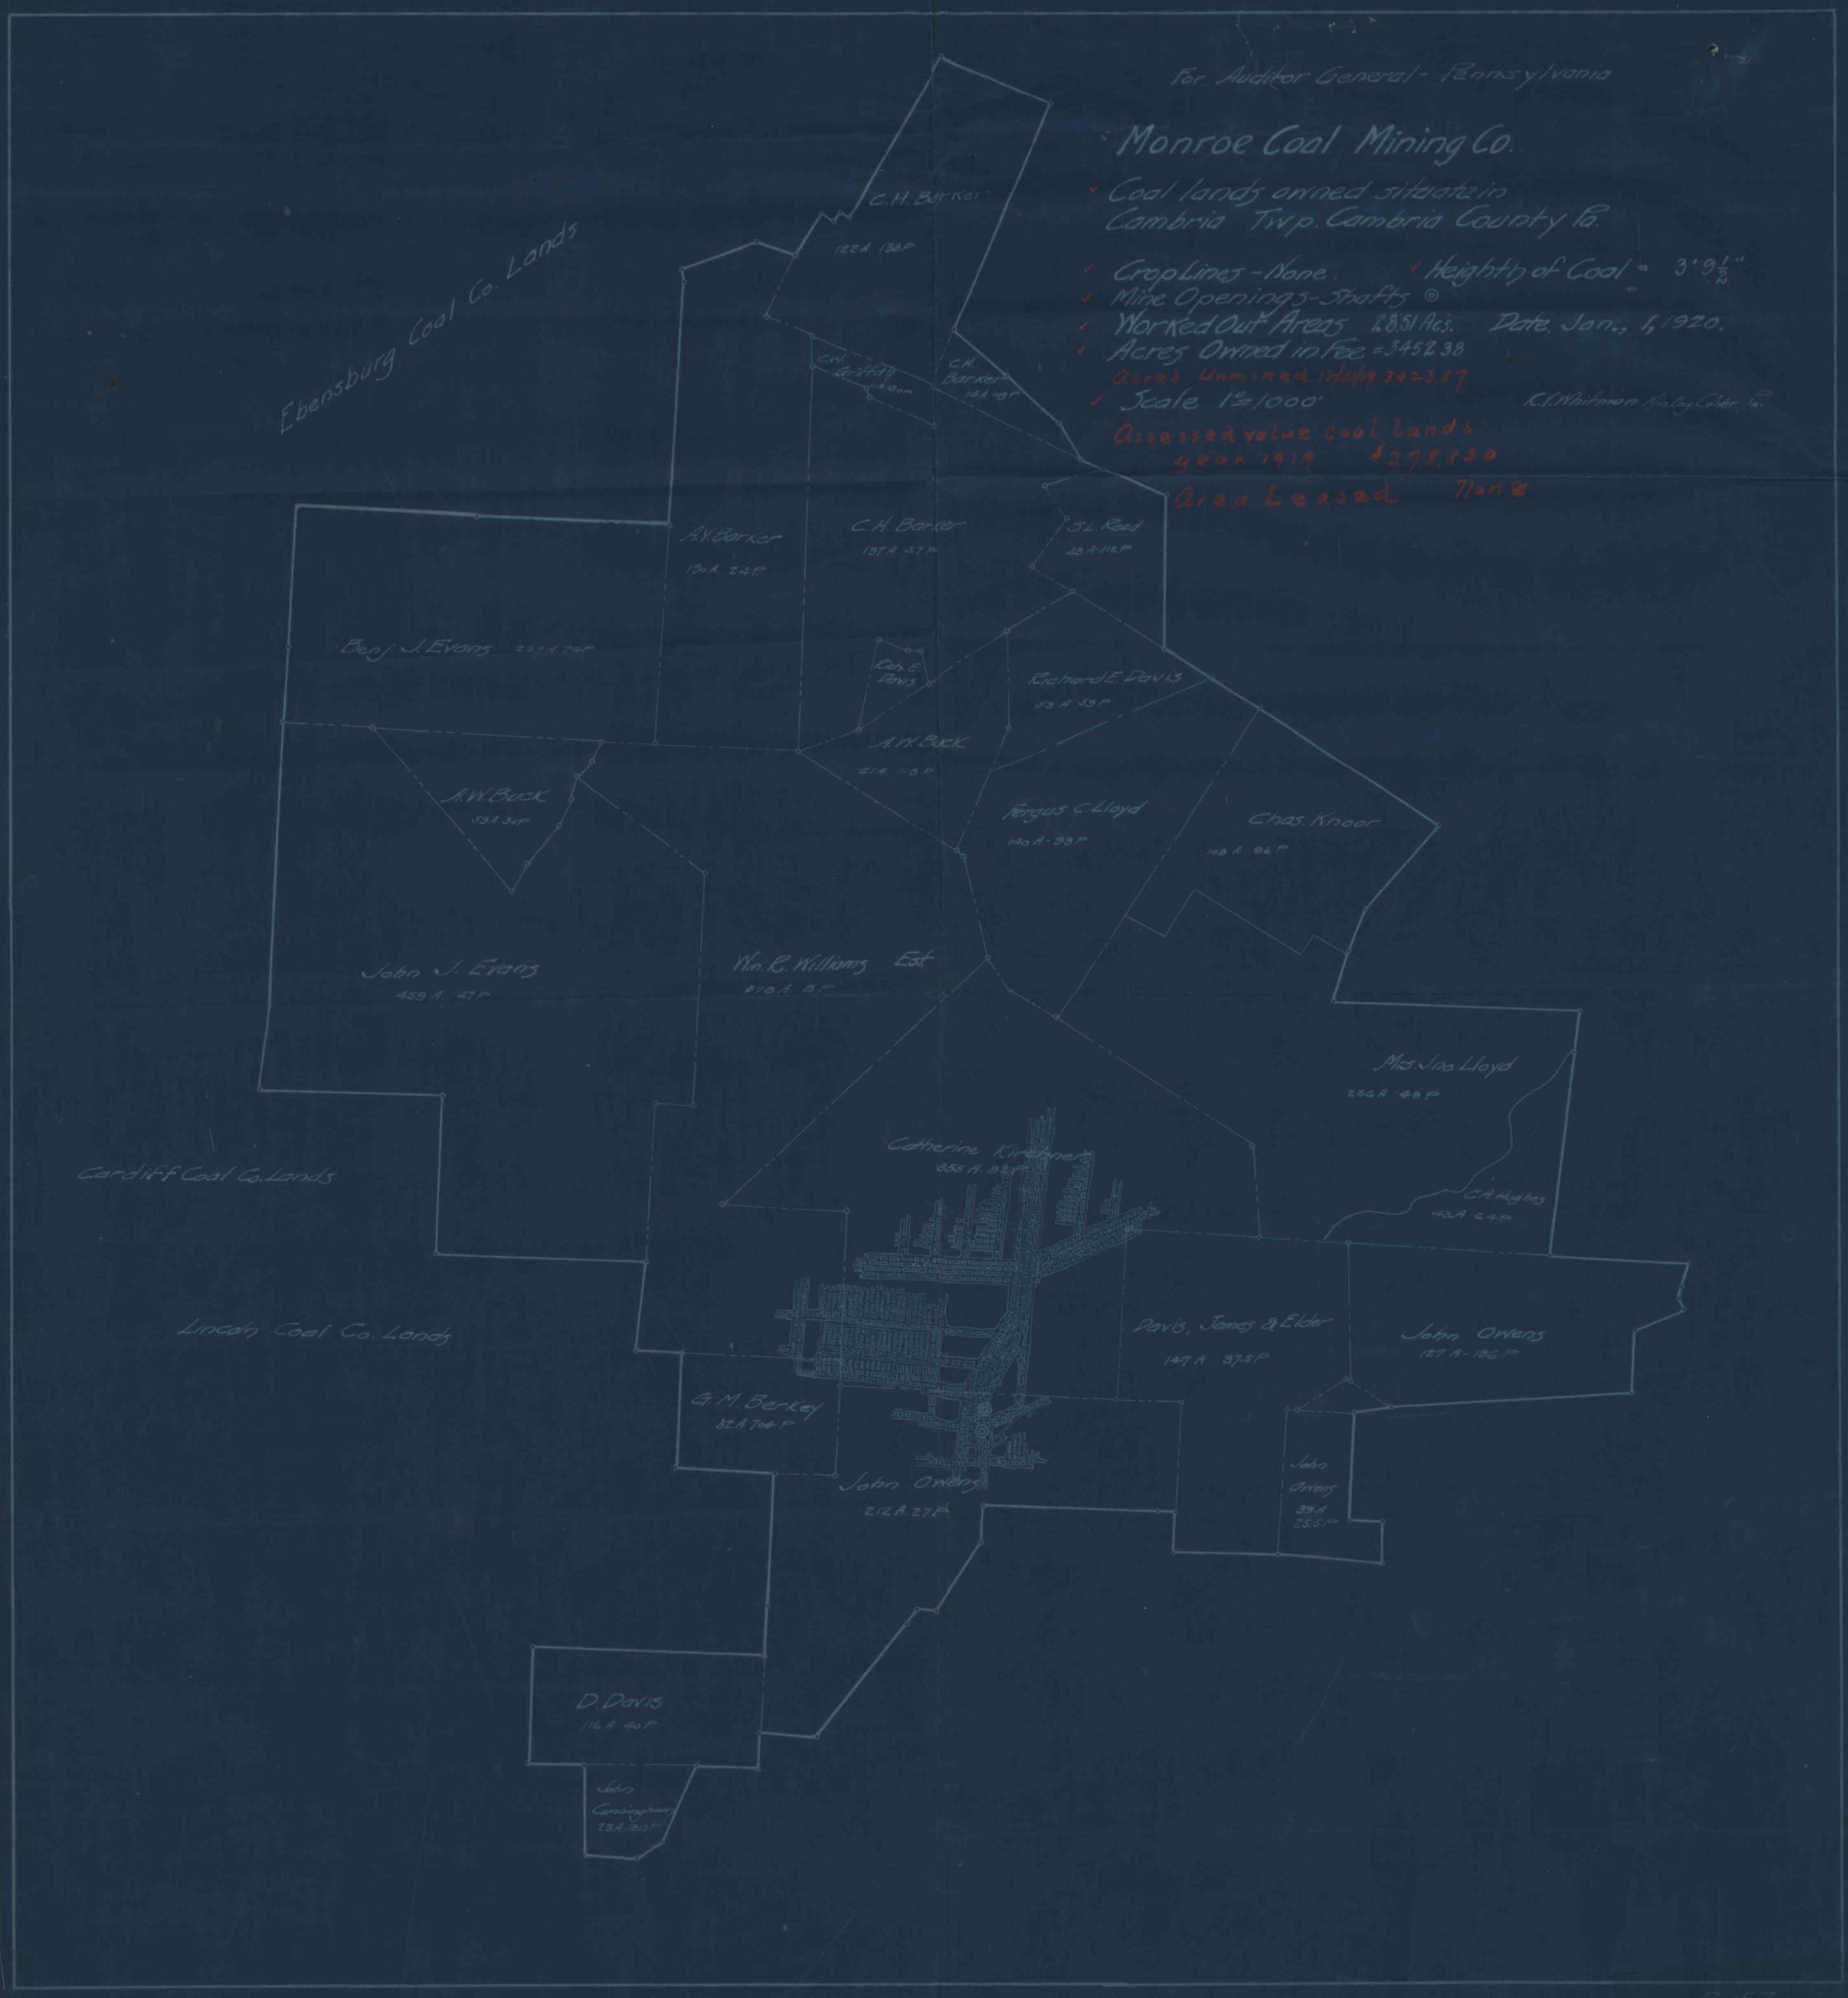
For Auditor General - Pennsylvania
Monroe Coal Mining Co.
Coal lands owned situate in Cambria Twp. Cambria County Pa.
Crop Lines - None.
Heighth of Coal = 3'9½"
Mine Openings - Shafts ◎
Worked Out Areas 28.51 Acs.
Date Jan., 1, 1920.
Acres Owned in Fee = 3452.38
Acres Unmined 17/30/19 3423.87
Scale 1" = 1000'
K.V. Whitman Min. Eng. Colder Pa.
Assessed value Coal Lands year 1919 $278,830
Area Leased None
Ebensburg Coal Co. Lands
C.H. Barker 122 A. 138 P
C.W. Griffith 11 A. 160 P
C.H. Barker 14 A. 149 P
A.V. Barker 130 A. 24 P
C.H. Barker 137 A. 57 P
S.L. Reed 43 A. 112 P
Benj. J. Evans 227 A. 74 P
Rich. E. Davis
Richard E. Davis 53 A. 59 P
A.W. Buck 61 A. 118 P
A.W. Buck 59 A. 30 P
Fergus C. Lloyd 140 A. 93 P
Chas. Knoor 108 A. 86 P
John J. Evans
Wm. R. Williams Est.
Mrs. Jno. Lloyd 256 A. 48 P
Cardiff Coal Co. Lands
Catherine Kirchner 355 A. 82 P
C.A. Hughes 43 A. 64 P
Lincoln Coal Co. Lands
Davis, James & Elder 147 A. 37.5 P
John Owens 127 A. 136 P
G.M. Berkey 82 A. 704 P
John Owens 212 A. 27 P
John Owens 39 A. 25.5 P
D. Davis 116 A. 40 P
John Cunningham 23 A. 131 P

B 157