


SHAWMUT MINING
 Lands of Shawmut Mining Company
 in
 Horton Twp. - Elk Co. Pa.
 Scale 1:10000

Number
 Date
 State
 Traced by
 Correct

- Lands Owned in Fee.
- " " Minerals.
- " " Surface.
- " Leased - None.

Lower Freeport Seam - 4' 0"
 Lower Kittanning Seam - 2' 8"
 5263 Acres in Fee - Assessed Valuation \$42,120.00

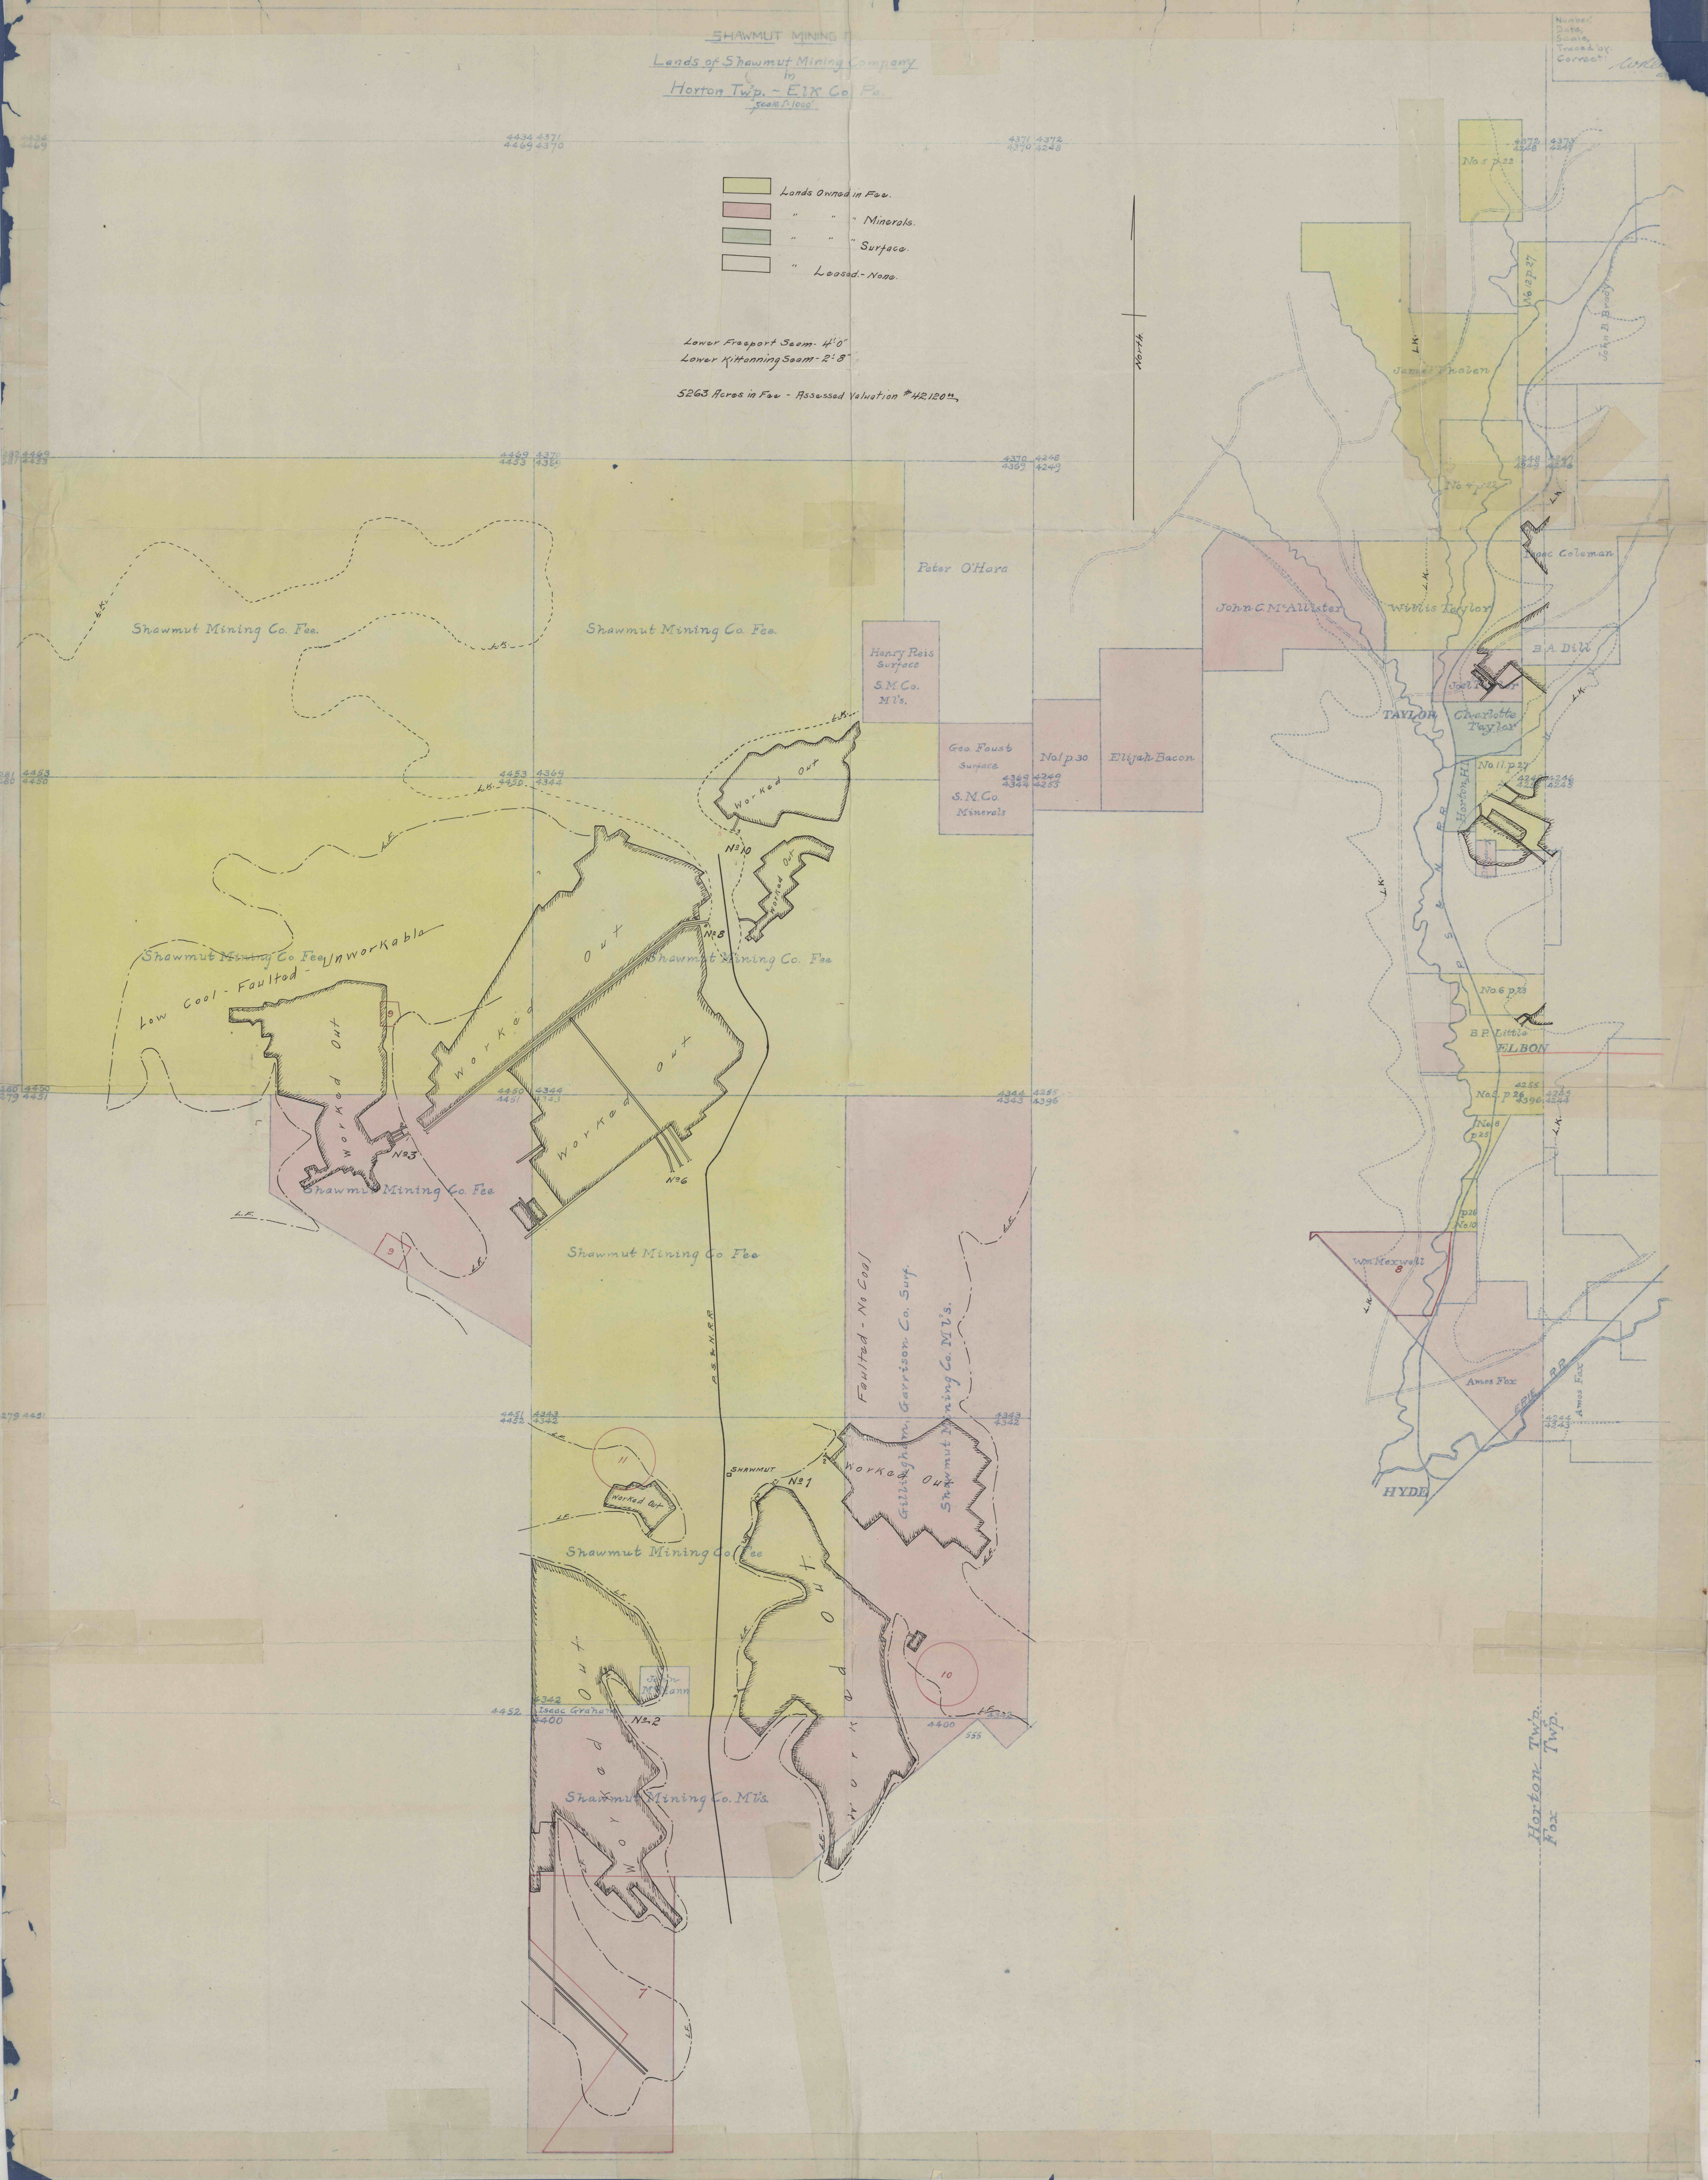

Horton Twp.
 Fox