


SHAWMUT MINING CO
 Lands of Shawmut Mining Company
 in
 Fox Twp. - Elk Co. Pa.
 Scale 1" = 1000'

Number, 403
 Date, June 12, 1900
 Scale, 1" = 1000'
 Traced by, P.G.
 Correct, Chief Engr.

- Lands Owned in Fee.
- " " " Minerals.
- " " " Surface-None.
- " Leased - None.

Lower Kittanning Seam. Average height 2.4'
 1671 Acres in Fee - Assessed Valuation \$194750

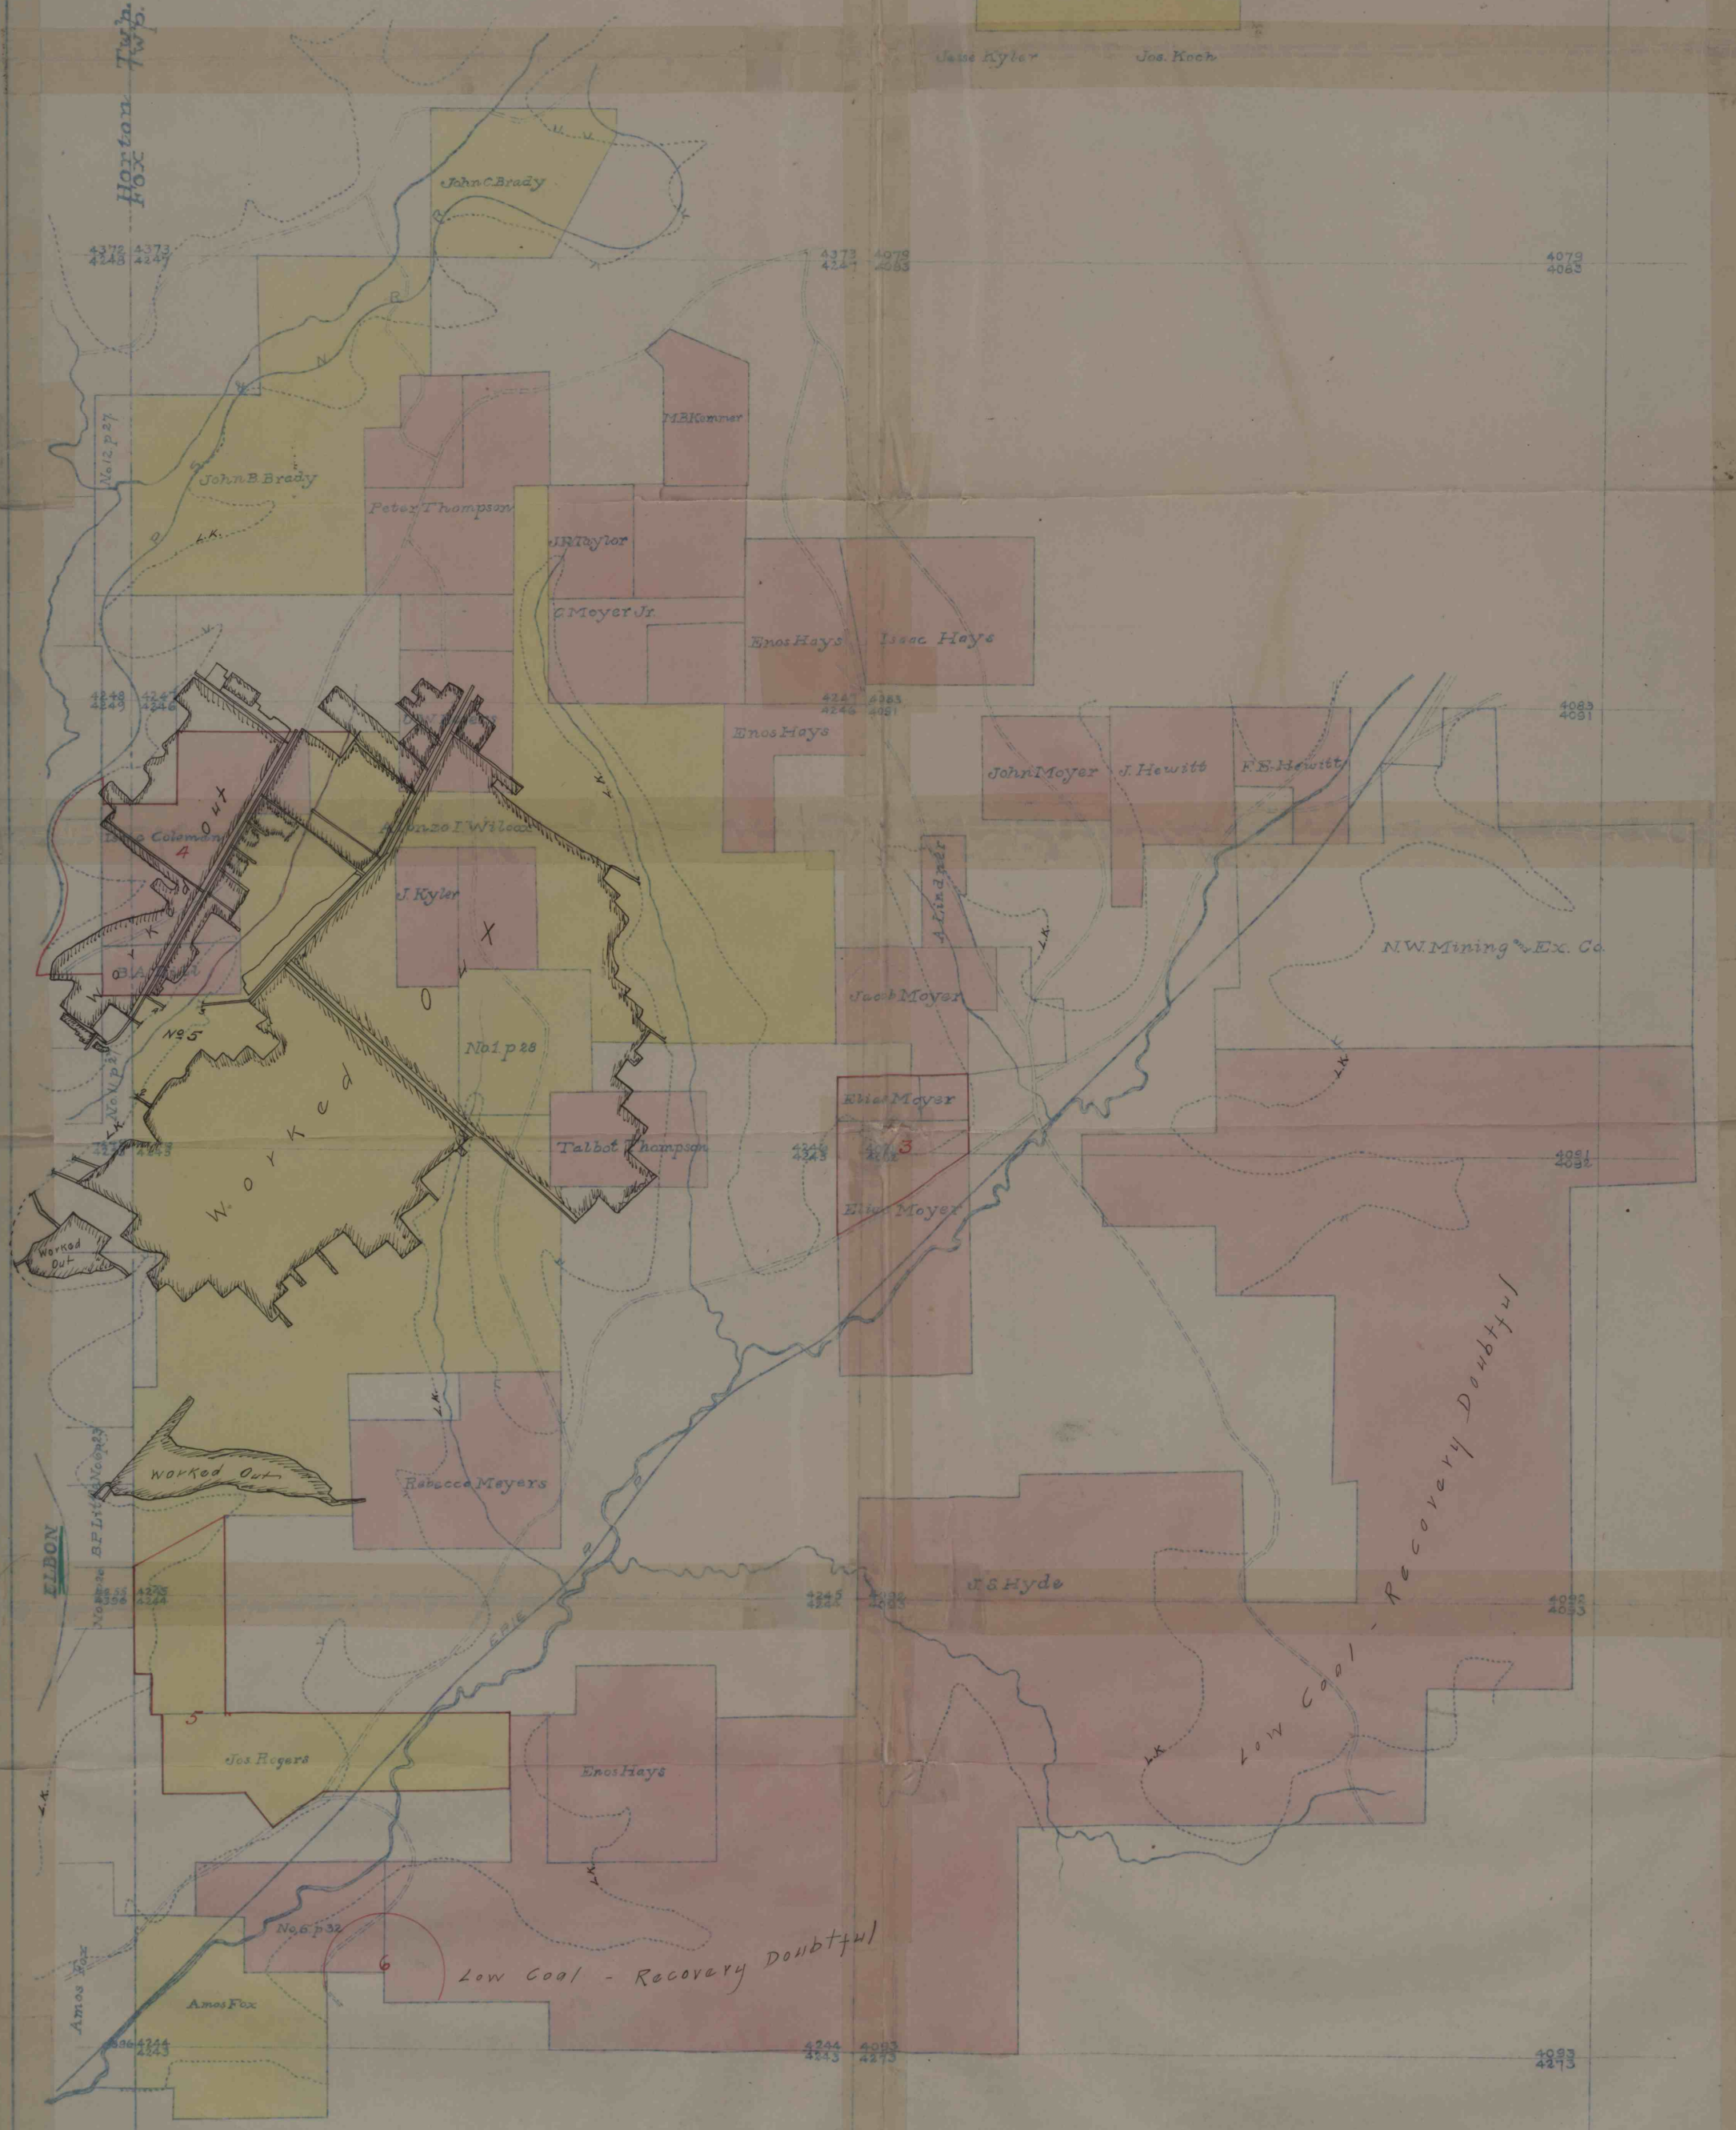

Horton Twp.

ELBON

Amos Fox