

ALLEGHENY RIVER

River

BRAEBURN MINE

THE YOUGHICGHENY

AND

OHIO COAL COMPANY

NEW KENSINGTON

LITTLE PUCKETA CREEK


KINLOCH MINE

WESTMORELAND COUNTY PUCKETA CREEK ALLEGHENY COUNTY

SPRINGDALE MINE WORKINGS

SITUATE IN ALLEGHENY AND WESTMORELAND COUNTIES PENNSYLVANIA

ALTMIRE BROS. COAL CO., INC.

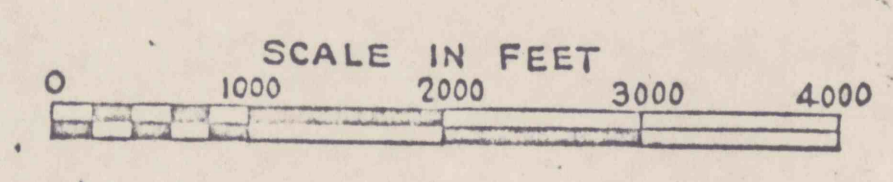

DATE: SEPTEMBER 30, 1968

PREPARED BY: RICHARD J. WALTER

