


RECEIVED
FEB 26 2003
Department of Environmental Protection
BUREAU OF MINES AND METALS

RECEIVED
MAR 13 2003
BUREAU OF MINES AND METALS

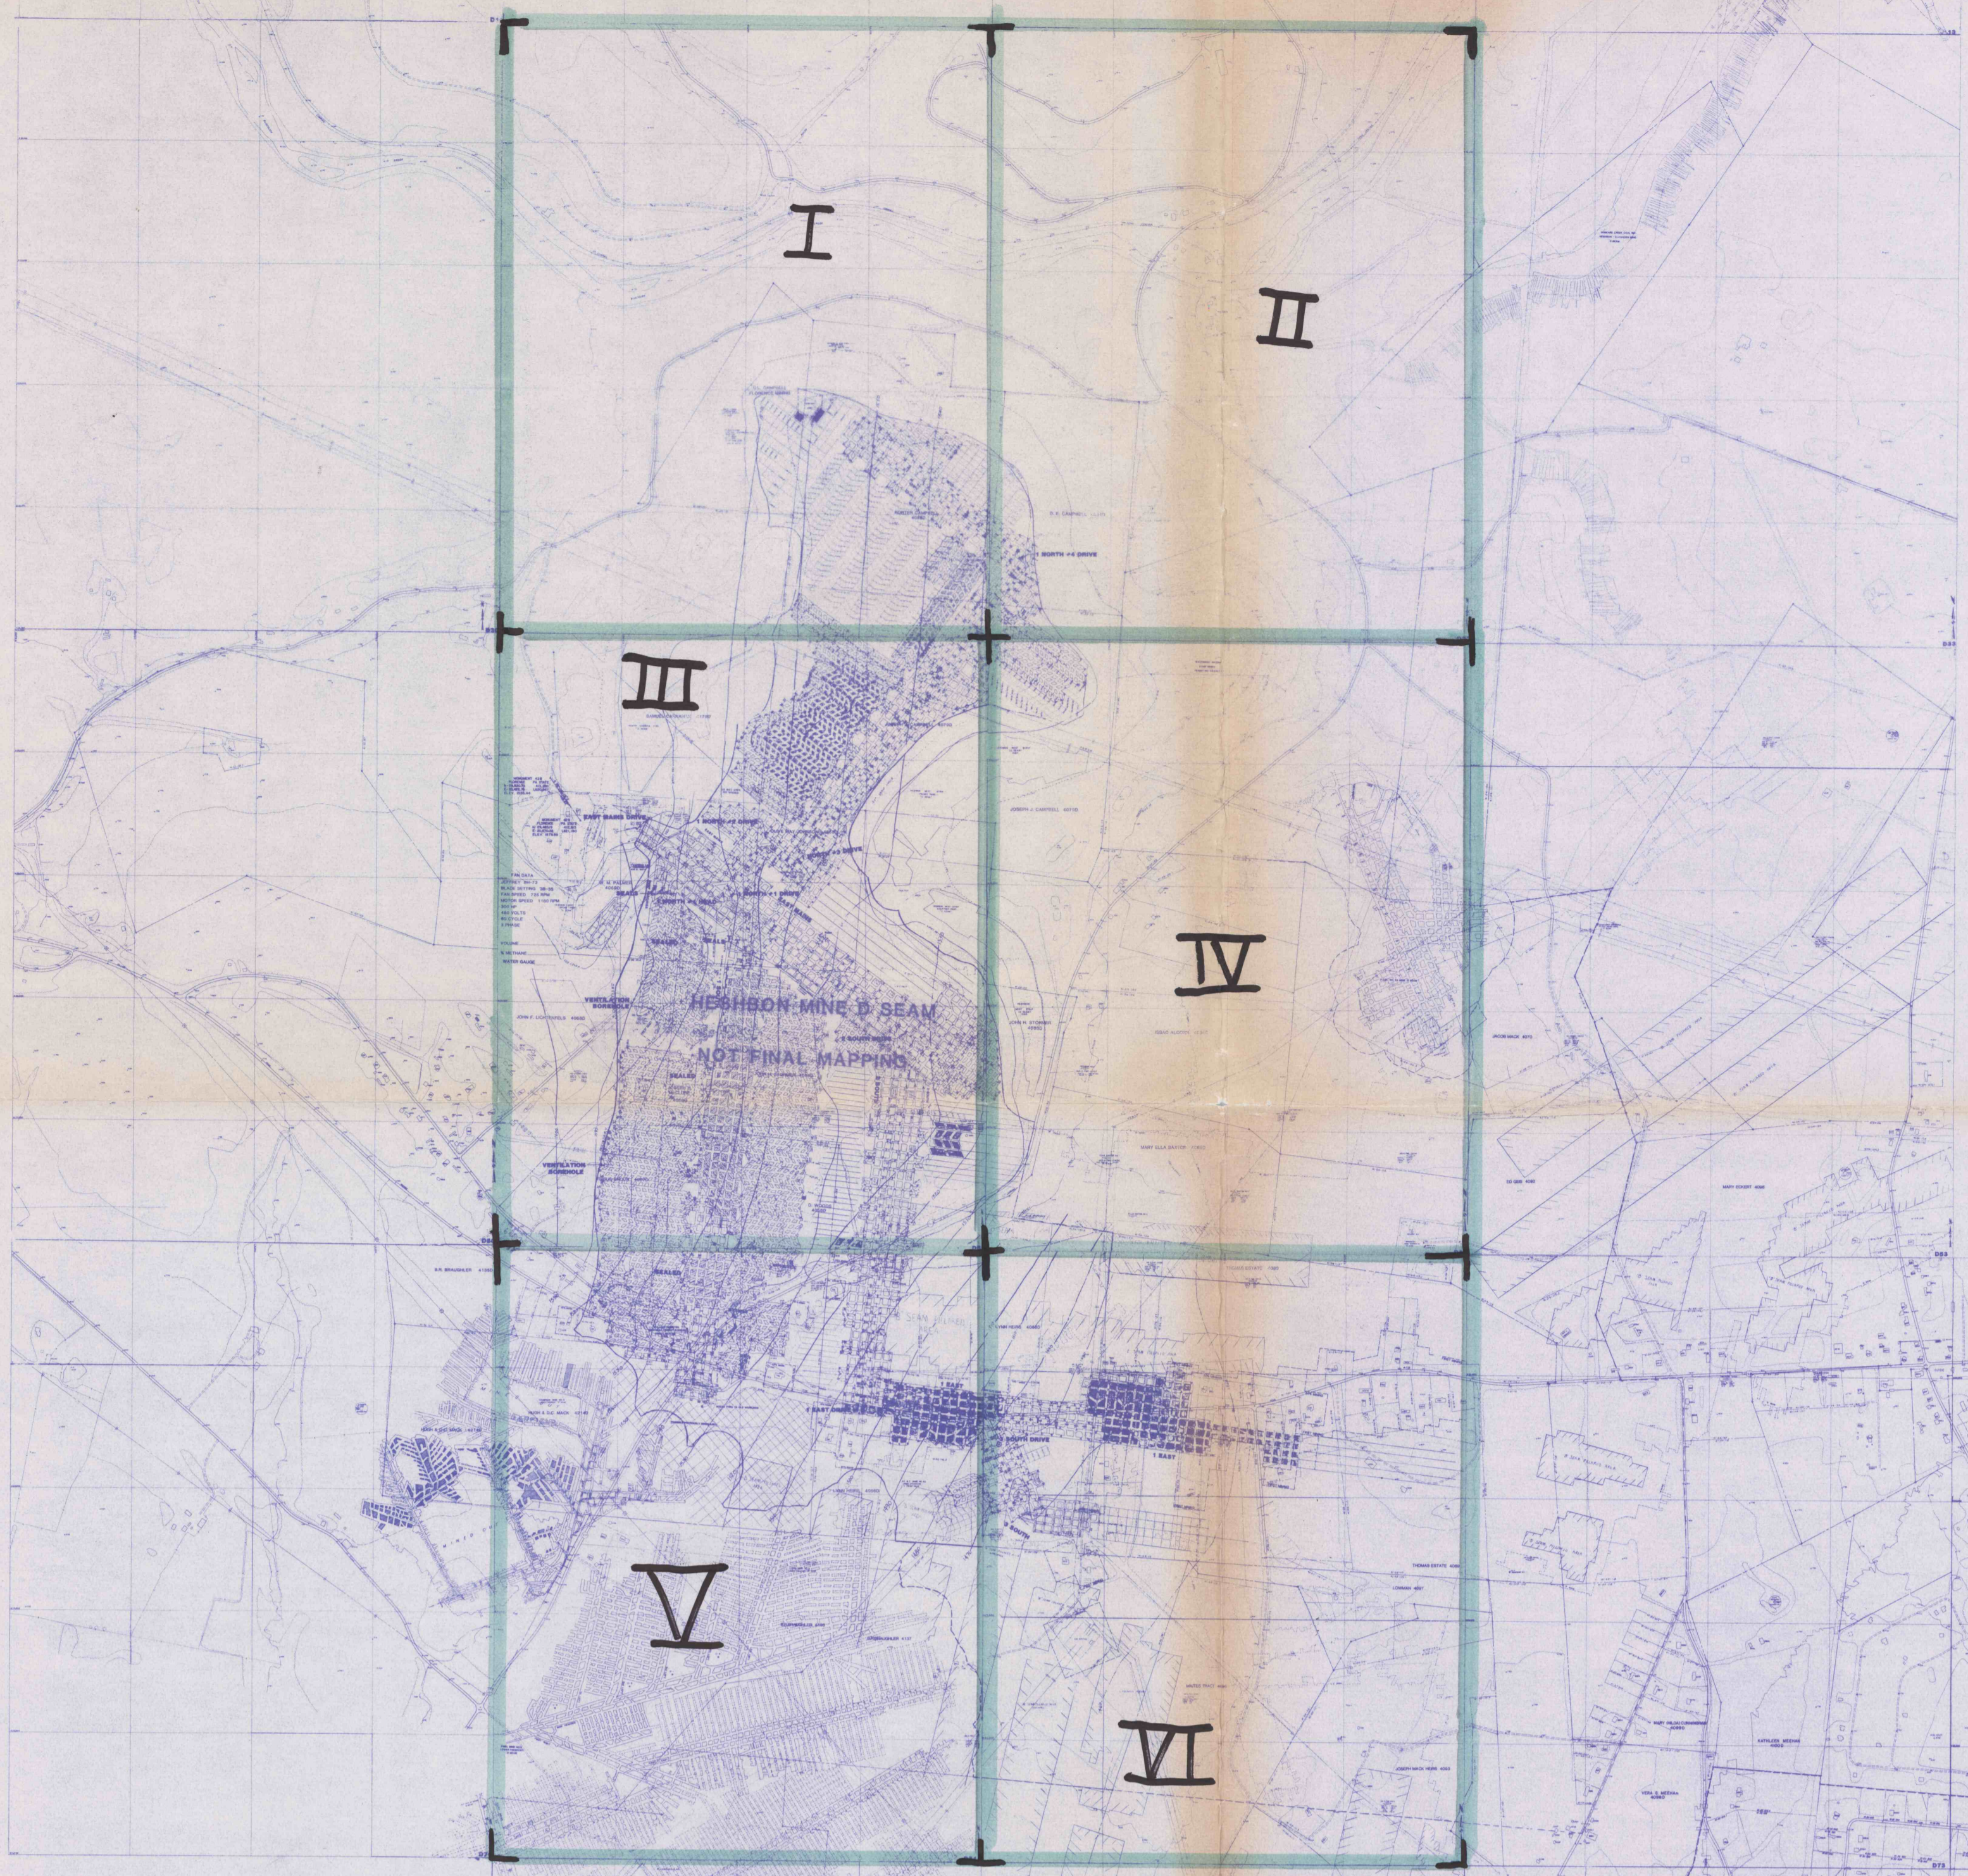

HEPBON MINE D SEAM
NOT FINAL MAPPING

NO. 2 D SEAM

FINAL MINE MAP FLORENCE NO. 2 E & D SEAMS
1in : 1000ft

NO. 2 E SEAM

POSTED 7/31/92