


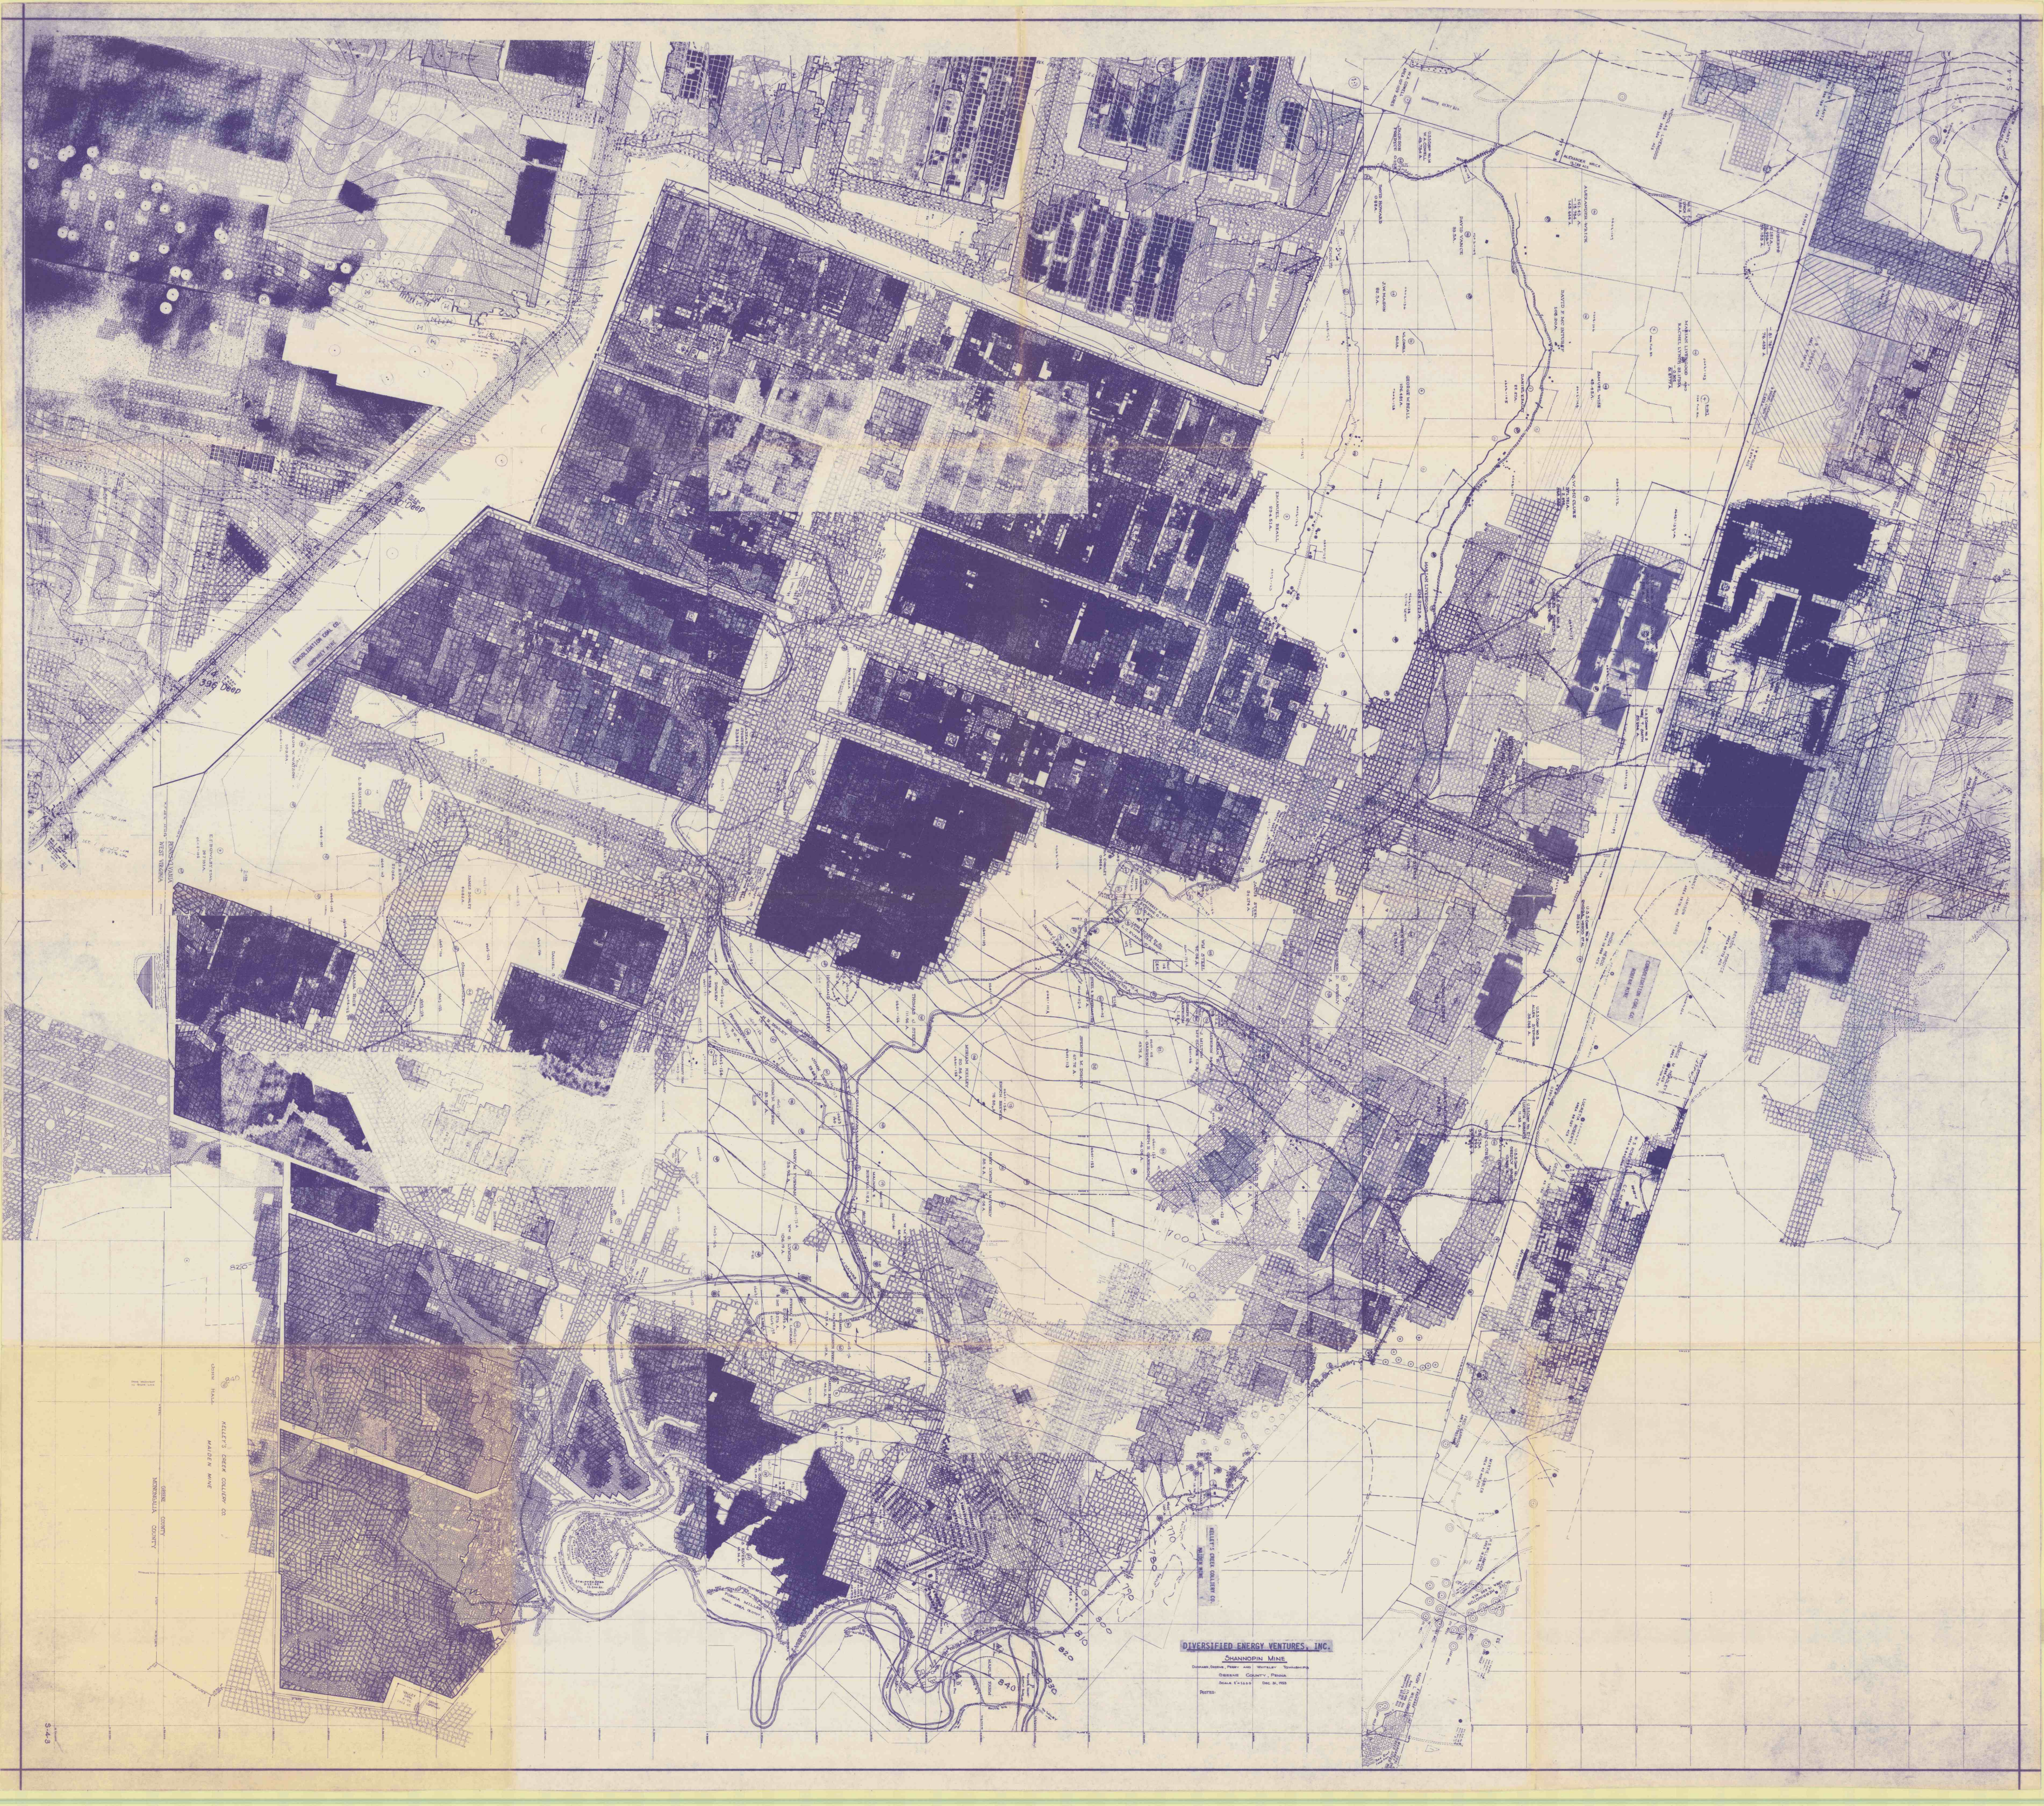

DIVERSIFIED ENERGY VENTURES, INC.

