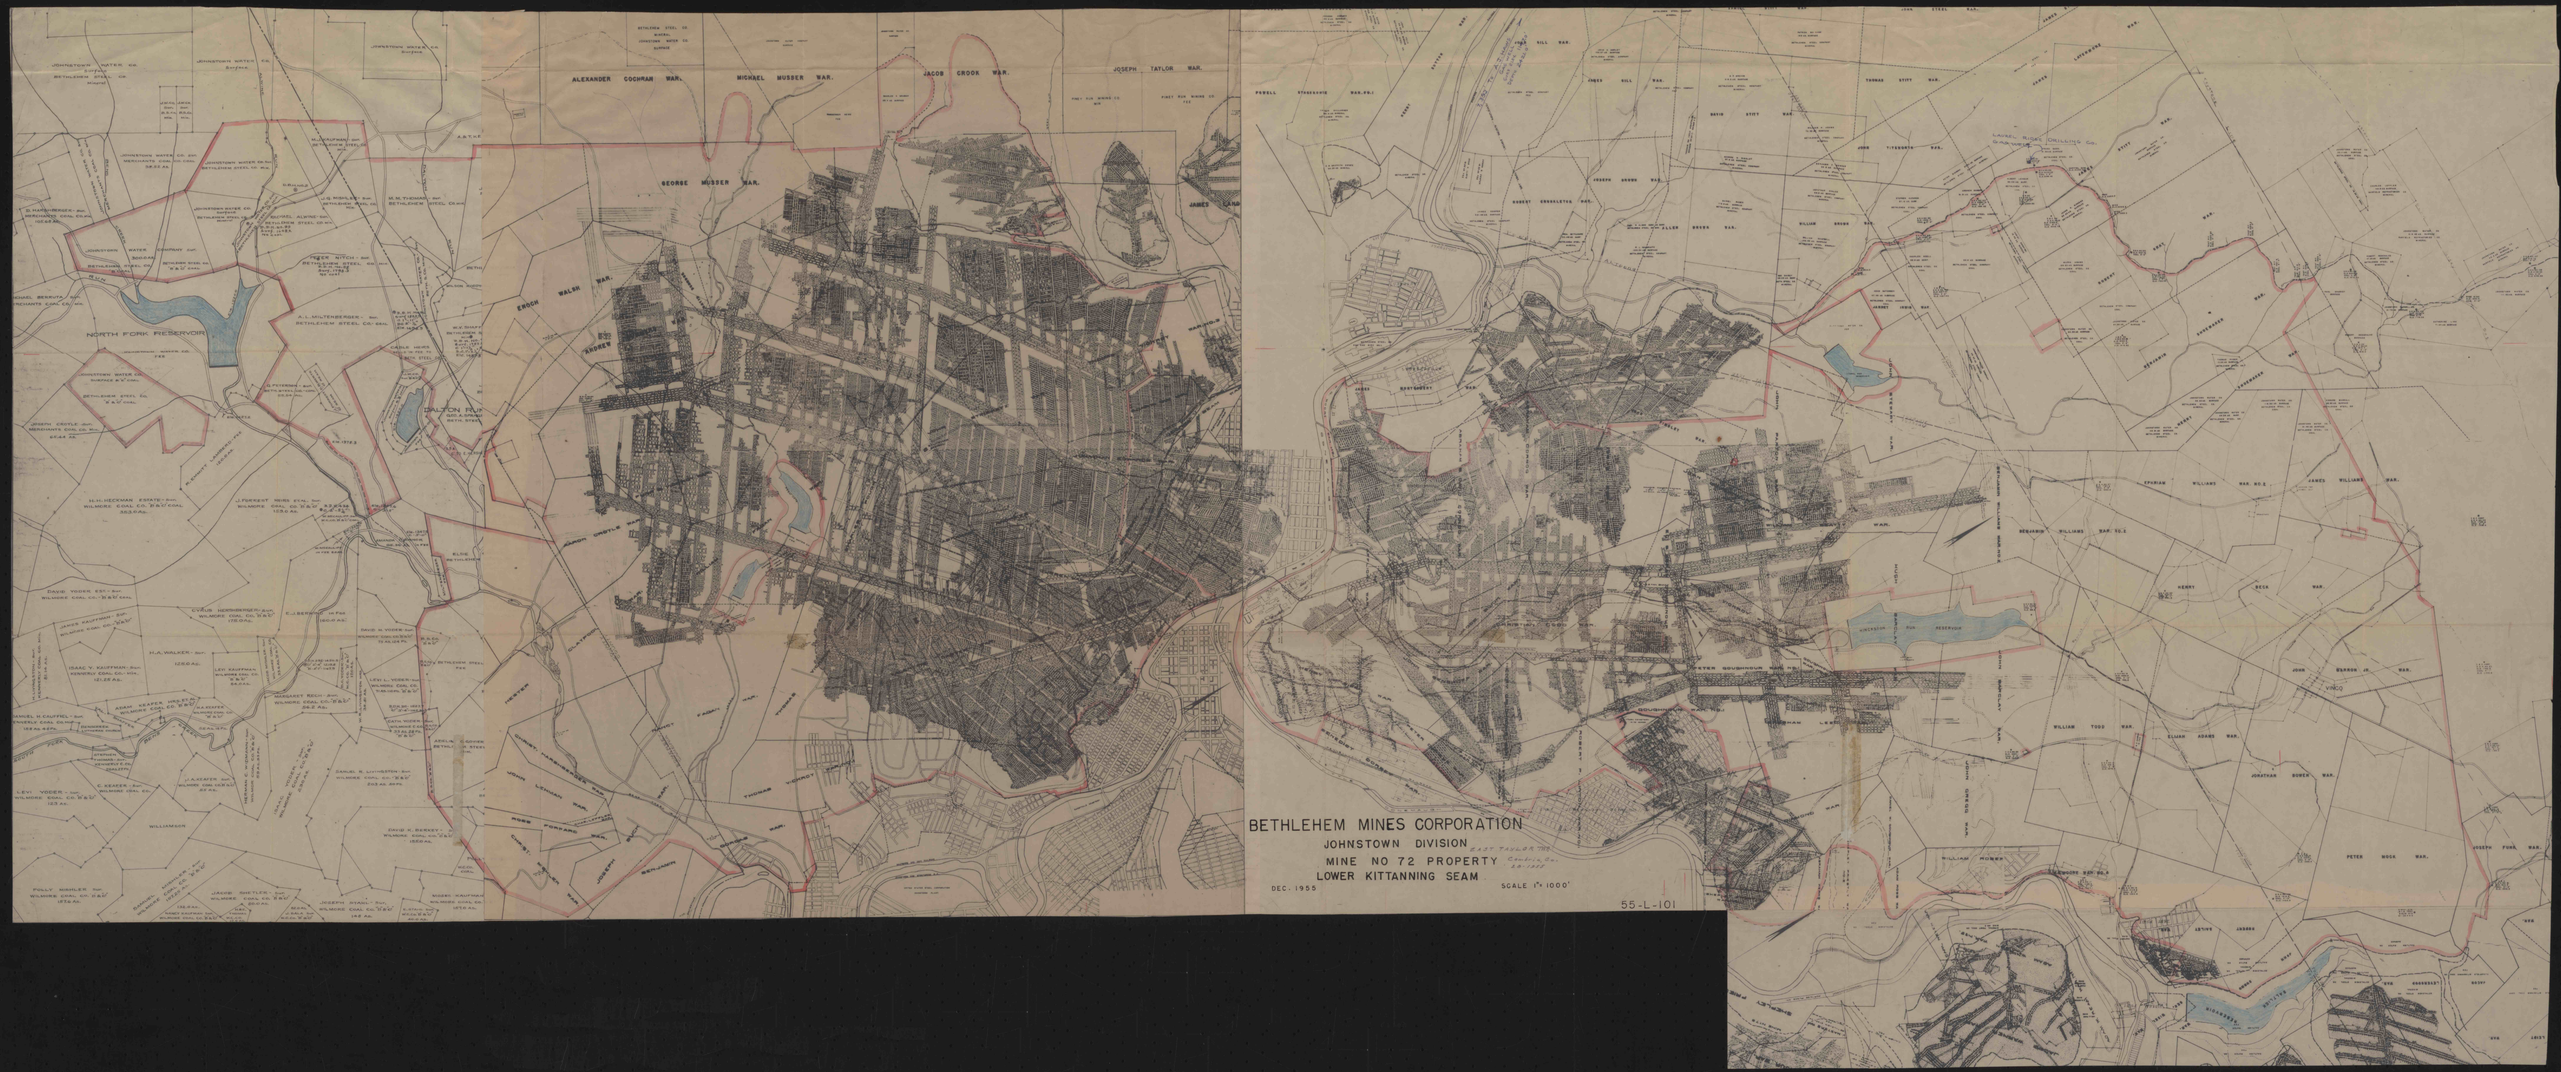
BETHLEHEM MINES CORPORATION
JOHNSTOWN DIVISION
MINE NO 72 PROPERTY
LOWER KITTANNING SEAM
DEC. 1955
SCALE 1"= 1000'
55-L-101
NORTH FORK RESERVOIR
DALTON RUN
ALEXANDER COCHRAN WAR.
MICHAEL MUSSER WAR.
JACOB CROOK WAR.
JOSEPH TAYLOR WAR.
GEORGE MUSSER WAR.
JOHN WALSH WAR.
ANDREW
JOHN LEMMON WAR.
JOHN CRYDER WAR.
JOHN TODD WAR.
WILLIAM TODD WAR.
ELIJAH ADAMS WAR.
JONATHAN BURKE WAR.
PETER HOGE WAR.
JOSEPH FORE WAR.
JOHN BARRON JR. WAR.
HENRY BECK WAR.
SPURGIN WILLIAMS WAR. NO. 2
JAMES WILLIAMS WAR.
RICHARD WILLIAMS WAR. NO. 1
WILLIAM ROWES
JOHNSTOWN WATER CO.
BETHLEHEM STEEL CO.
JOHNSTOWN WATER CO. ETC.
MERCHANTS COAL CO. ETC.
JOHNSTOWN WATER CO. ETC.
BETHLEHEM STEEL CO.
JOHNSTOWN WATER CO