




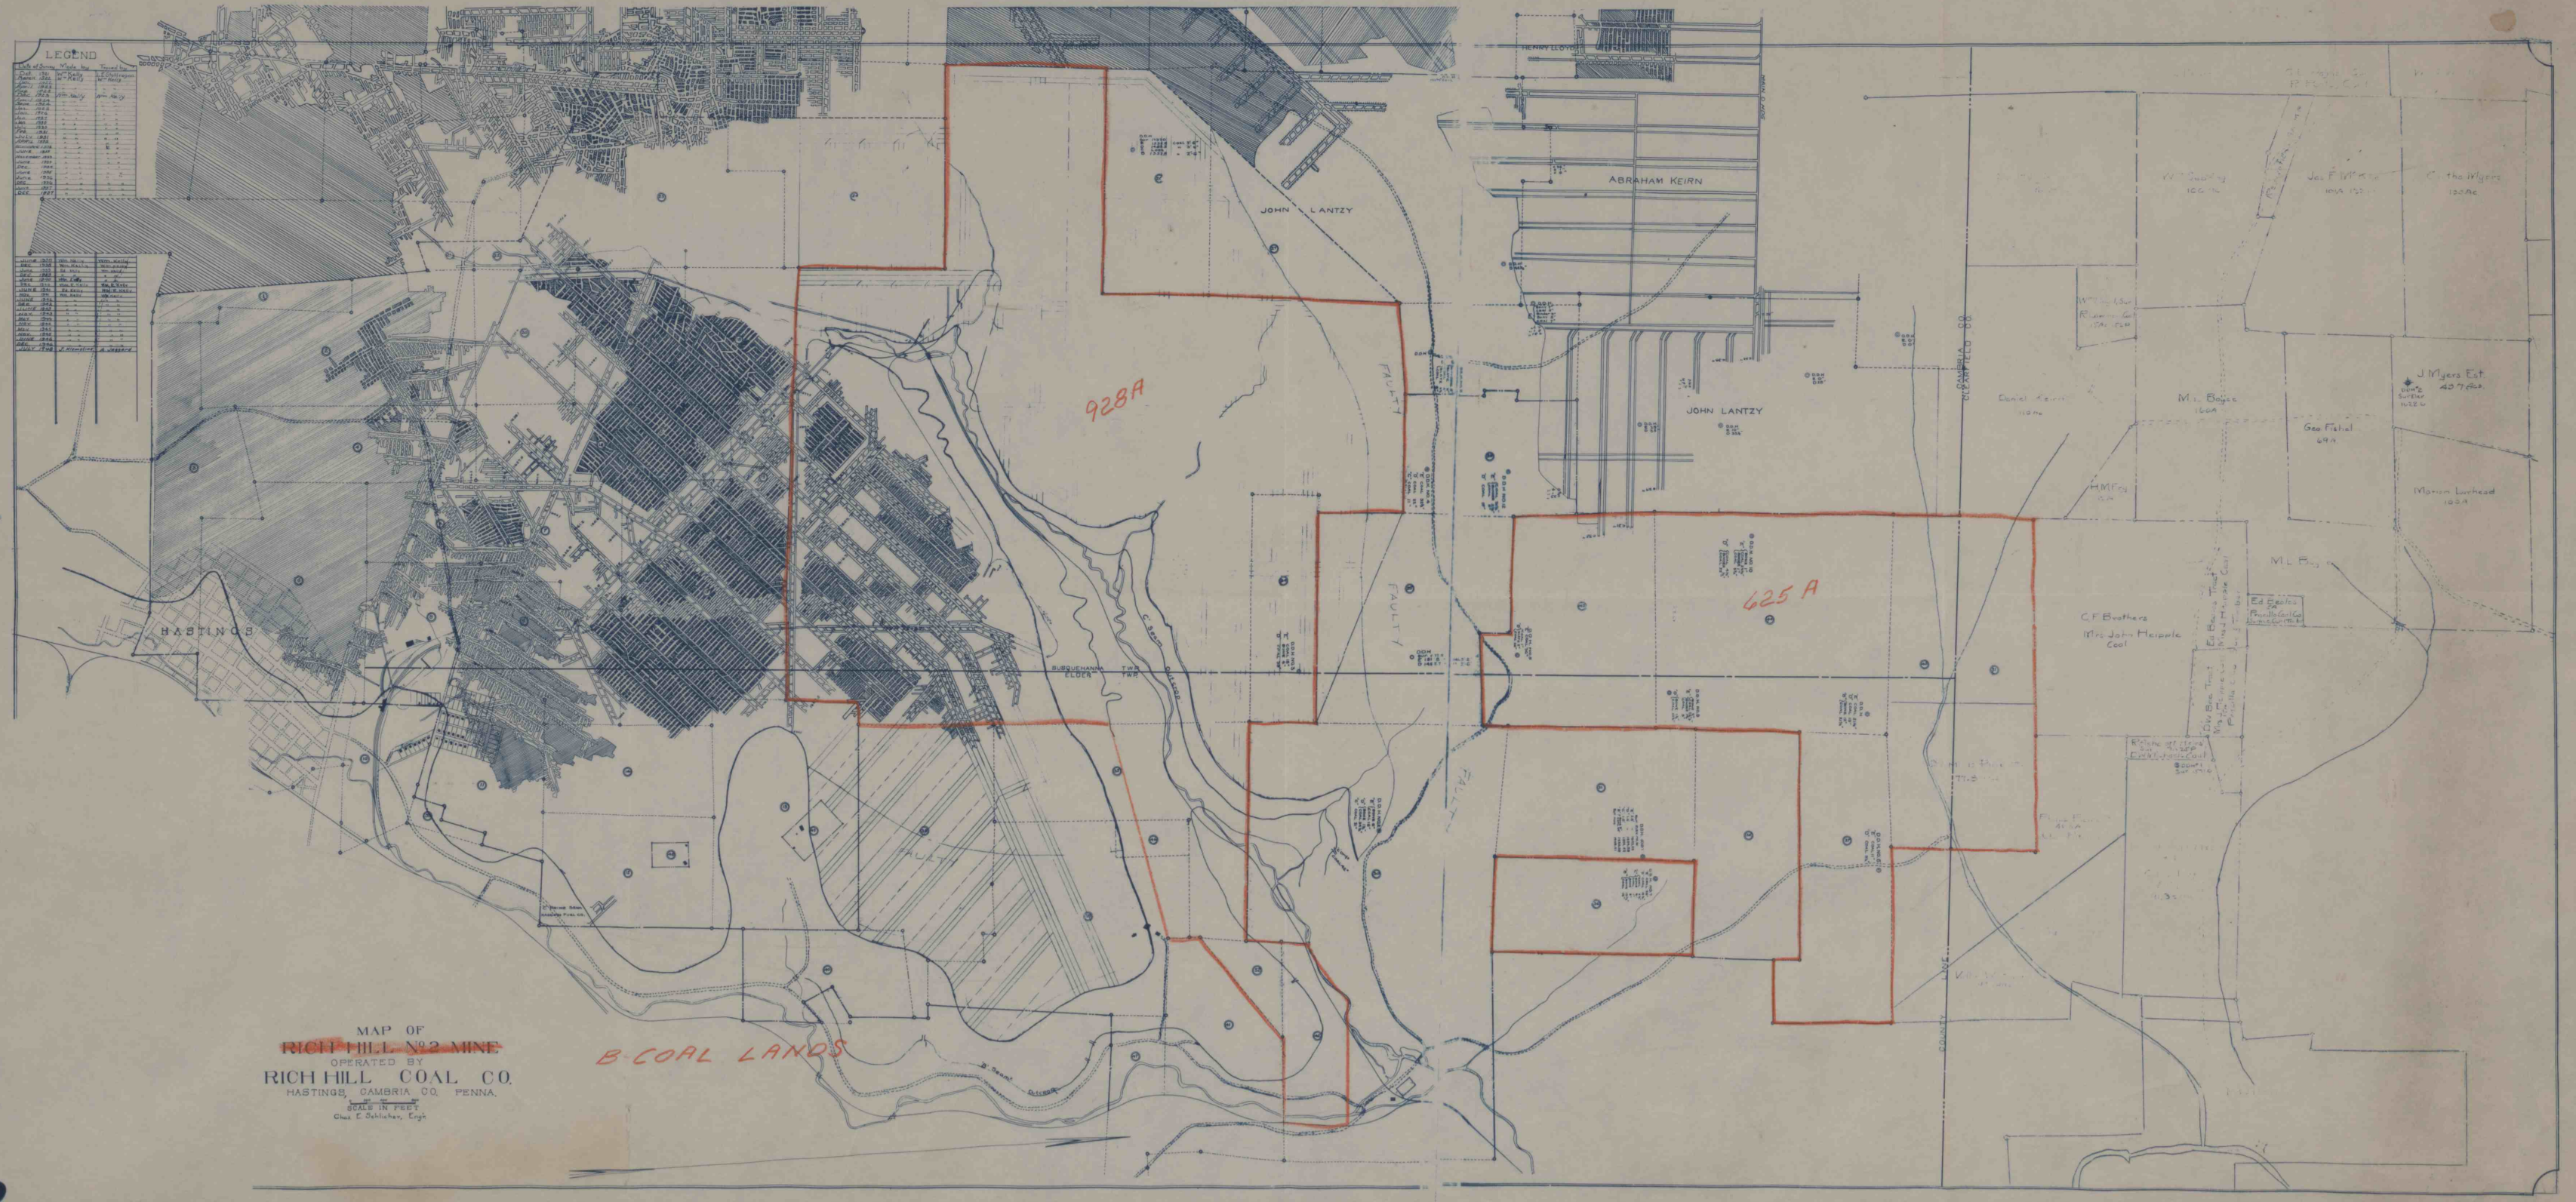

MAP OF
RICH HILL No. 2 MINE
 OPERATED BY
RICH HILL COAL CO.
 HASTINGS, CAMBRIA CO. PENNA.
 SCALE IN FEET
 Chas. E. Schlicher, Eng.

B COAL LANDS

928A

625A

JOHN LANTZY

ABRAHAM KEIRN

JOHN LANTZY

HASTINGS

BURREHAM

C.F. Brothers

Mrs. John Hepple

Coal

M.L.B.

M.L. Boyce

Geo. Fisher

J. Myers Est.

W. T. Duffing

Jas. F. McKee

Chas. Myers

CLEARFIELD ST

COUNTY ST

FAULT

FAULT

FAULT

FAULT




