



ALLEGHENY - PITTSBURGH COAL CO.
 SPRINGDALE MINE

HARMAR COAL CO
 OAKMONT MINE

REPUBLIC STEEL CORP.
 NEWFIELD MINE

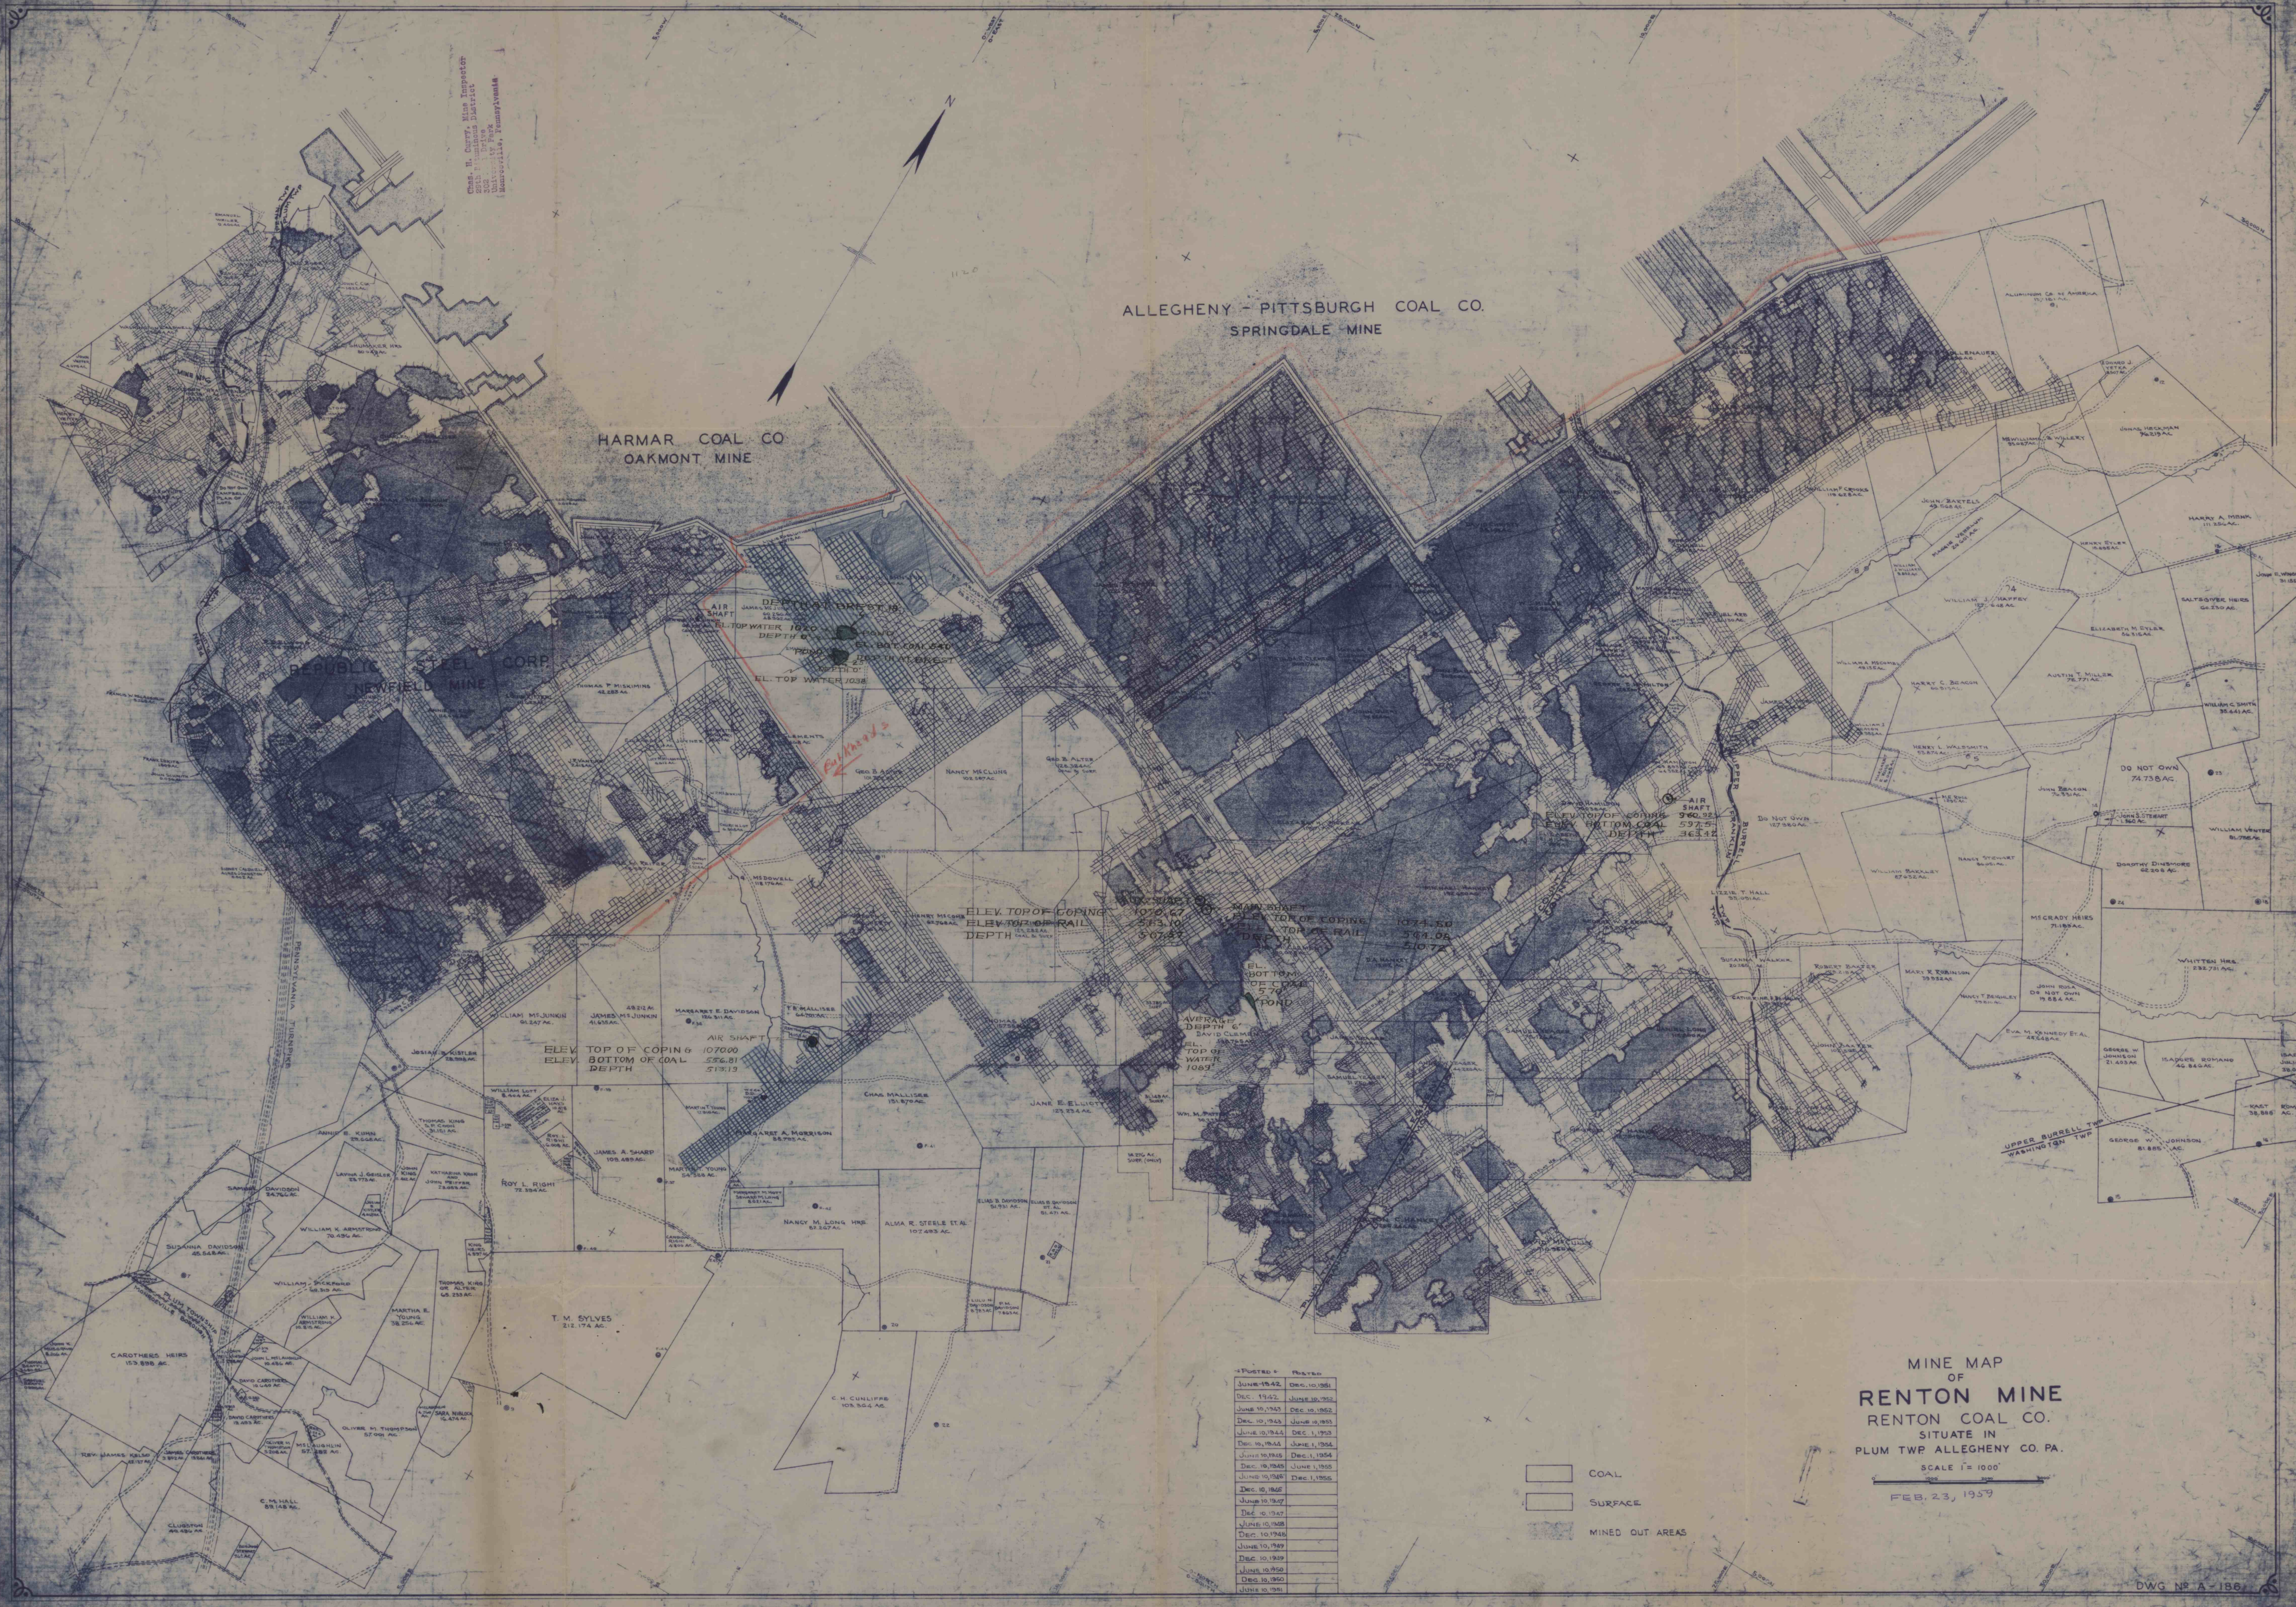

POSTED	REVISED
JUNE 1942	DEC. 10 1951
DEC. 1942	JUNE 10 1952
JUNE 1943	DEC. 10 1953
DEC. 10 1943	JUNE 10 1954
JUNE 1944	DEC. 1 1954
DEC. 1944	JUNE 1 1955
JUNE 1945	DEC. 1 1955
DEC. 1945	
JUNE 1946	
DEC. 1946	
JUNE 1947	
DEC. 1947	
JUNE 1948	
DEC. 1948	
JUNE 1949	
DEC. 1949	
JUNE 1950	
DEC. 1950	
JUNE 1951	

- COAL
- SURFACE
- MINED OUT AREAS

MINE MAP
 OF
RENTON MINE
 RENTON COAL CO.
 SITUATE IN
 PLUM TWP ALLEGHENY CO. PA.
 SCALE 1" = 1000'
 FEB. 23, 1959