


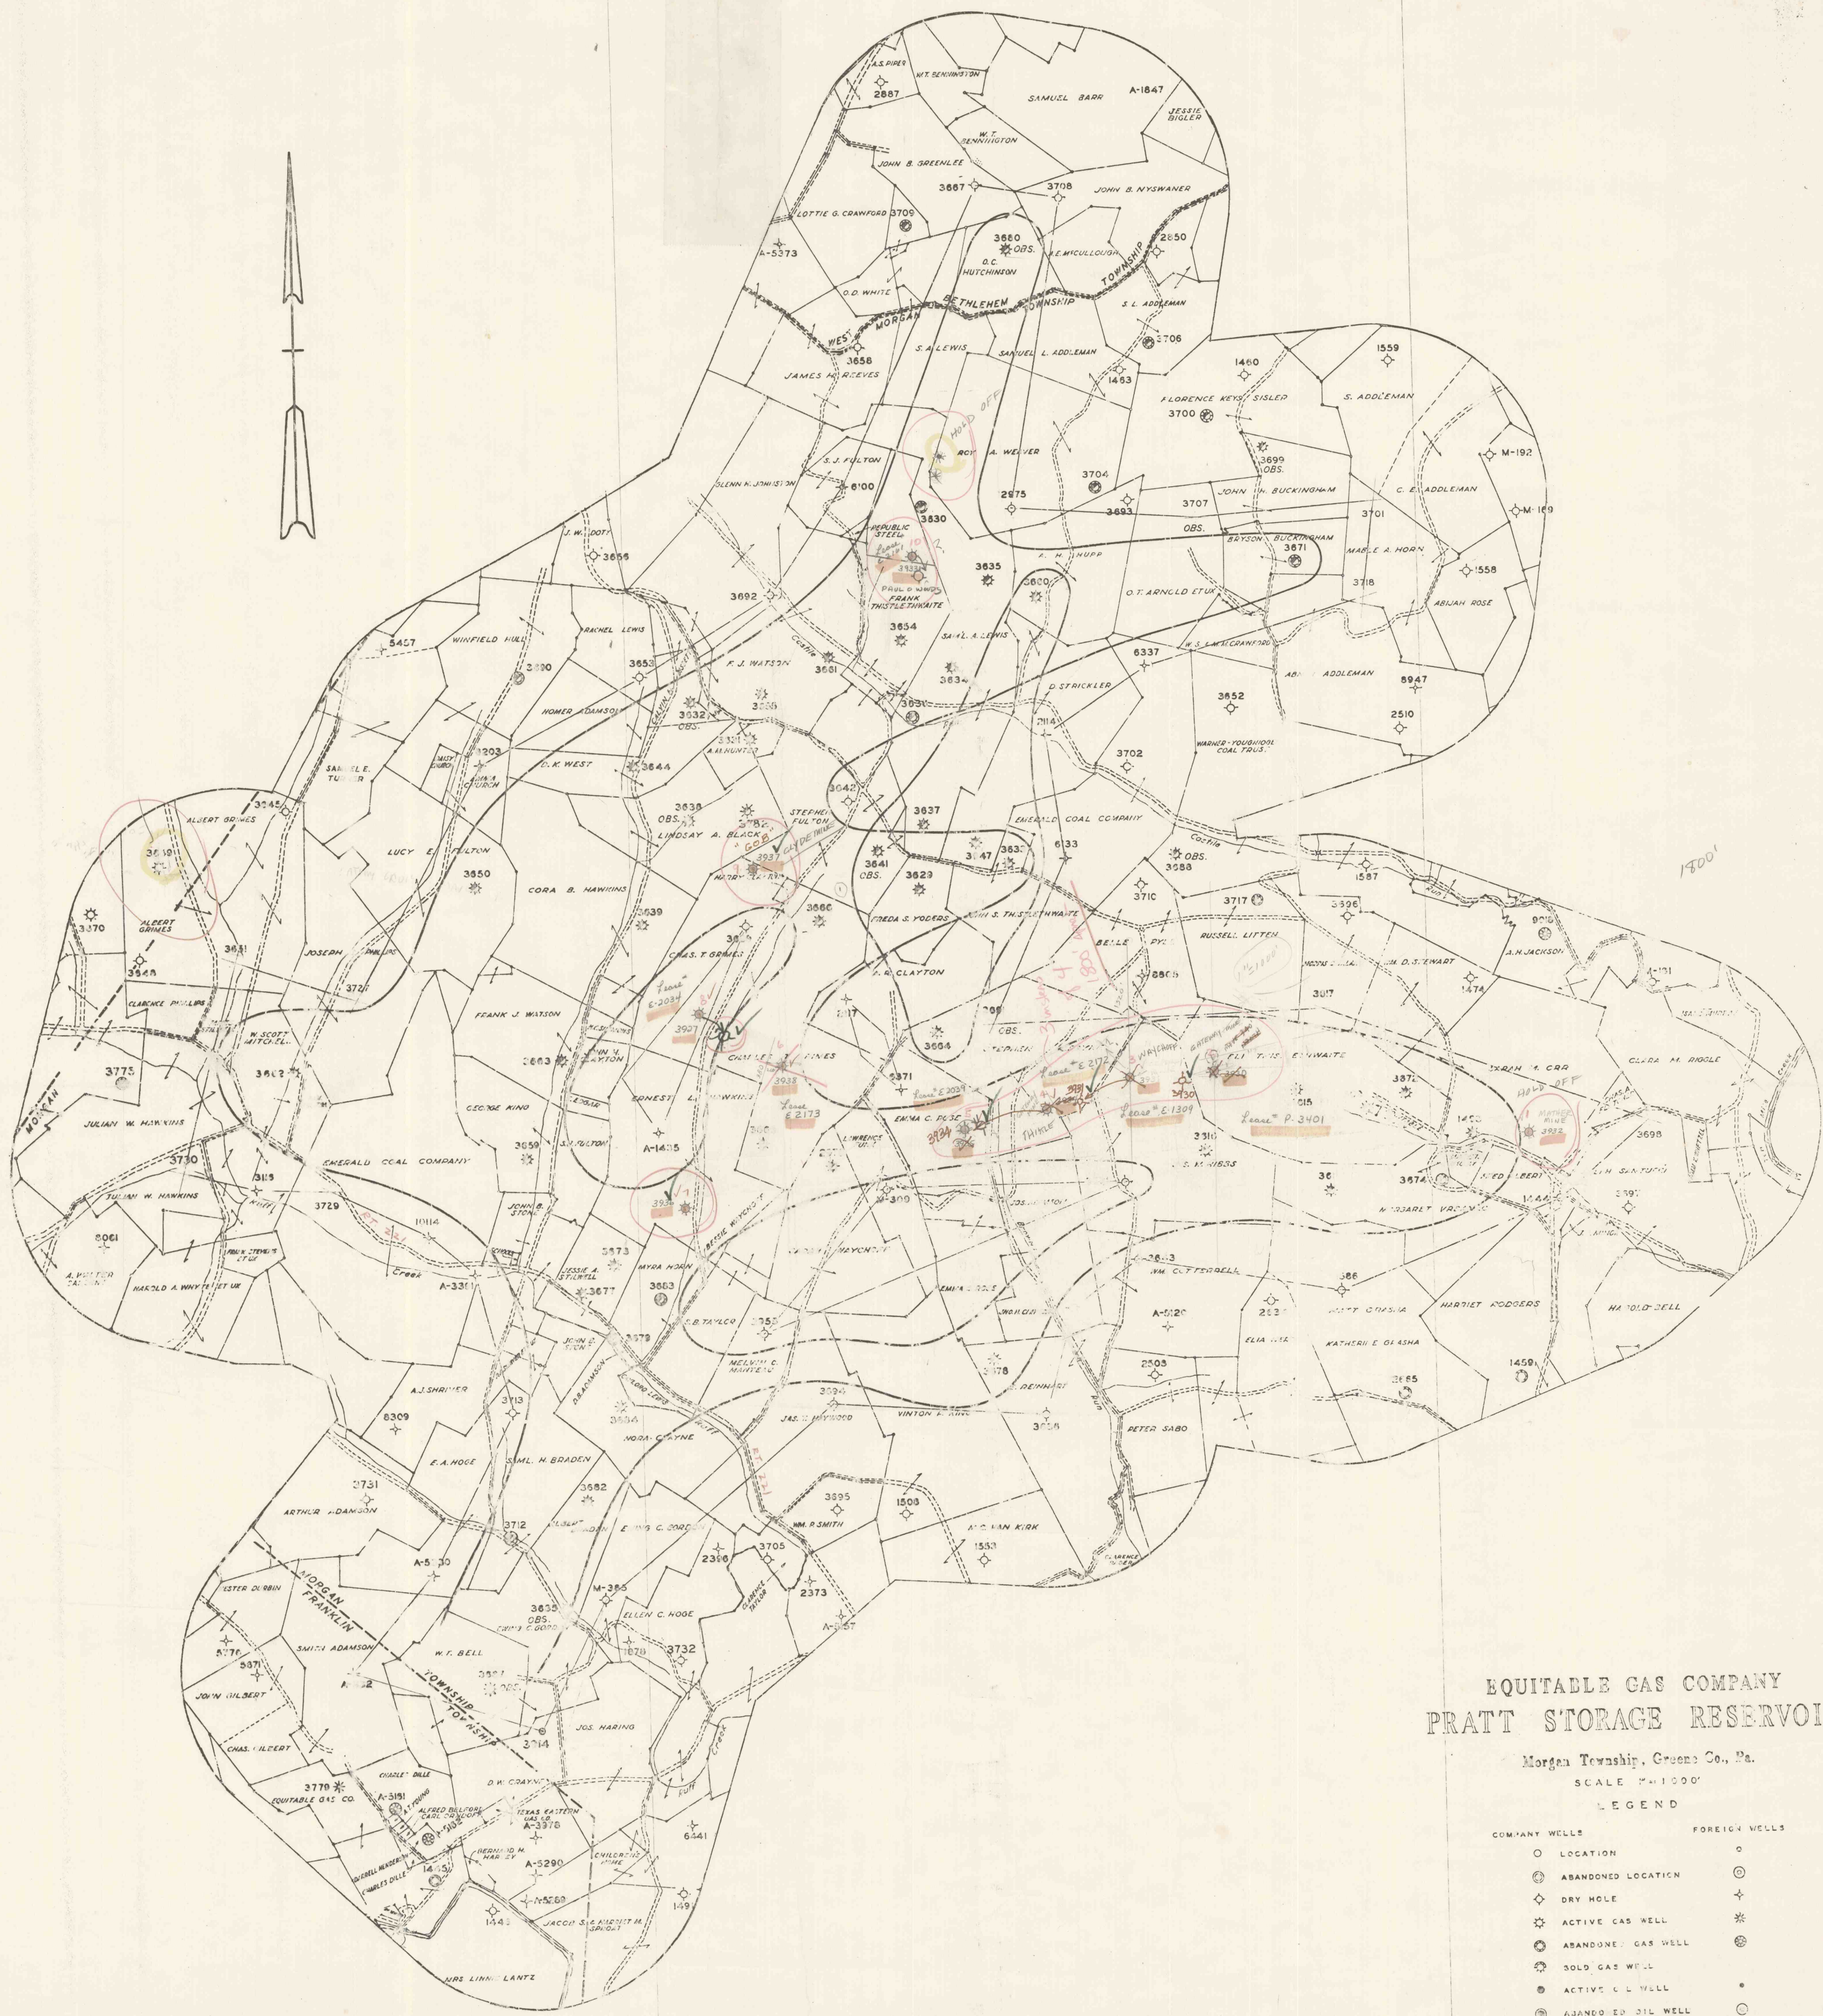

EQUITABLE GAS COMPANY
PRATT STORAGE RESERVOIR

Morgan Township, Green Co., Pa.
SCALE 1"=1000'

LEGEND	
COMPANY WELLS	FOREIGN WELLS
○ LOCATION	○
⊙ ABANDONED LOCATION	⊙
◇ DRY HOLE	+
✱ ACTIVE GAS WELL	✱
⊙ ABANDONED GAS WELL	⊙
⊙ SOLD GAS WELL	⊙
⊙ ACTIVE OIL WELL	⊙
⊙ ABANDONED OIL WELL	⊙
⊙ SOLD OIL WELL	⊙
✱ COMBINATION OIL AND GAS WELL	✱
✱ GAS STORAGE WELL	✱
⊙ ABANDONED GAS STORAGE WELL	⊙