


MINE - NO. 1 & 2
BIRD COAL CO.

C-PRIME MINING OPERATIONS
UPPER KITTANNING SEAM
SITUATE IN

TOWNSHIPS SOMERSET COUNTY PENNA.
SCALE 1" = 1000' BIRD COAL CO. ENGR. DEPT. REVISED 6-30-73

LEGEND
 - B.C.CO. BOUNDARY LINE
 - MINING COMPLETION - 100% RECOVERY
 - MINIMUM 125' - MAXIMUM 175'
 - HOUSE NUMBER - 5' BY 10' STRUCTURES & ROOSTERS
 - DIAMOND DRILL HOLES 5" TO 7 1/2" DIAMETER

LEGEND
 - B.C.CO. BOUNDARY LINE
 - MINING COMPLETION - 100% RECOVERY
 - MINIMUM 125' - MAXIMUM 175'
 - HOUSE NUMBER - 5' BY 10' STRUCTURES & ROOSTERS

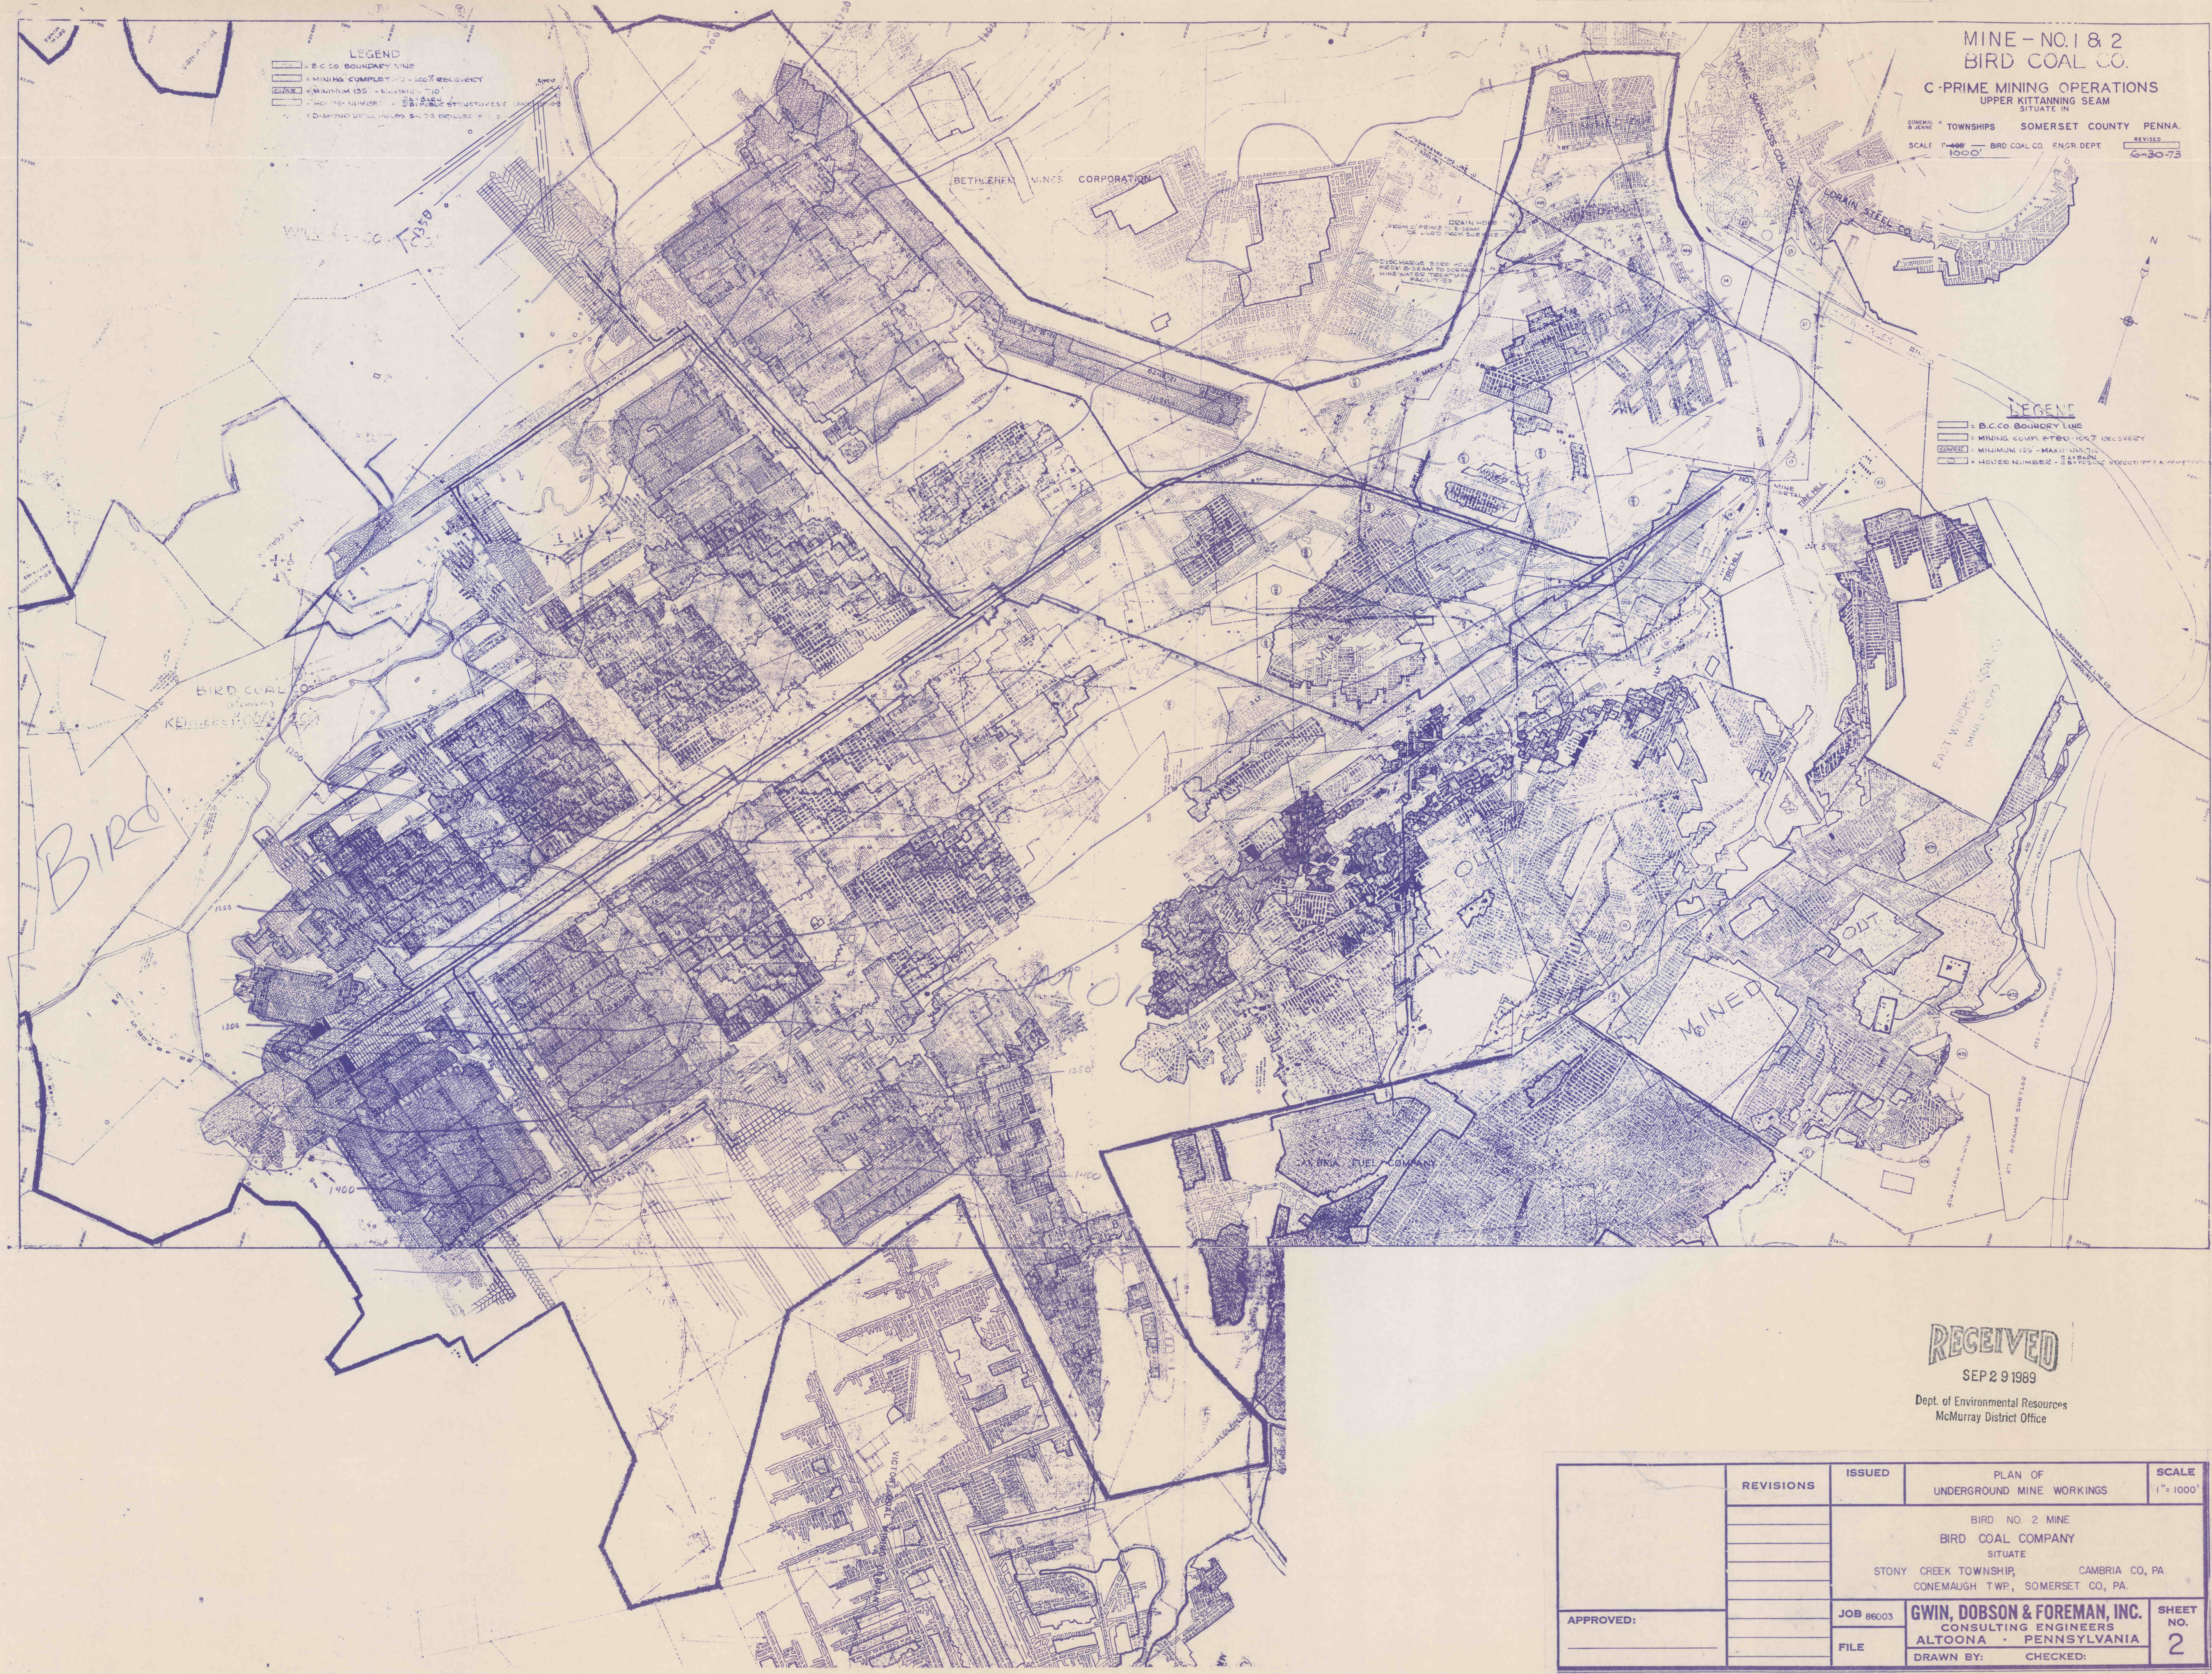

RECEIVED

SEP 29 1989
 Dept. of Environmental Resources
 McMurray District Office

APPROVED:	REVISIONS	ISSUED	PLAN OF UNDERGROUND MINE WORKINGS	SCALE 1" = 1000'
			BIRD NO. 2 MINE BIRD COAL COMPANY SITUATE STONY CREEK TOWNSHIP, CAMBRIA CO., PA. CONEMAUGH TWP., SOMERSET CO., PA.	
	JOB 86003		GWIN, DOBSON & FOREMAN, INC. CONSULTING ENGINEERS ALTOONA - PENNSYLVANIA	SHEET NO. 2
	FILE		DRAWN BY: CHECKED:	