


LEASE No 3061929
B.T. SUBLEASED
TO
J. & L. STEEL 288,98A.
"D" SEAM

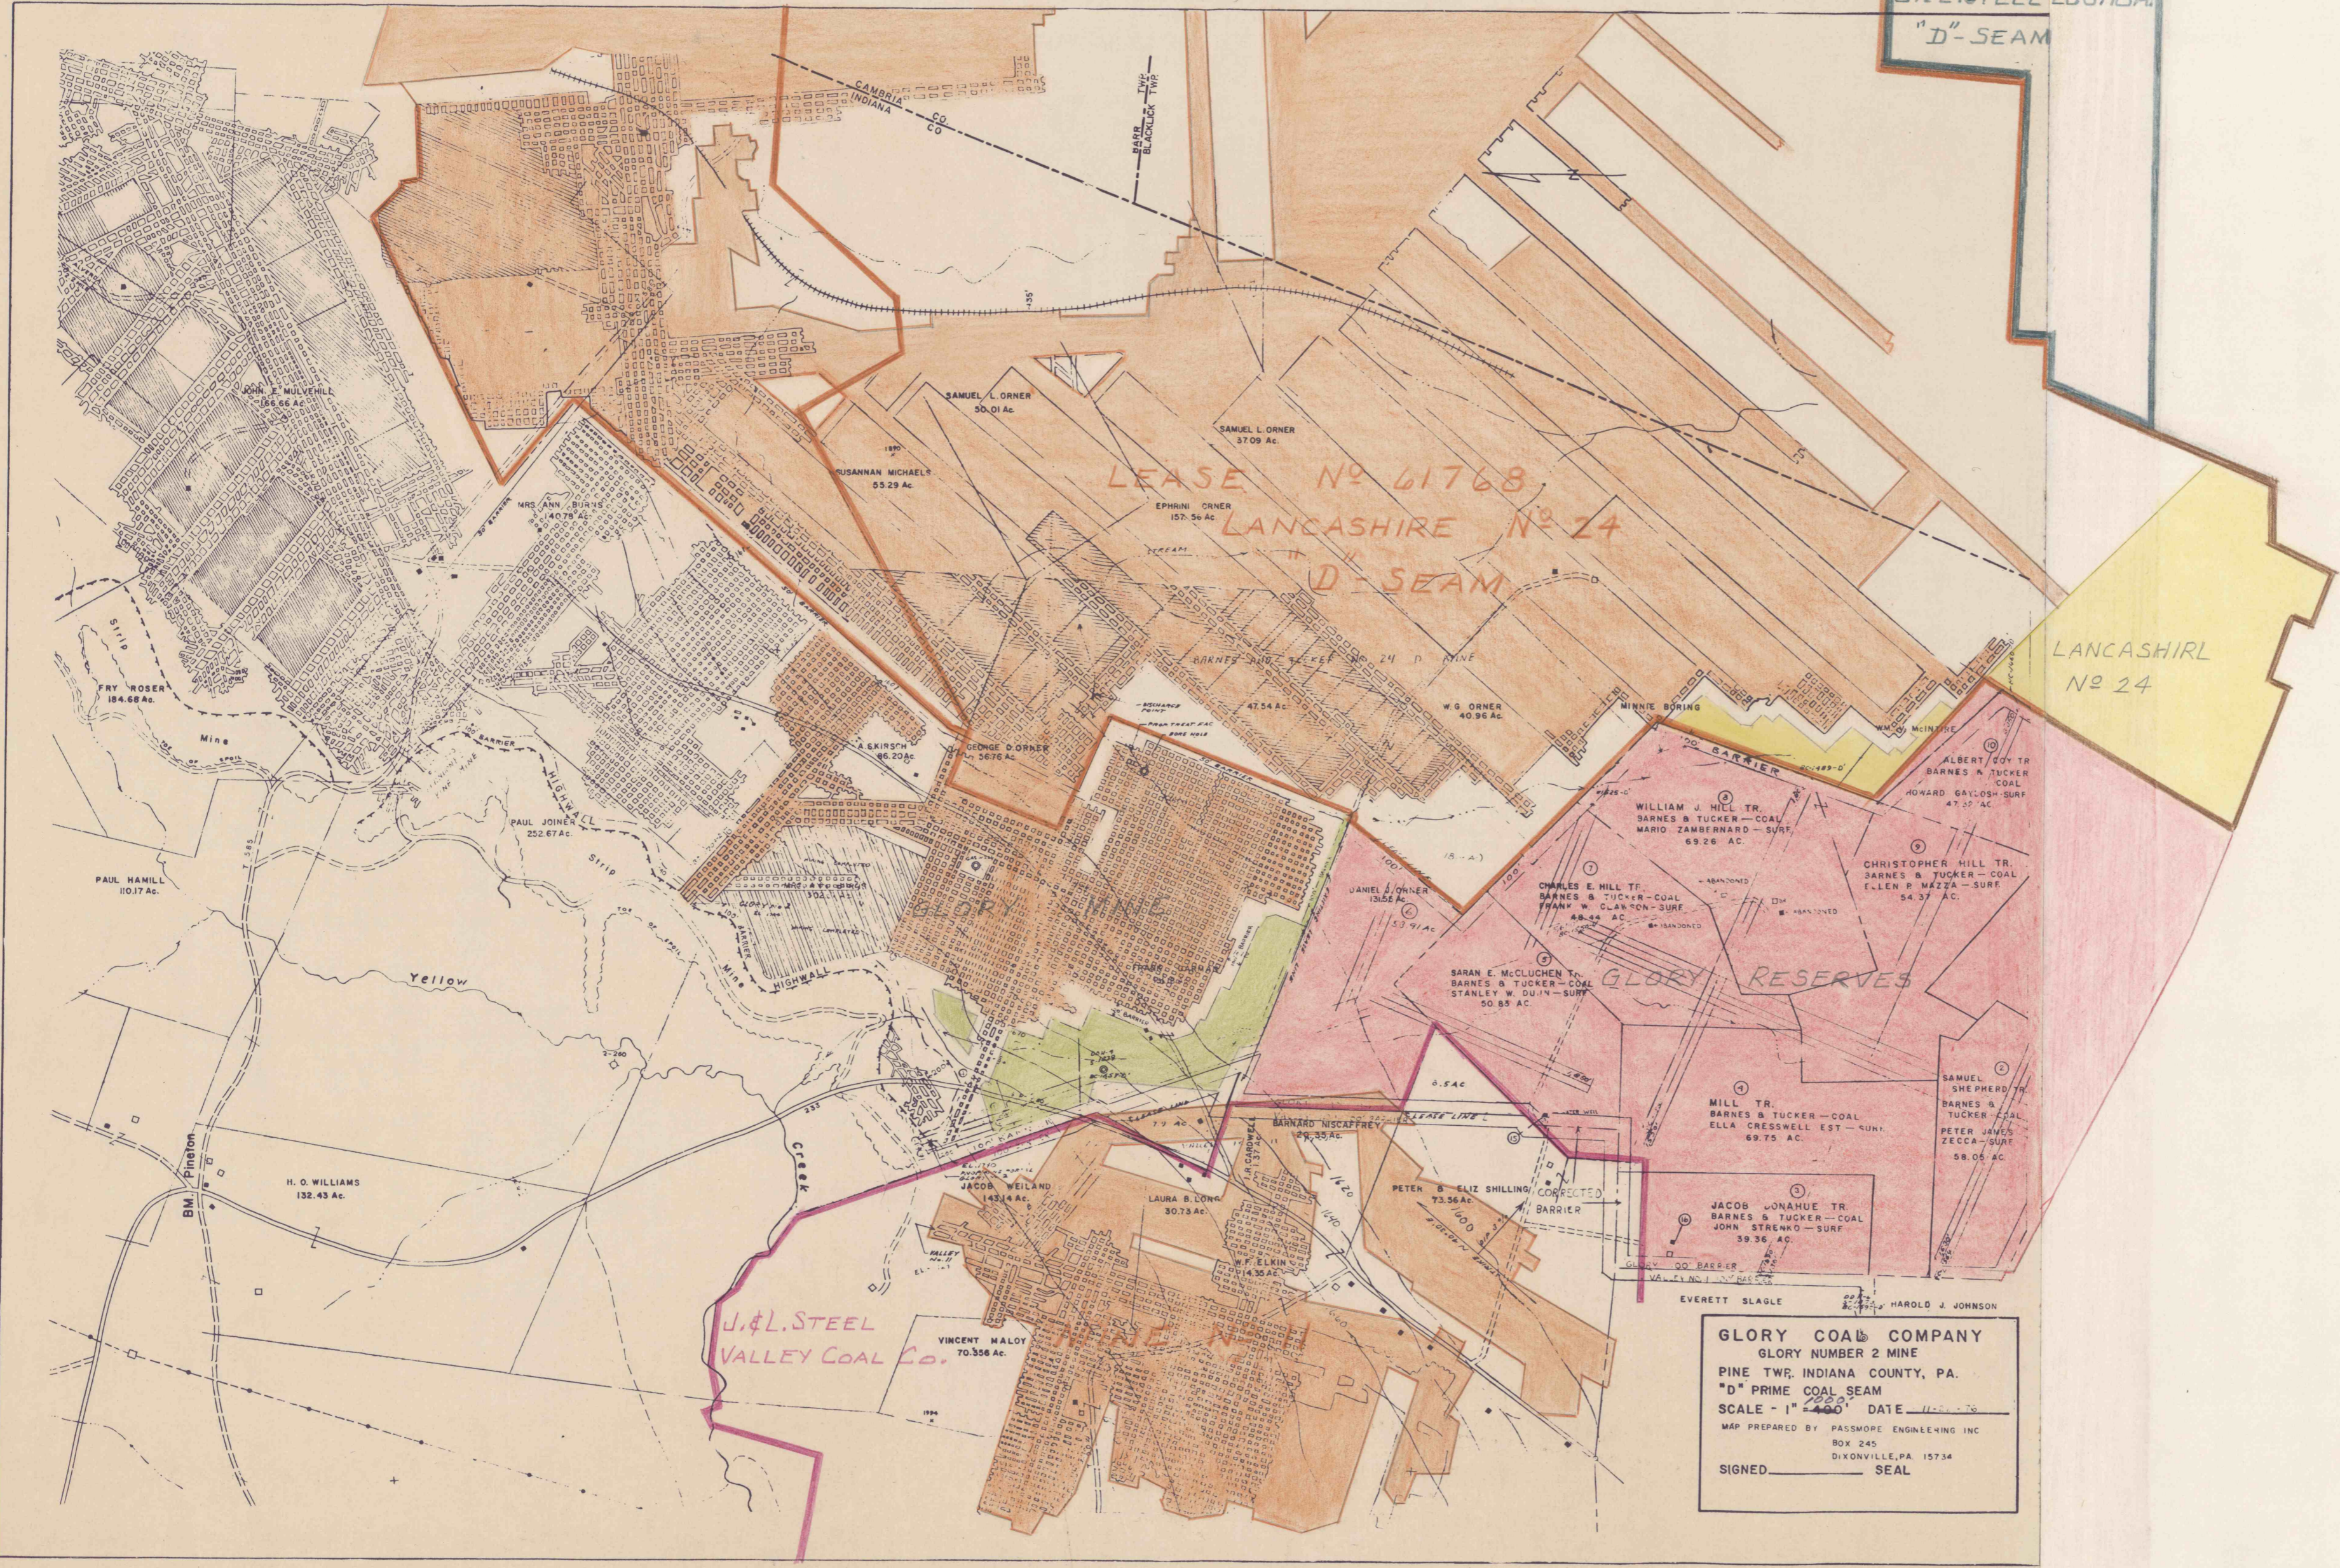

J. & L. STEEL
VALLEY COAL CO.

GLORY COAL COMPANY
GLORY NUMBER 2 MINE
PINE TWP, INDIANA COUNTY, PA.
"D" PRIME COAL SEAM
SCALE - 1" = 400' DATE 11-22-76
MAP PREPARED BY PASSMORE ENGINEERING INC
BOX 245
DIXONVILLE, PA 15734
SIGNED _____ SEAL