



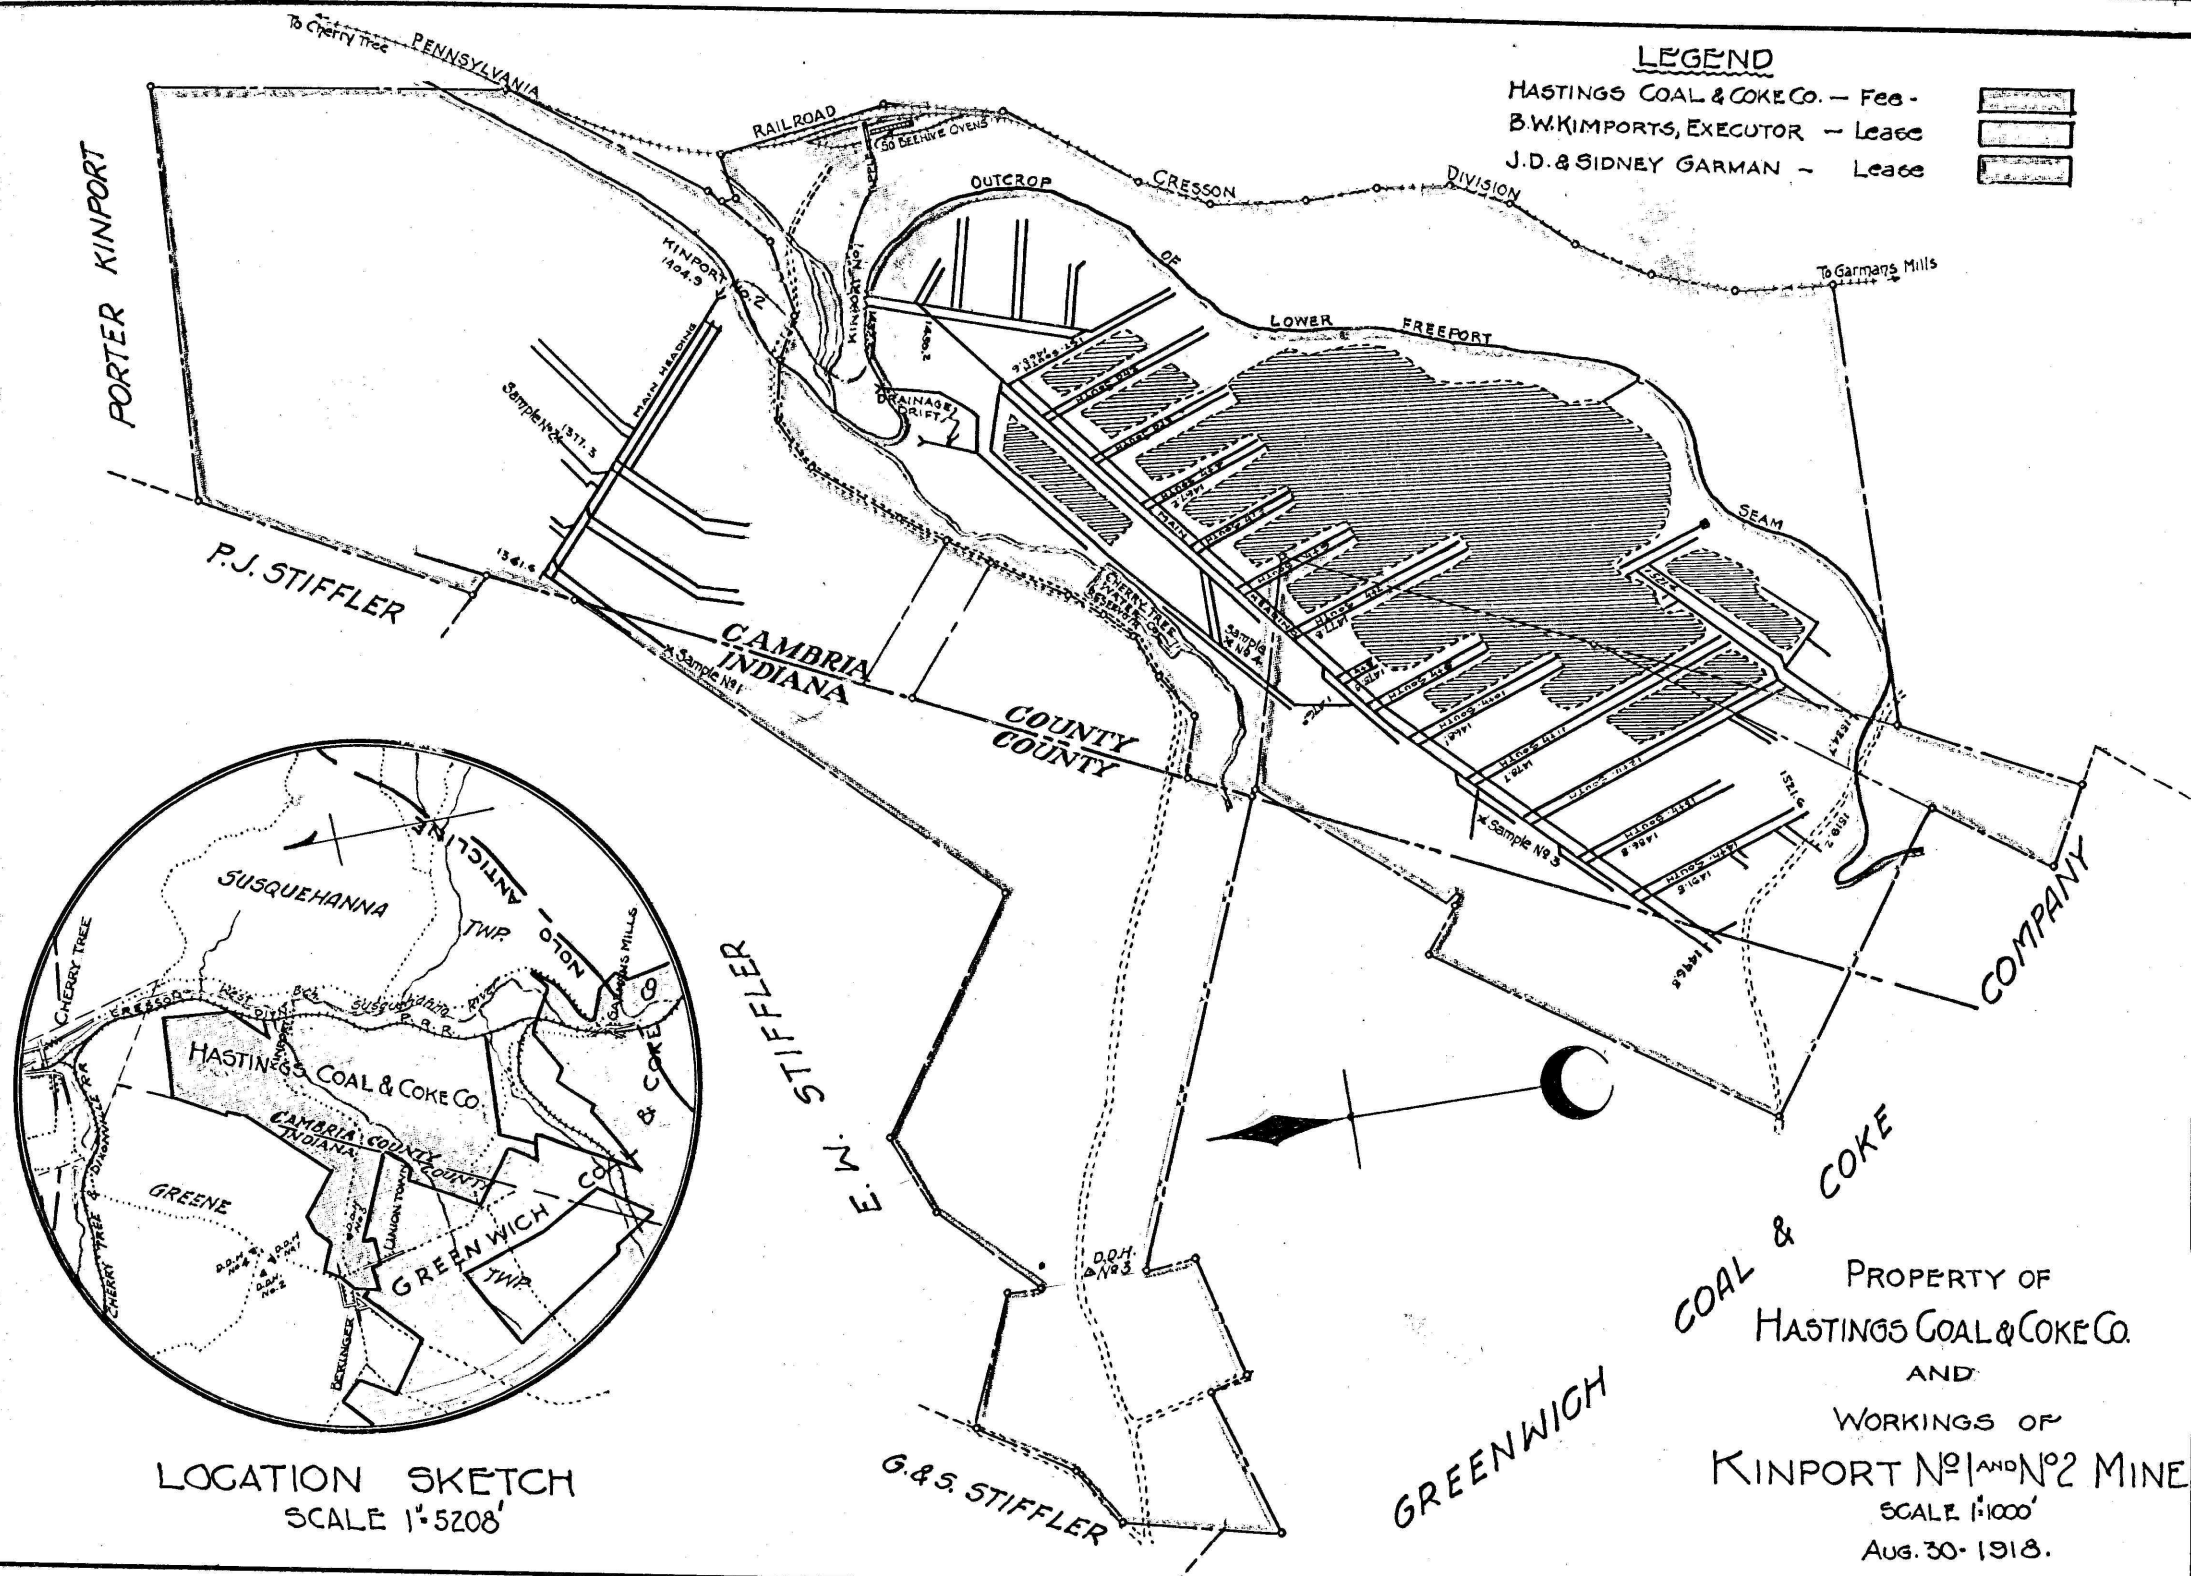

LEGEND

- HASTINGS COAL & COKE CO. - Fee - [Symbol]
- B.W. KIMPORTS, EXECUTOR - Lease - [Symbol]
- J.D. & SIDNEY GARMAN - Lease - [Symbol]

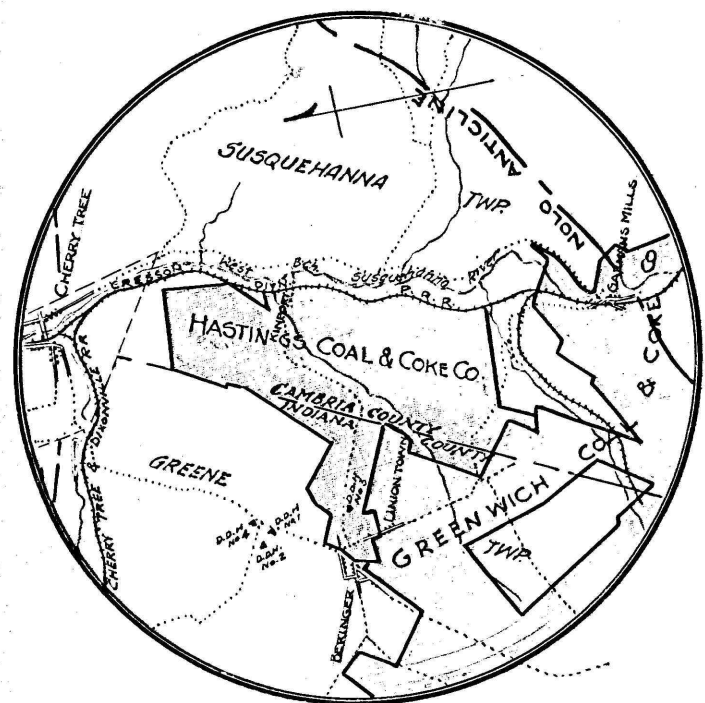

LOCATION SKETCH
SCALE 1"=5208'

PROPERTY OF
HASTINGS COAL & COKE CO.
AND
WORKINGS OF
KINPORT NO. 1 AND NO. 2 MINE
SCALE 1"=1000'
Aug. 30-1918.