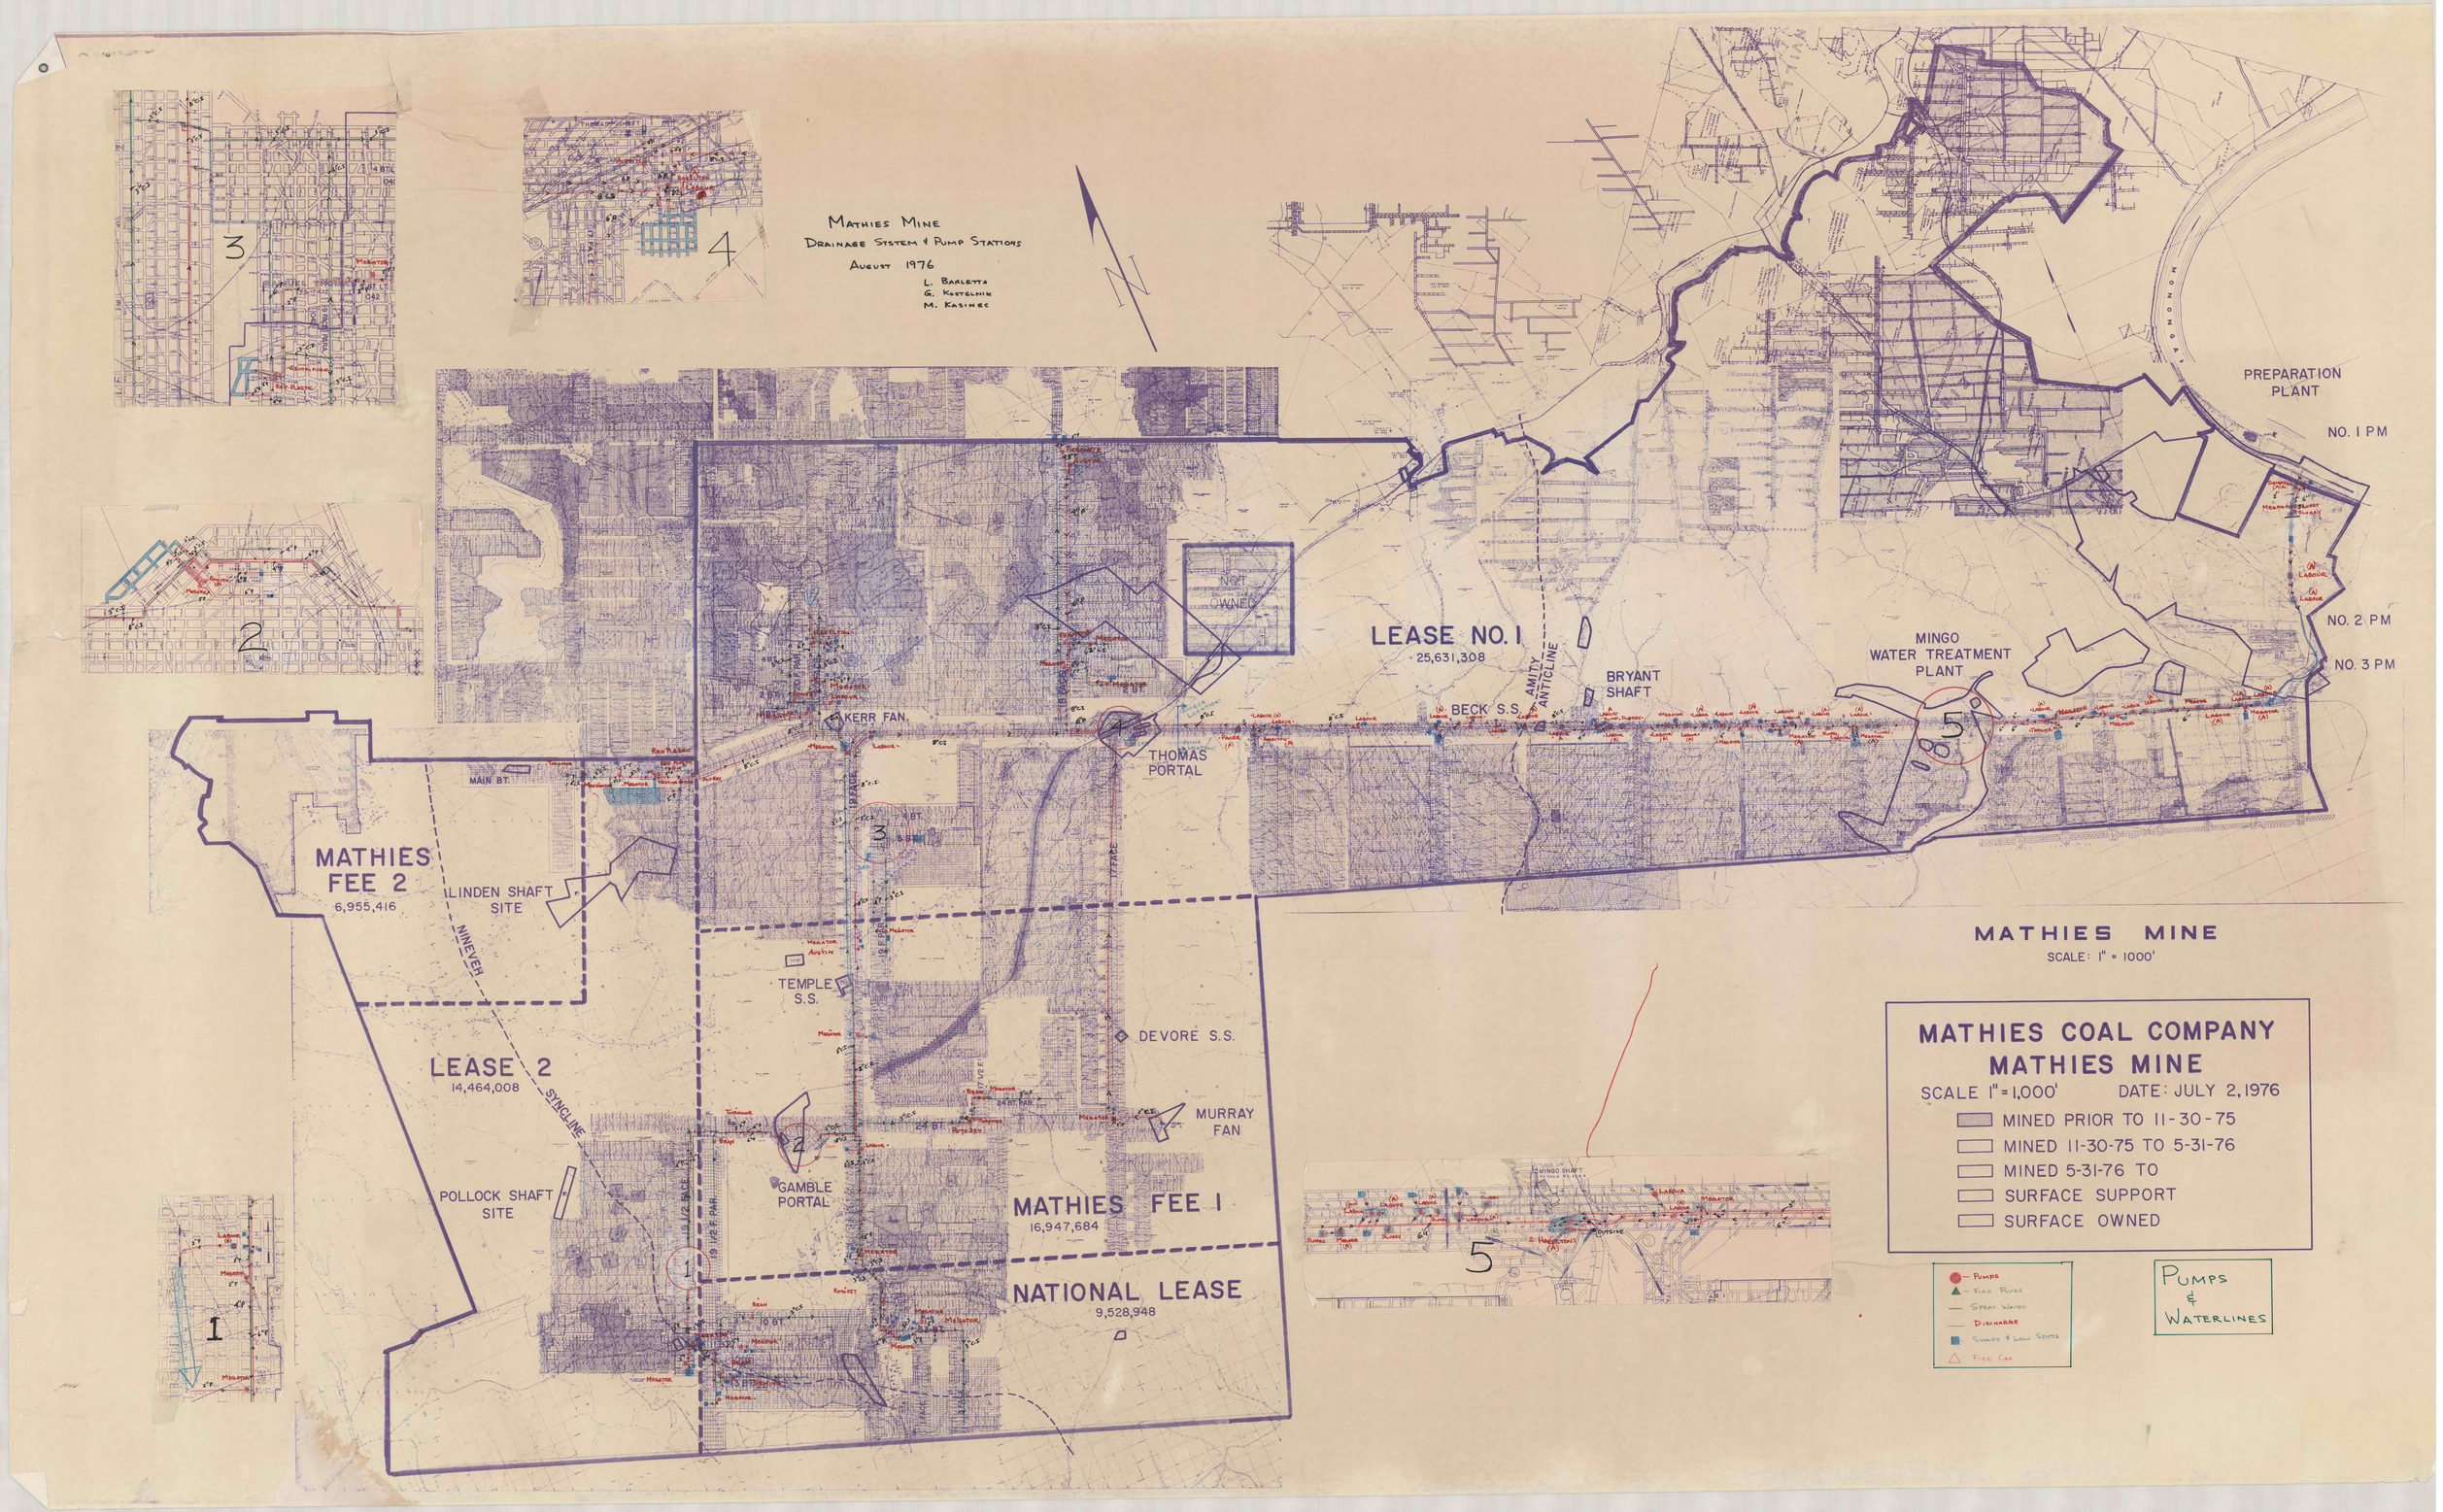
MATHIES MINE
DRAINAGE SYSTEM & PUMP STATIONS
AUGUST 1976
L. BARLETTA
G. KOSTELNIK
M. KASINEC
PREPARATION PLANT
NO. 1 PM
NO. 2 PM
NO. 3 PM
MINGO WATER TREATMENT PLANT
LEASE NO. 1
25,631,308
AMITY ANTICLINE
BRYANT SHAFT
BECK S.S.
KERR FAN
THOMAS PORTAL
MAIN BT.
MATHIES FEE 2
6,955,416
LINDEN SHAFT SITE
NINEVEH SYNCLINE
TEMPLE S.S.
DEVORE S.S.
LEASE 2
14,464,008
MURRAY FAN
GAMBLE PORTAL
POLLOCK SHAFT SITE
MATHIES FEE 1
16,947,684
NATIONAL LEASE
9,528,948
MATHIES MINE
SCALE: 1" = 1000'
MATHIES COAL COMPANY
MATHIES MINE
SCALE 1" = 1,000'
DATE: JULY 2, 1976
MINED PRIOR TO 11-30-75
MINED 11-30-75 TO 5-31-76
MINED 5-31-76 TO
SURFACE SUPPORT
SURFACE OWNED
PUMPS
FIRE PLUGS
SPRAY WATER
DISCHARGE
SUMPS & LOW SPOTS
FIRE CAR
PUMPS & WATERLINES