
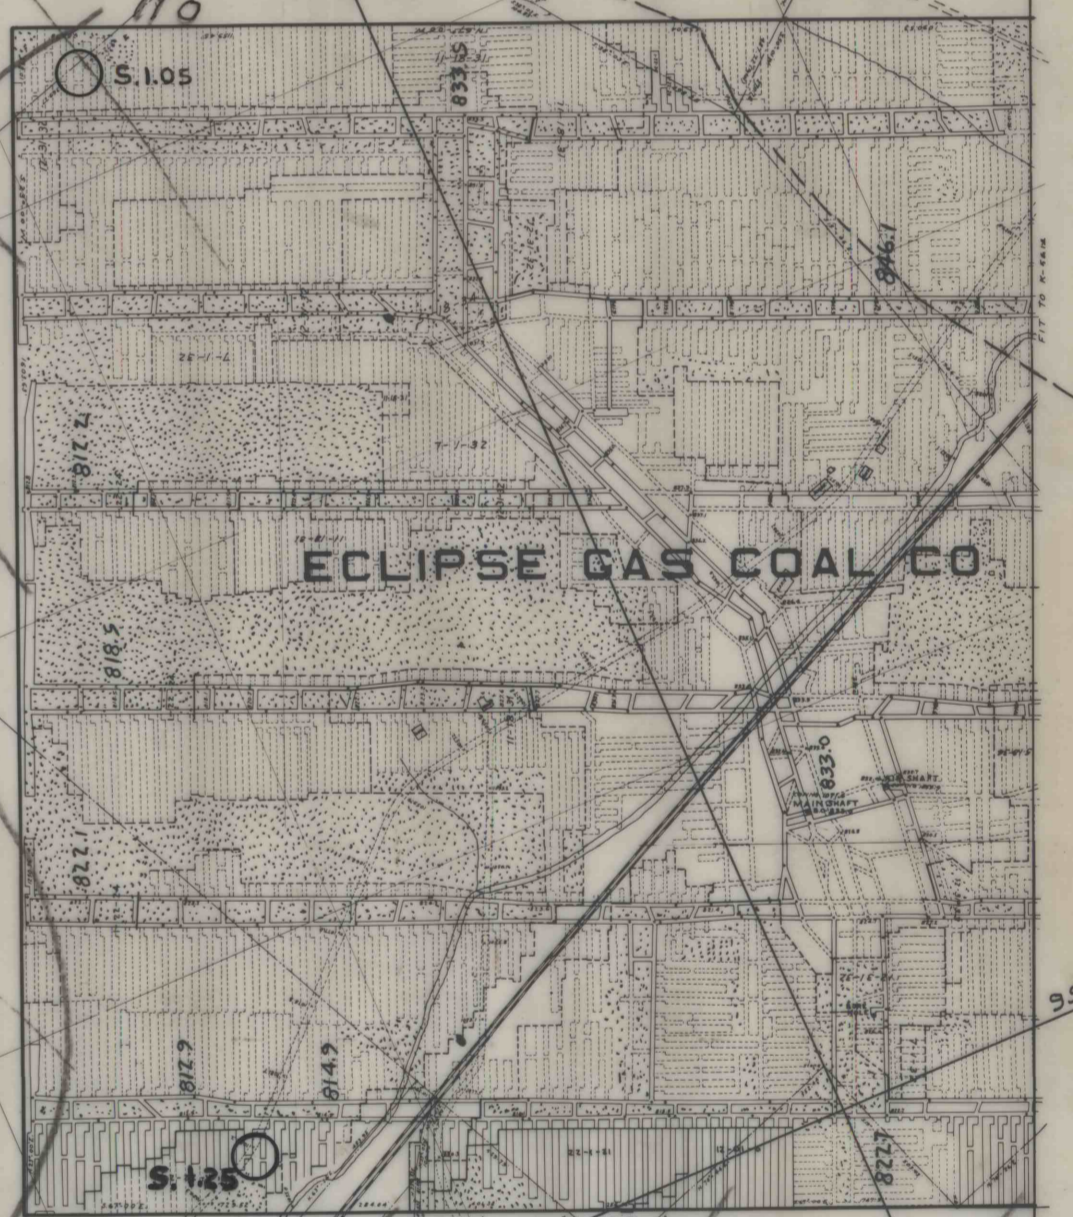


MONTOUR NO. 4 MINE

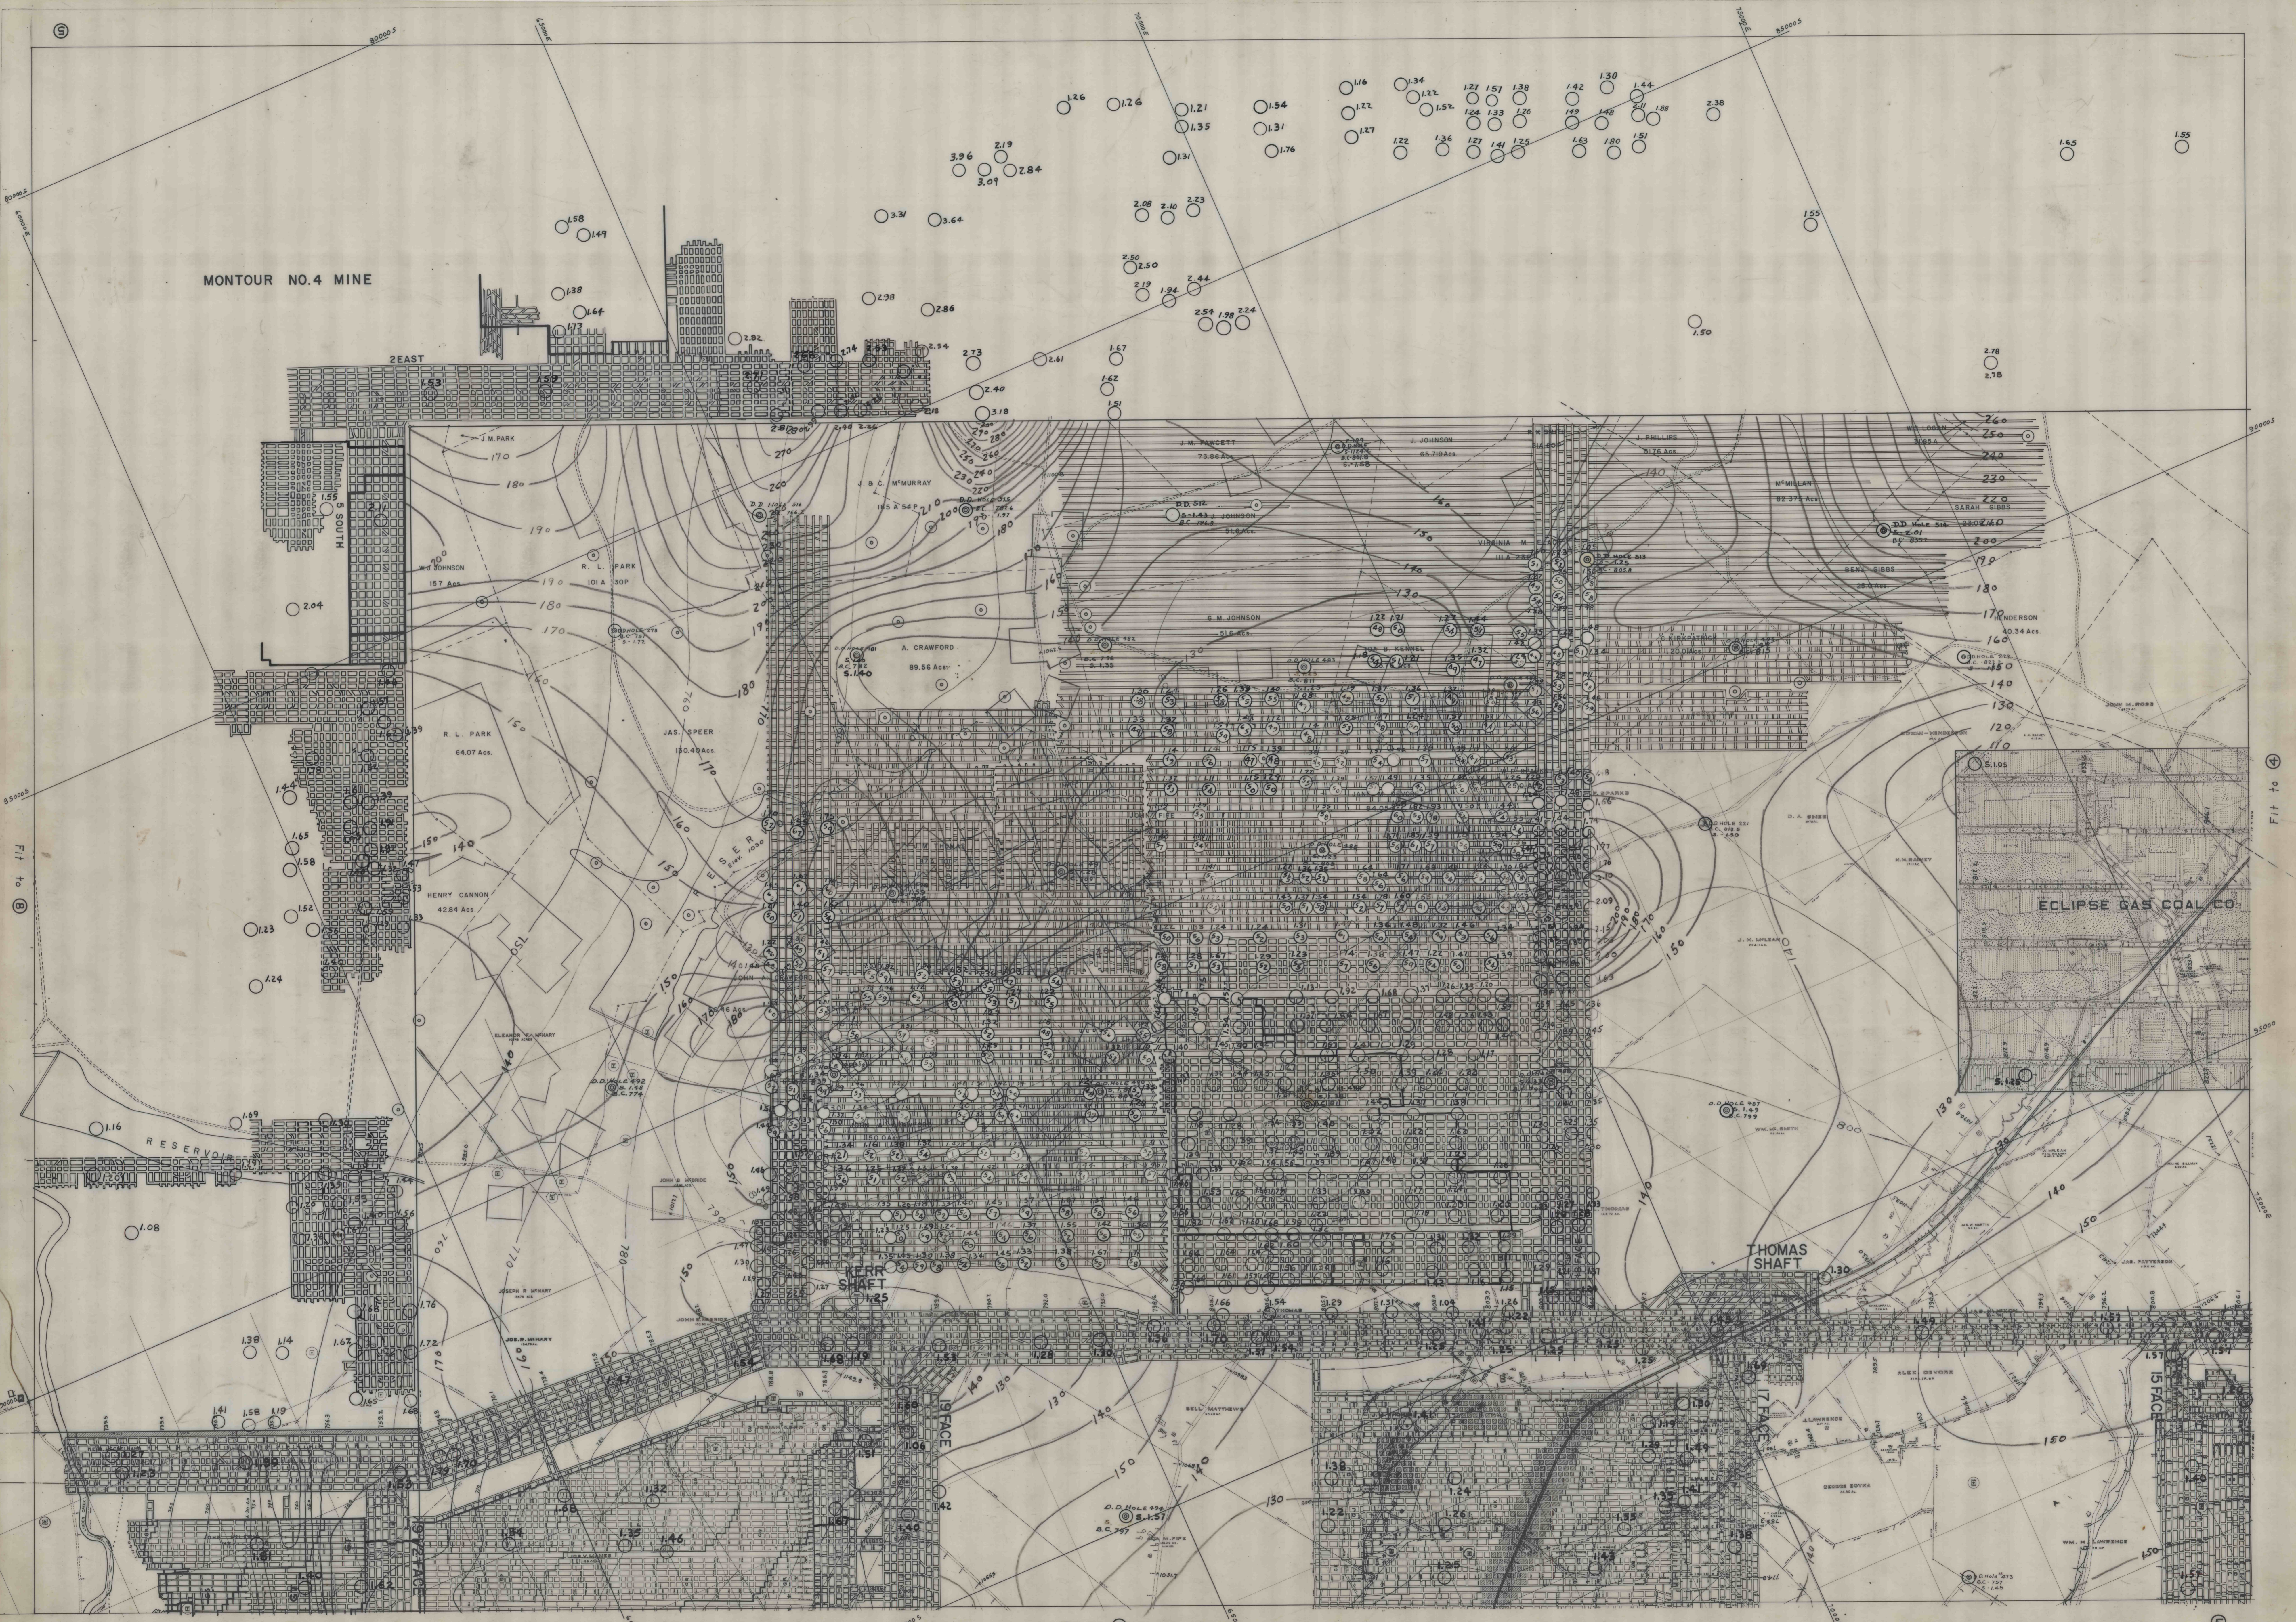

Fit to (B)

Fit to (C)