


Division

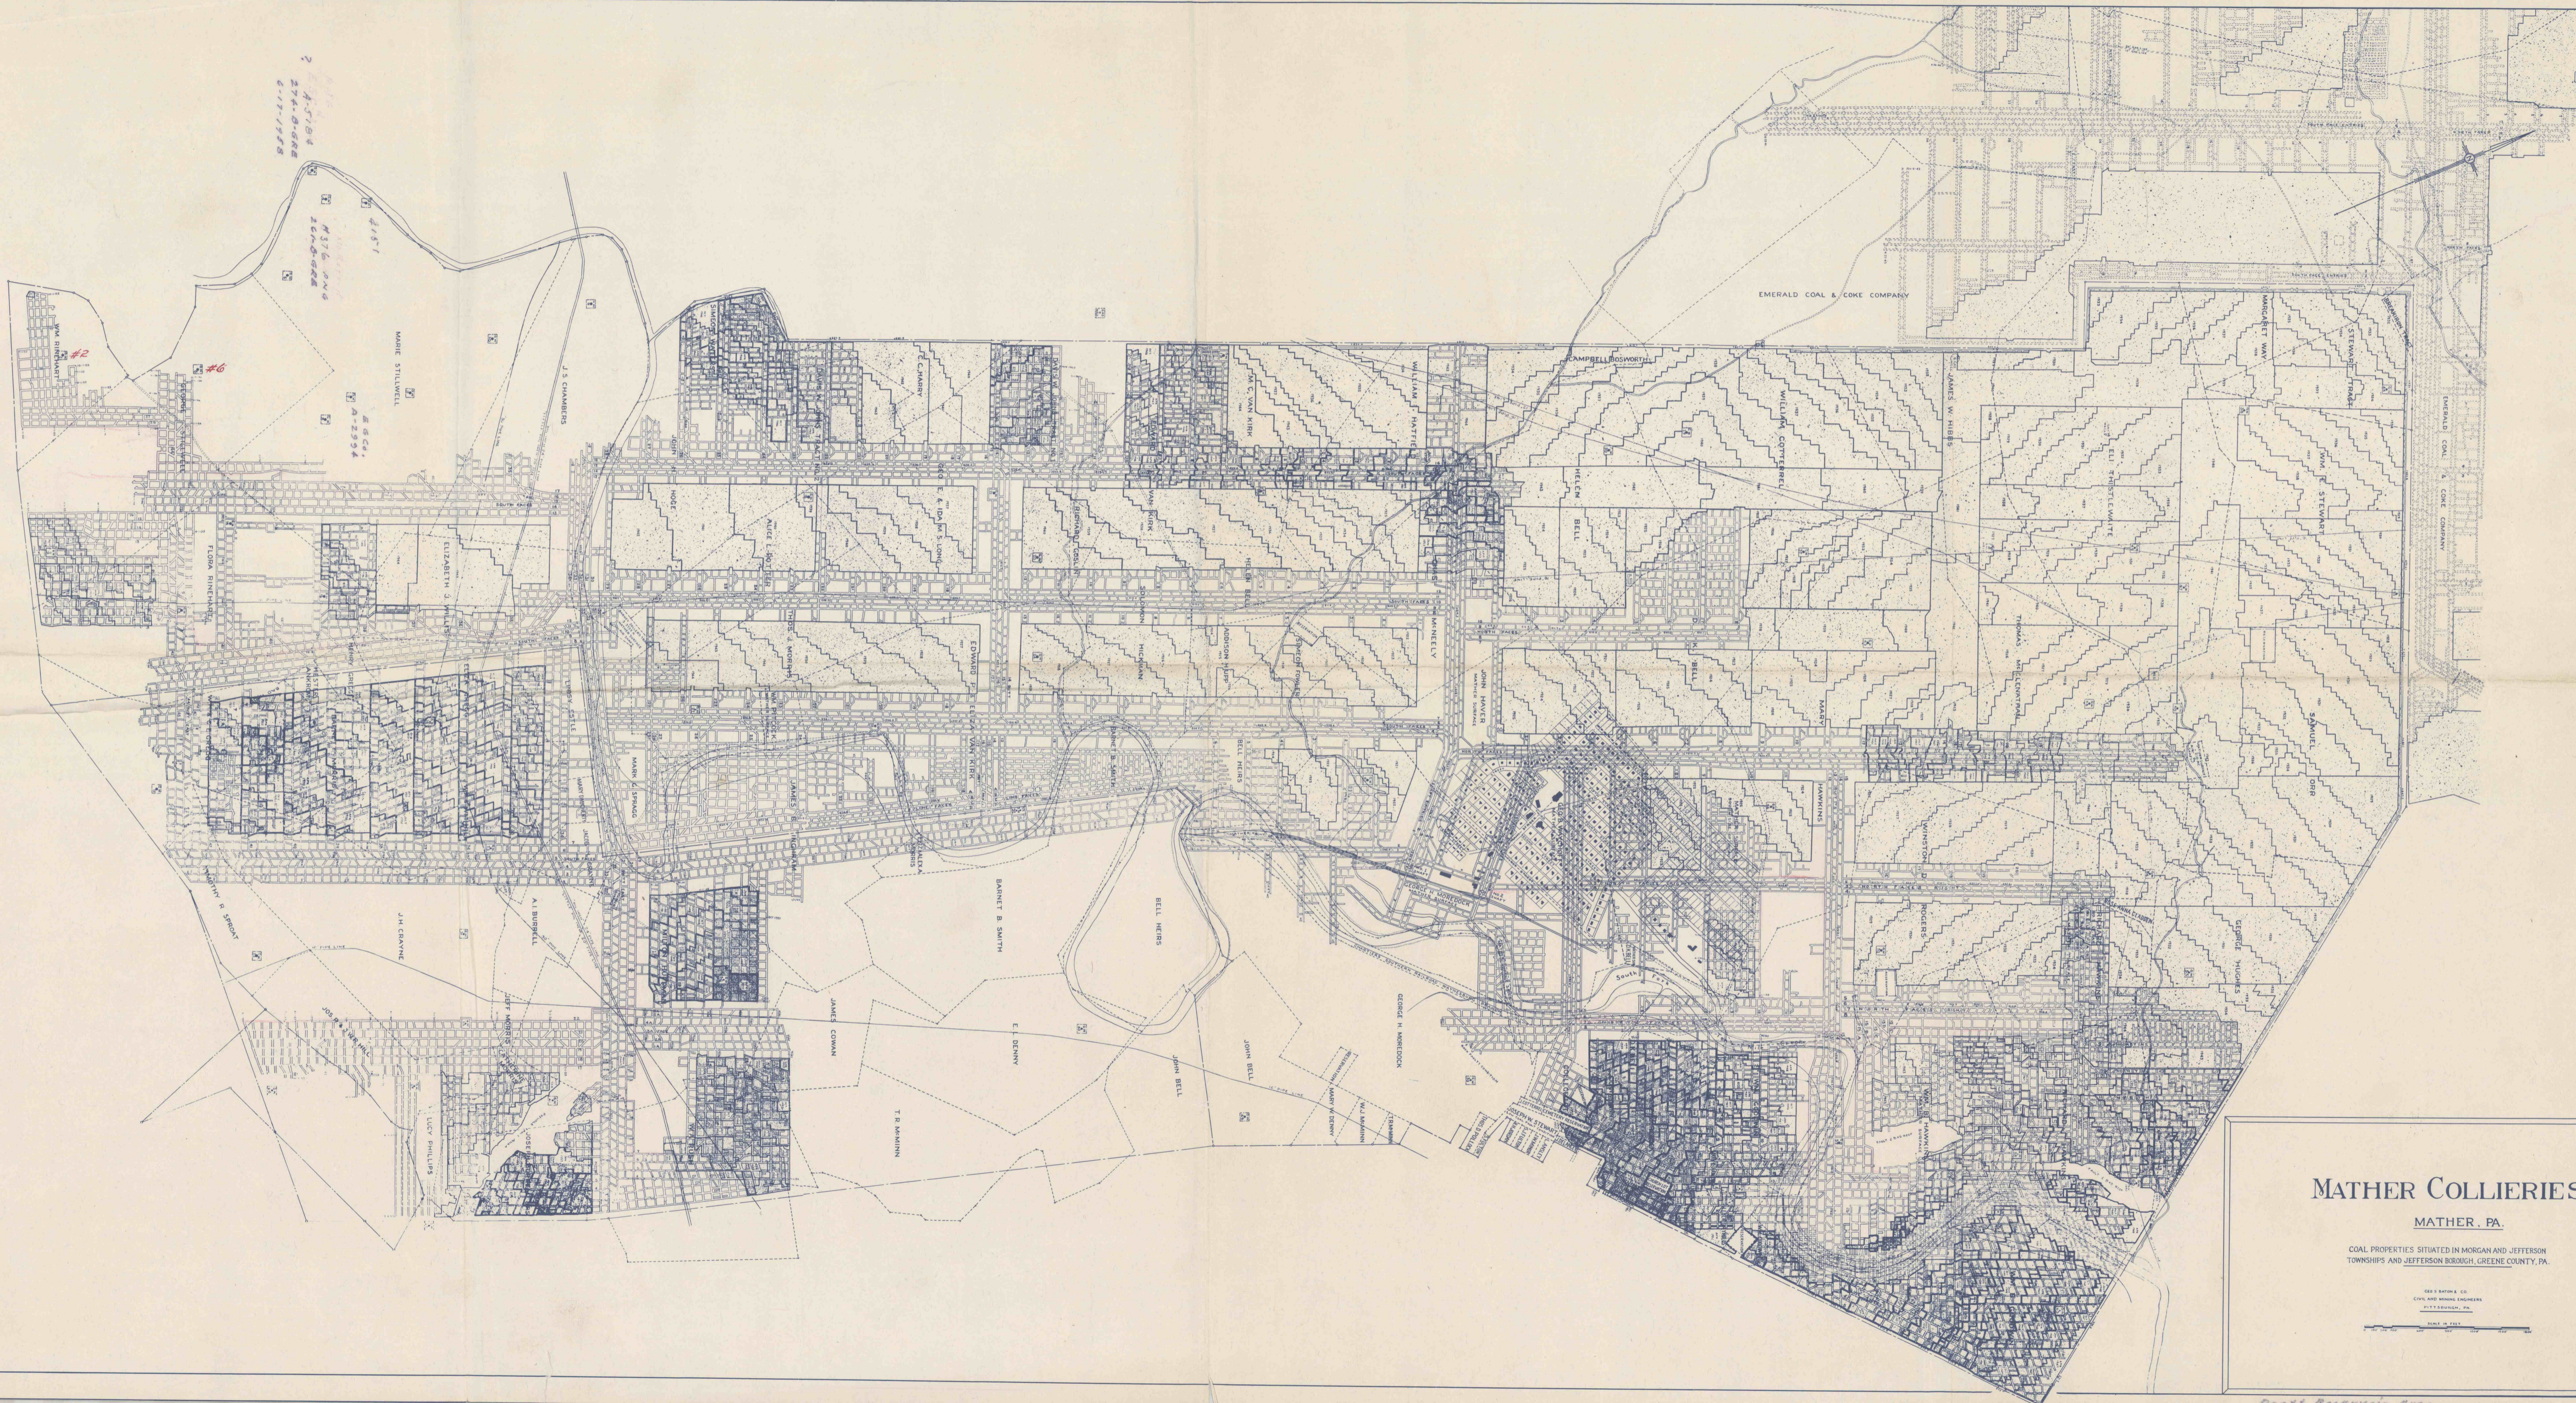

MATHER COLLIERIES
 MATHER, PA.
 COAL PROPERTIES SITUATED IN MORGAN AND JEFFERSON
 TOWNSHIPS AND JEFFERSON BOROUGH, GREENE COUNTY, PA.

Geo. S. BATH & CO.
 CIVIL AND MINING ENGINEERS


17
 3806
 Green's Farm

Pratt Reserve Area 01/1911