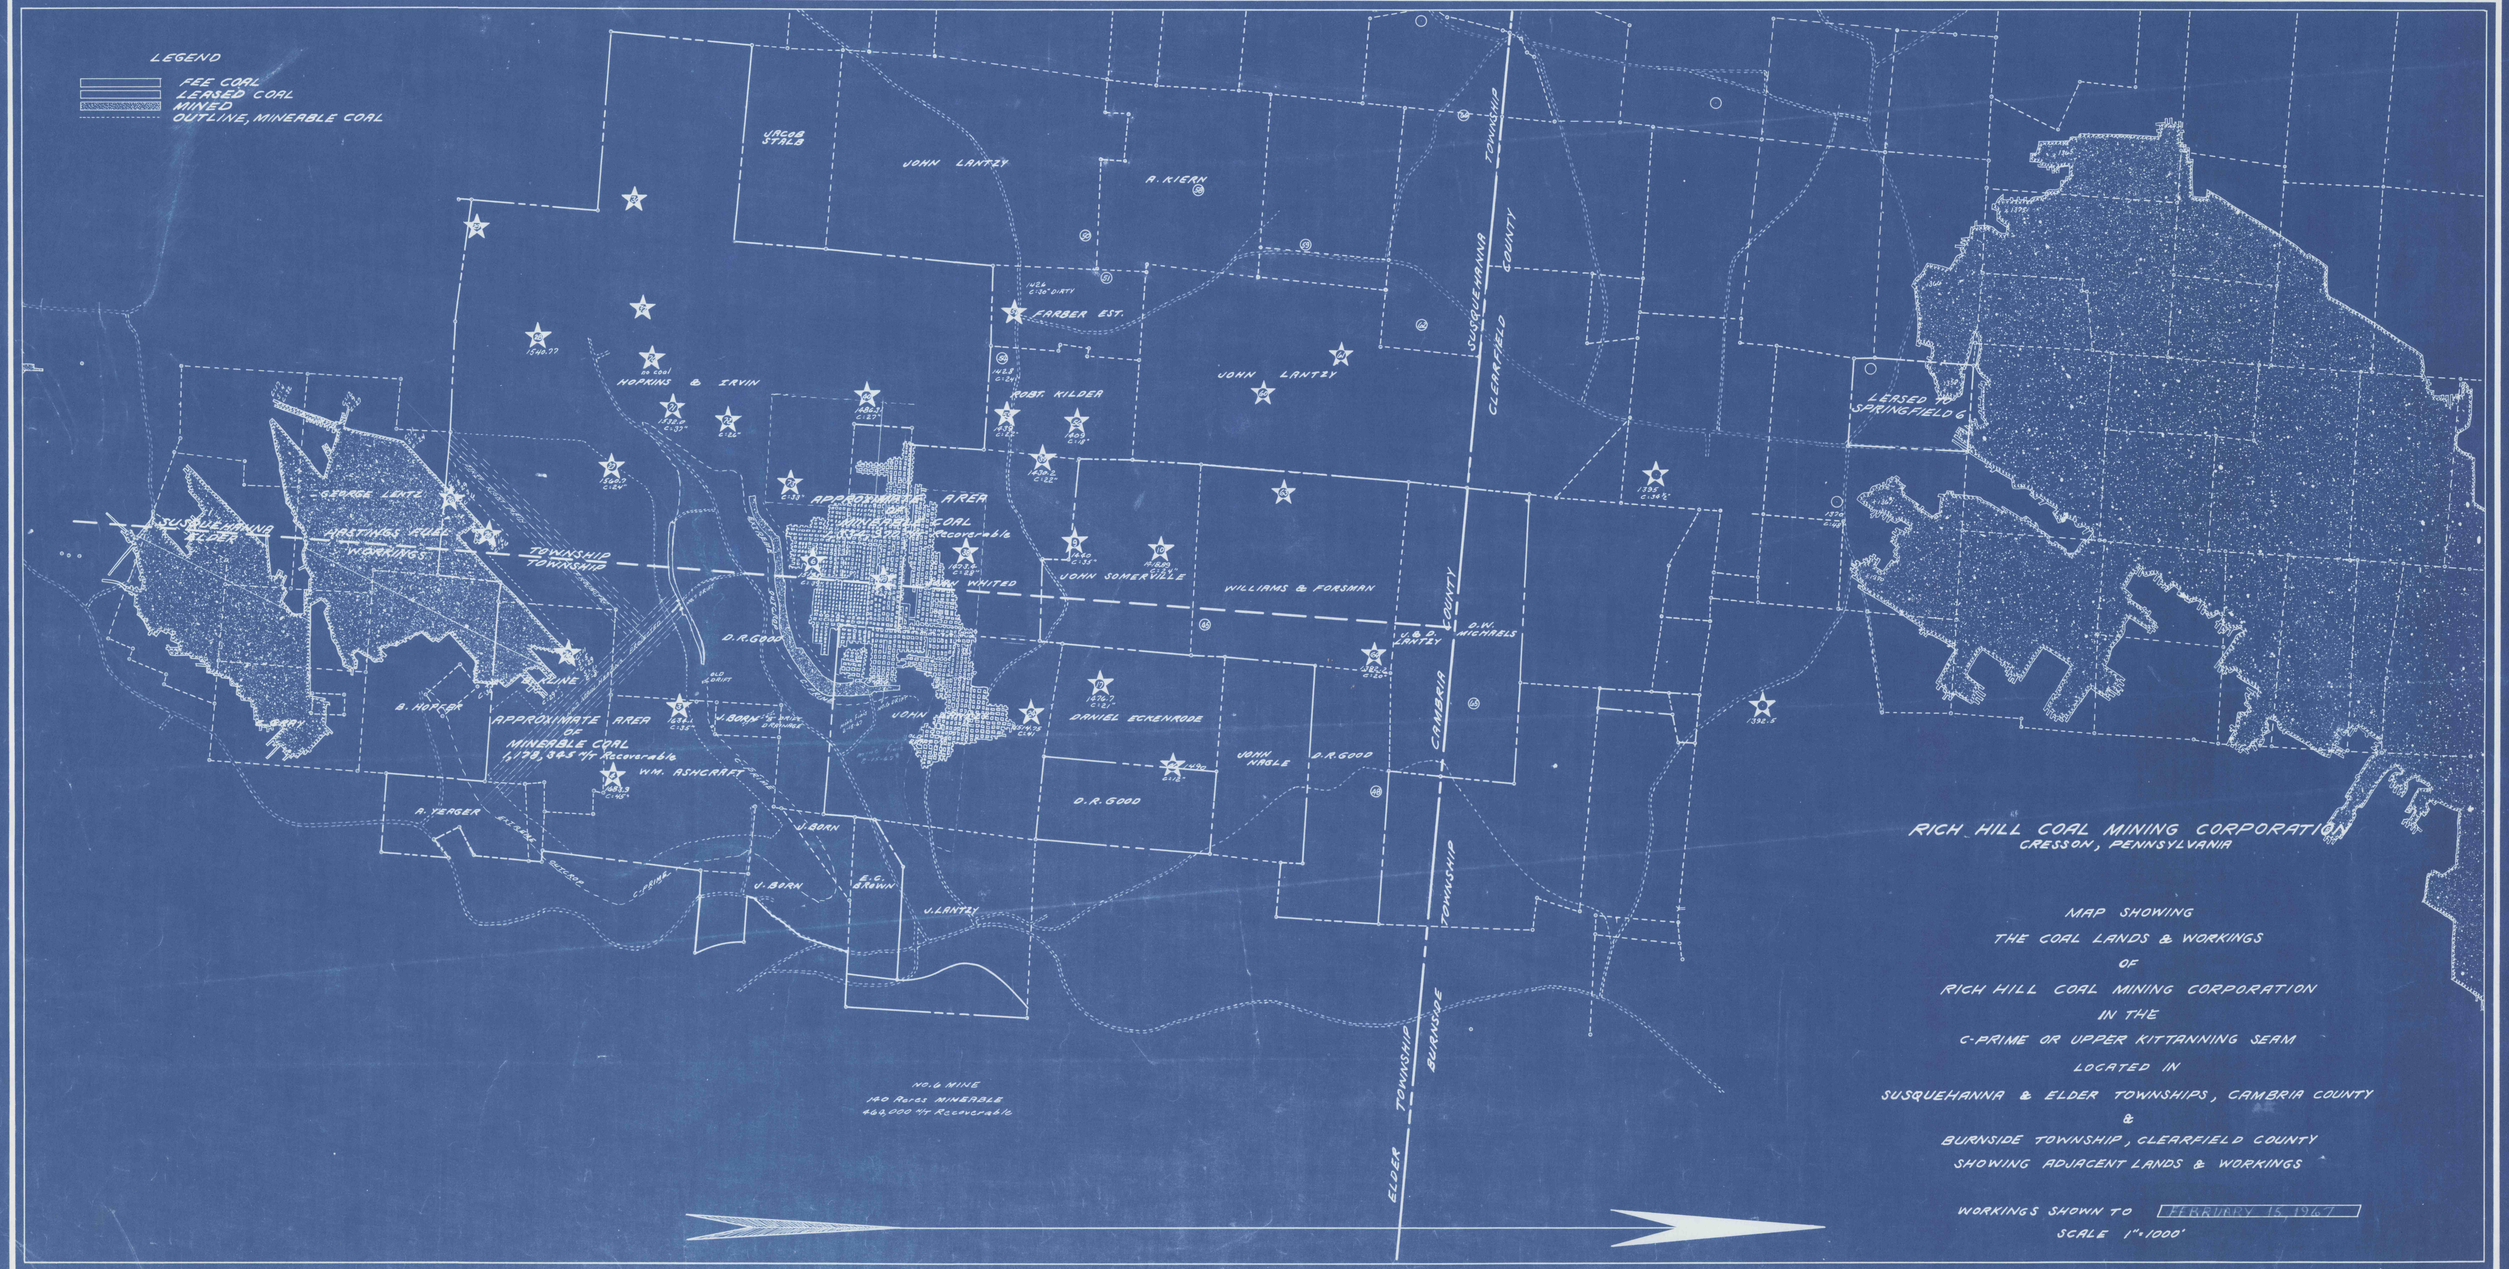
LEGEND
FEE COAL
LEASED COAL
MINED
OUTLINE, MINEABLE COAL
JACOB STALB
JOHN LANTZY
A. KIERN
FARBER EST.
HOPKINS & IRVIN
ROBT. KILDER
JOHN LANTZY
SUSQUEHANNA TOWNSHIP
CLEARFIELD COUNTY
LEASED TO SPRINGFIELD 6
GEORGE LENTZ
SUSQUEHANNA
ELDER
HASTINGS FUEL WORKINGS
TOWNSHIP
TOWNSHIP
APPROXIMATE AREA OF MINEABLE COAL
JOHN WHITED
JOHN SOMERVILLE
WILLIAMS & FORSMAN
D.W. MICHAELS
J. & D. LANTZY
D.R. GOOD
B. KLINE
B. HOPFER
APPROXIMATE AREA OF MINEABLE COAL
1,178,345 M/T Recoverable
WM. ASHCRAFT
JOHN
DANIEL ECKENRODE
JOHN NAGLE
D.R. GOOD
D.R. GOOD
A. YEAGER
J. BORN
J. BORN
E.C. BROWN
J. LANTZY
CAMBRIA COUNTY
TOWNSHIP
BURNSIDE
ELDER TOWNSHIP
NO. 6 MINE
140 Acres MINEABLE
469,000 M/T Recoverable
RICH HILL COAL MINING CORPORATION
CRESSON, PENNSYLVANIA
MAP SHOWING
THE COAL LANDS & WORKINGS
OF
RICH HILL COAL MINING CORPORATION
IN THE
C-PRIME OR UPPER KITTANNING SEAM
LOCATED IN
SUSQUEHANNA & ELDER TOWNSHIPS, CAMBRIA COUNTY
&
BURNSIDE TOWNSHIP, CLEARFIELD COUNTY
SHOWING ADJACENT LANDS & WORKINGS
WORKINGS SHOWN TO FEBRUARY 15, 1967
SCALE 1" = 1000'