


LEGEND

- FREE COAL
- LEASED COAL
- MINED
- OUTLINE, MINEABLE COAL

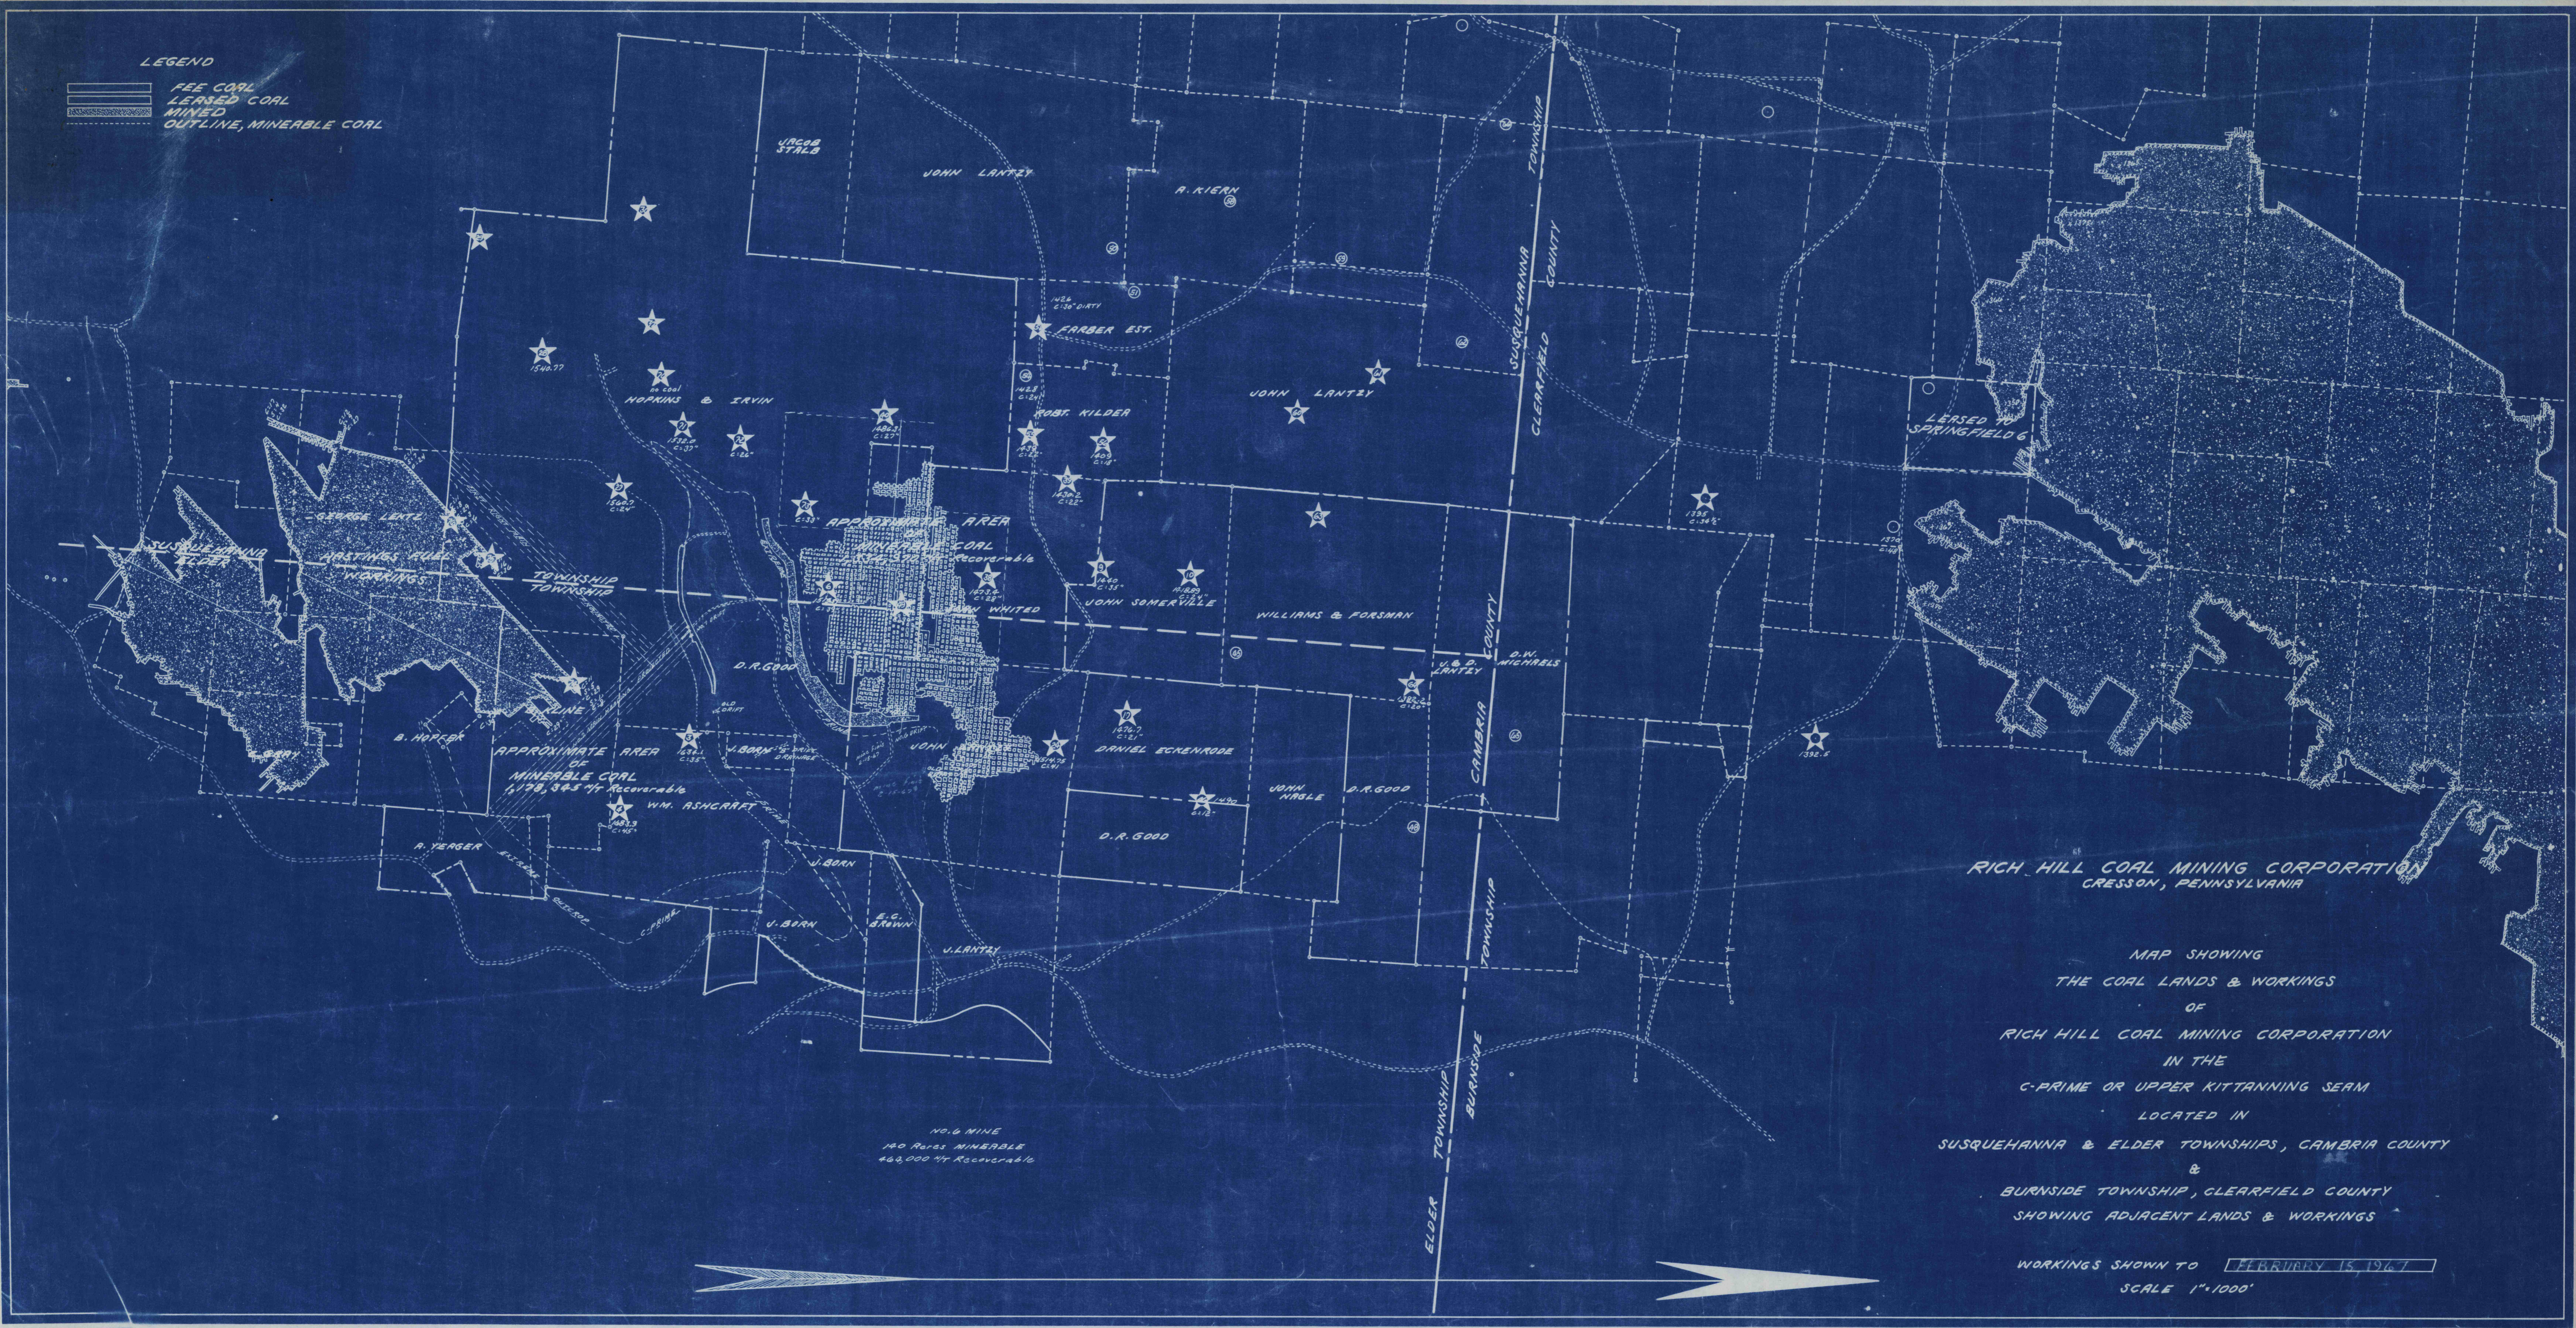


**RICH HILL COAL MINING CORPORATION**  
 GRESSON, PENNSYLVANIA

MAP SHOWING  
 THE COAL LANDS & WORKINGS  
 OF  
 RICH HILL COAL MINING CORPORATION  
 IN THE  
 C-PRIME OR UPPER KITTANNING SEAM  
 LOCATED IN  
 SUSQUEHANNA & ELDER TOWNSHIPS, CAMBRIA COUNTY  
 &  
 BURNSIDE TOWNSHIP, CLEARFIELD COUNTY  
 SHOWING ADJACENT LANDS & WORKINGS

WORKINGS SHOWN TO FEBRUARY 15, 1967  
 SCALE 1"=1000'

NO. 6 MINE  
 140 Acres MINEABLE  
 463,000 MT Recoverable

C-PRIME COAL SEAM SECTIONS

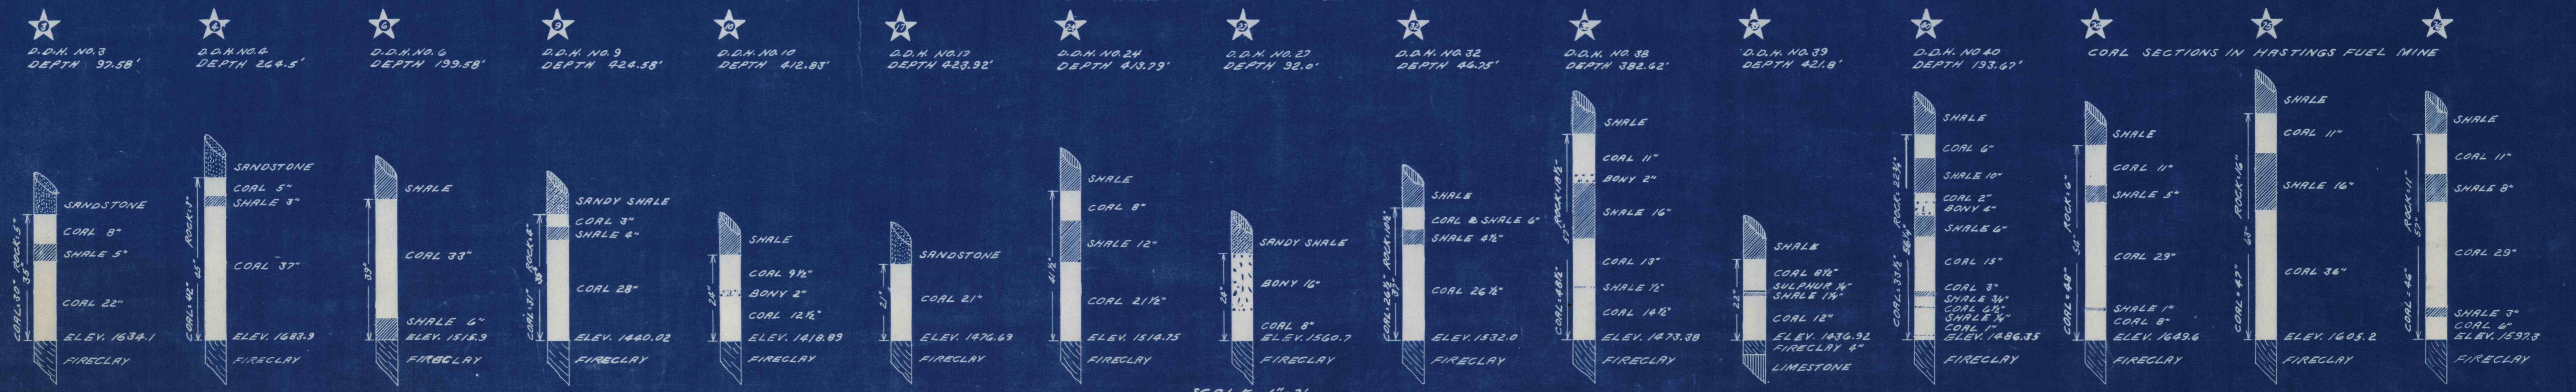

SCALE 1"=2'