


RICH HILL COAL MINING CORPORATION
 CRESSON, PENNSYLVANIA

MAP SHOWING
 THE COAL LANDS & WORKINGS
 OF
 RICH HILL COAL MINING CORPORATION
 IN THE
 12" OR LOWER FREEPORT SEAM
 LOCATED IN
 SUSQUEHANNA & ELDER TOWNSHIPS, CAMBRIA COUNTY
 &
 BURNSIDE TOWNSHIP, CLEARFIELD COUNTY
 SHOWING ADJACENT LANDS & WORKINGS

LEGEND

- SEE COAL FORMERLY G.T.C.C.
- 1946 LEASE, GROUP 3
- 1946 LEASE, GROUP 4
- 1951 SUPPLEMENTAL LEASE
- 1956 SUPPLEMENTAL LEASE
- LEASED TO ARYS COAL COMPANY
- MINED OUT AREAS
- DIAMOND DRILL HOLES

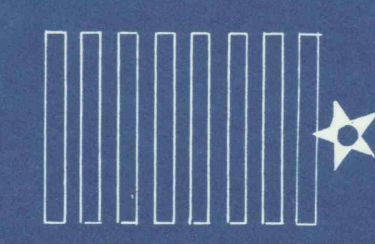

SCALE 1" = 1000'
 WORKINGS SHOWN TO

