


FARBER ESTATE

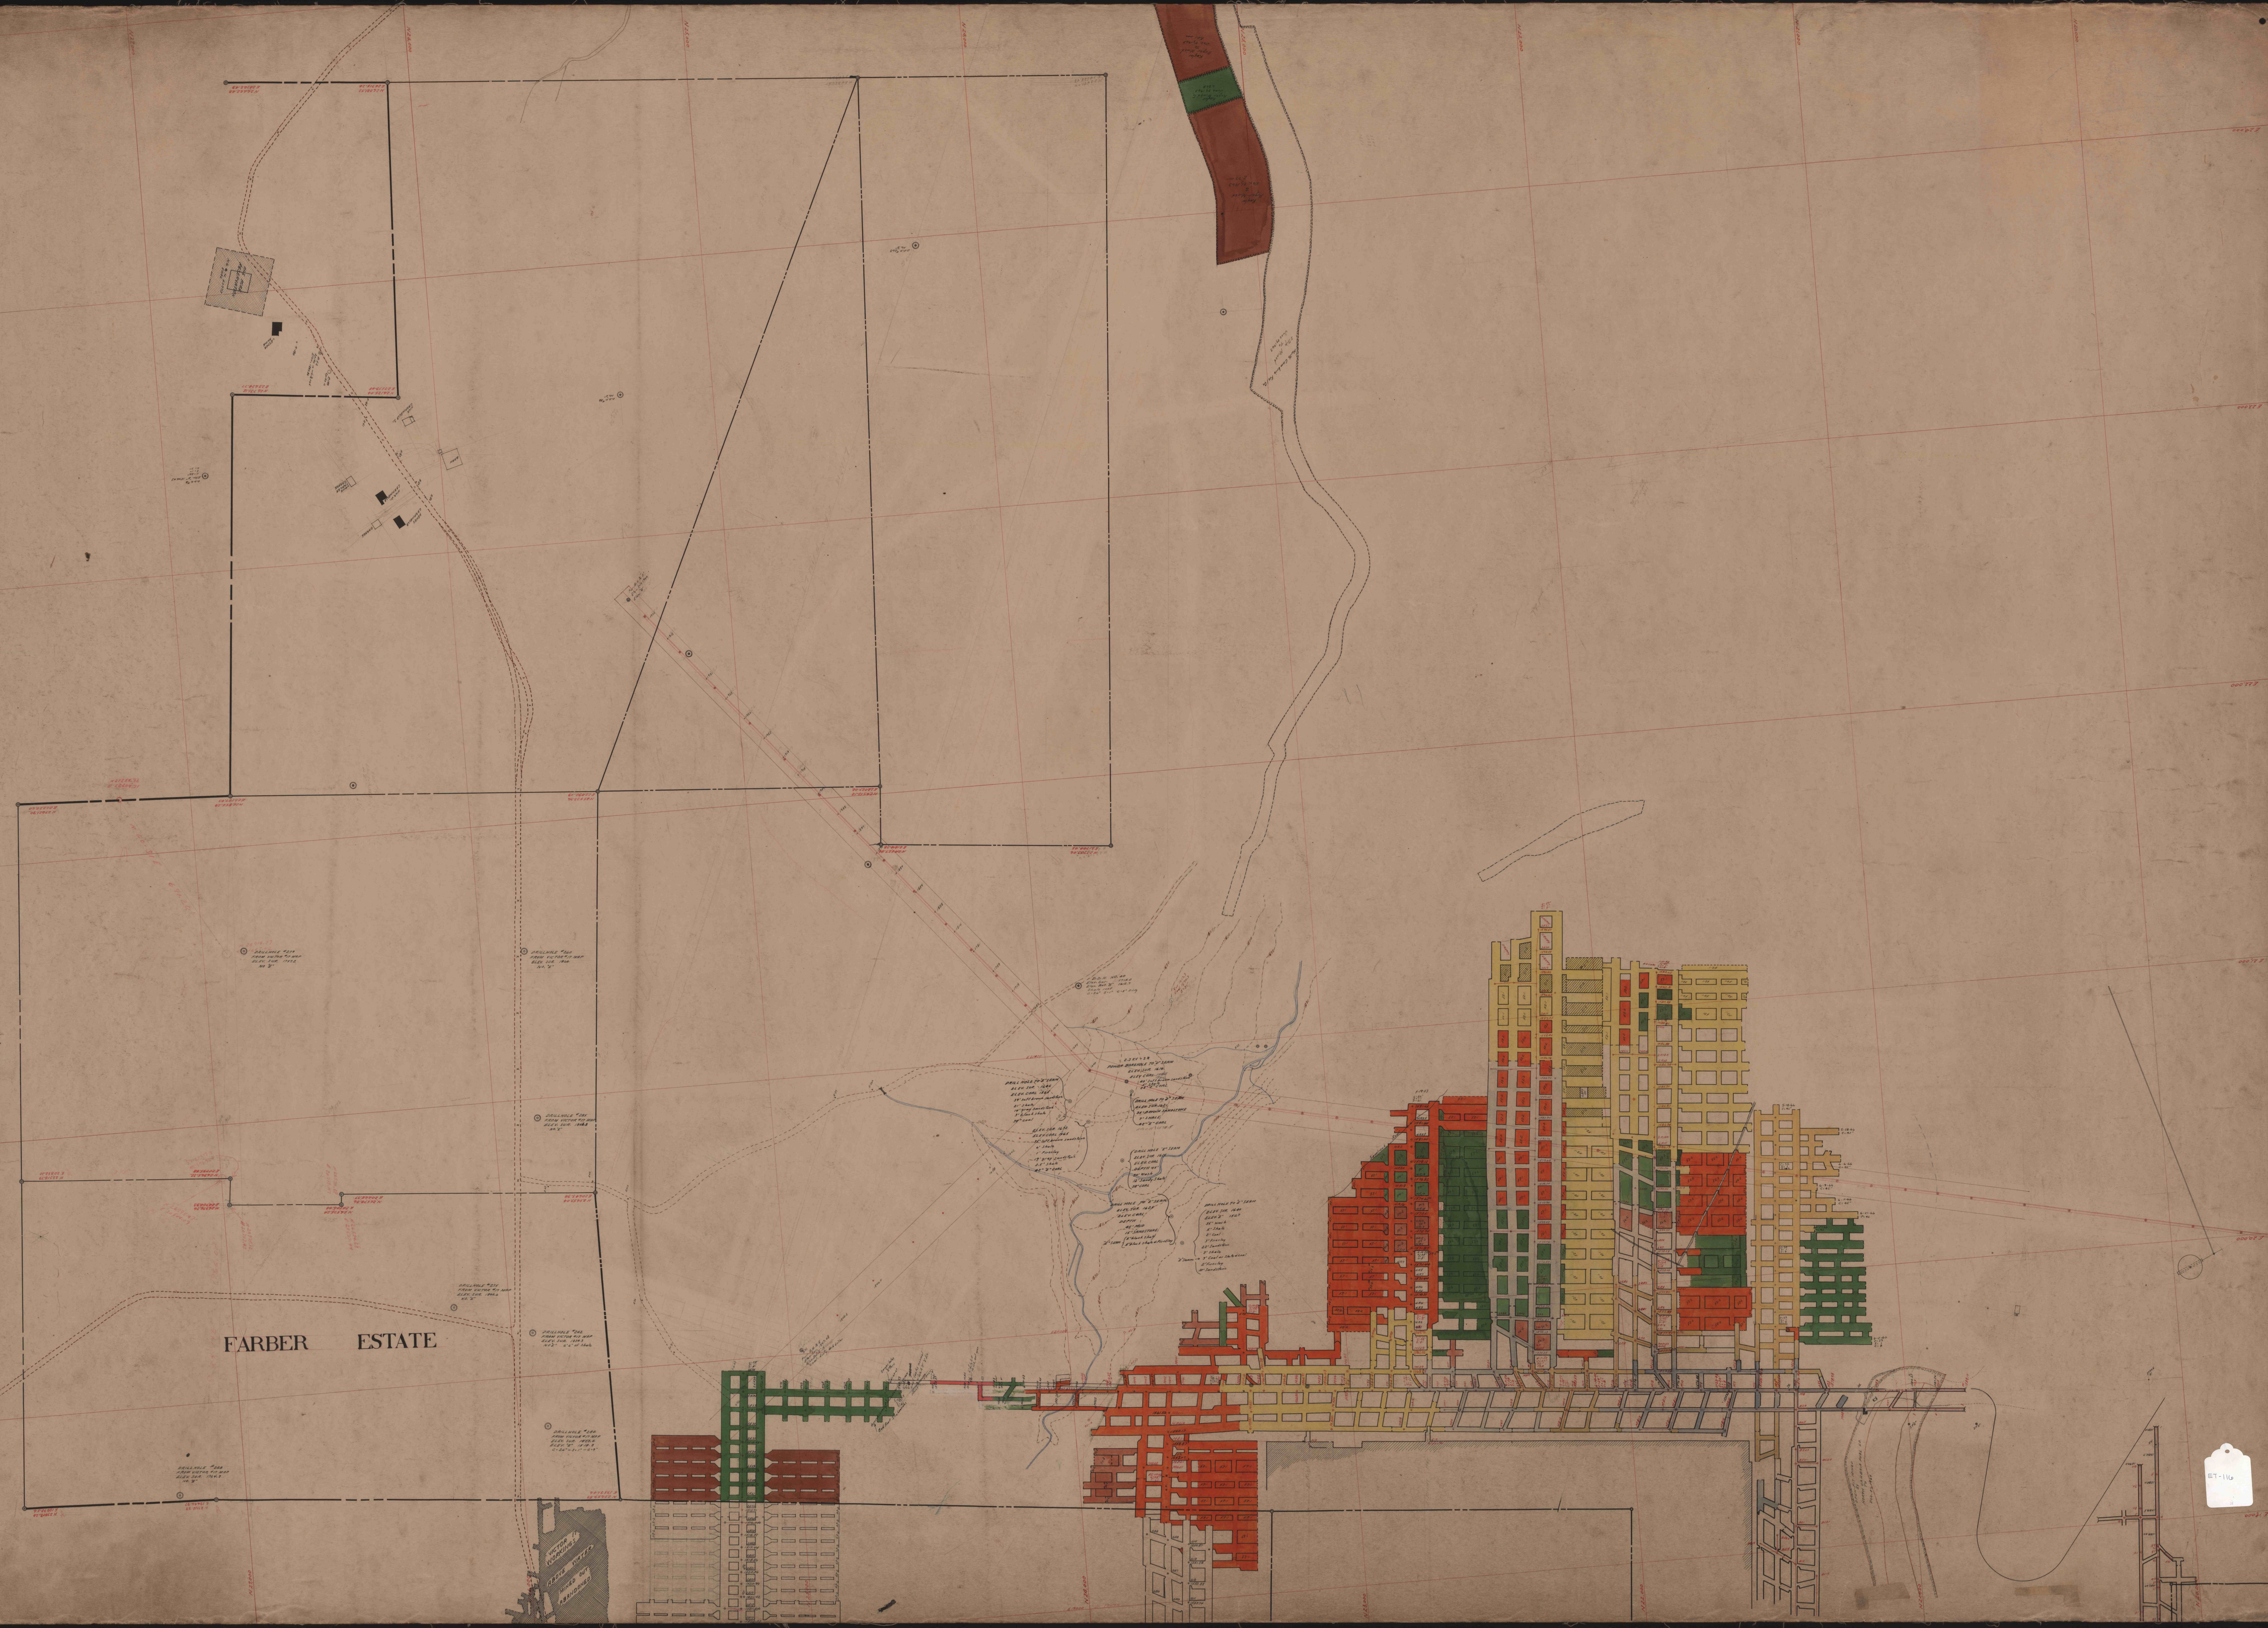

ET-116