


NORTH BRANCH CONEMAUGH RESERVOIR OF SUMMIT WATER ST

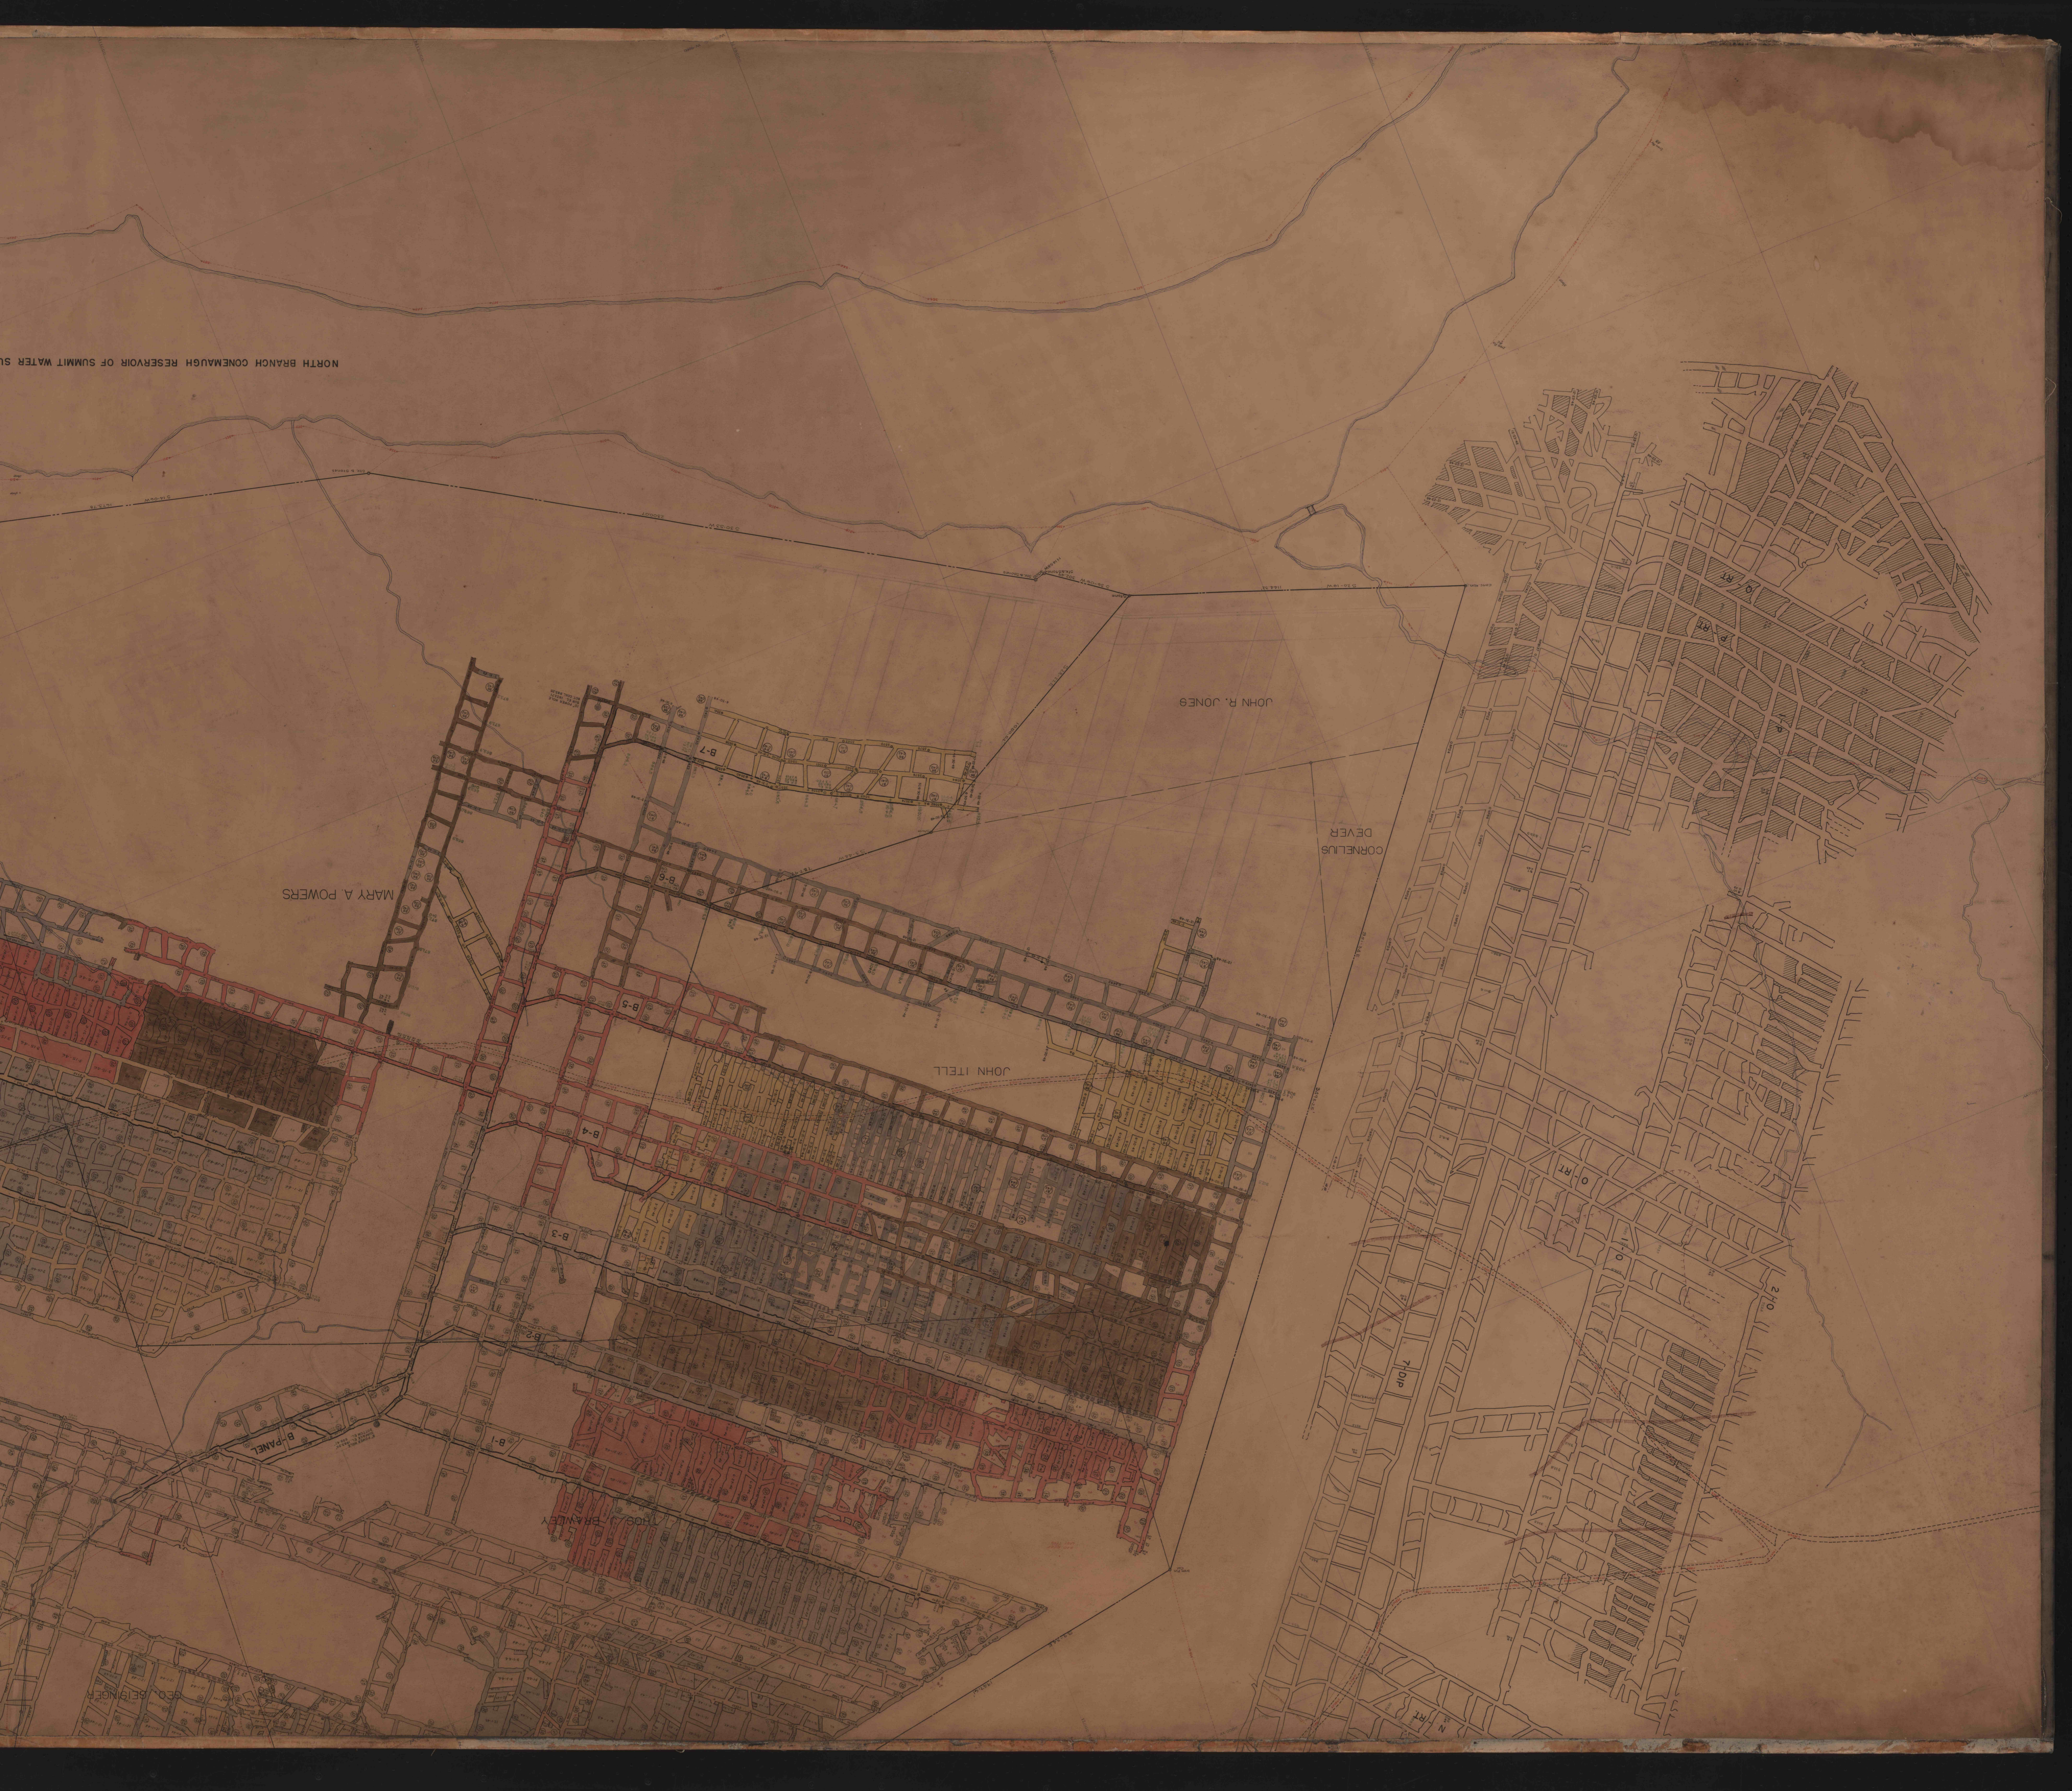

JOHN R. JONES

CORNELLUS DEVER

JOHN ITELL

MARY A POWERS

JOHN BRANLEY

B-PAMEL

B-7

B-6

B-5

B-4

B-3

B-2

B-1

710P

210

O RT

10

N RT

CO BEING