


MINING PROJECTIONS SHANNOPIN PROPERTY ONLY

Shannopin Mine

LEGEND

Unit 1	Mining Shown Thru	5-31-98
Unit 2	Mining Shown Thru	9-30-98
Unit 3	Mining Shown Thru	11-30-98
Unit 4	Mining Shown Thru	6-30-97

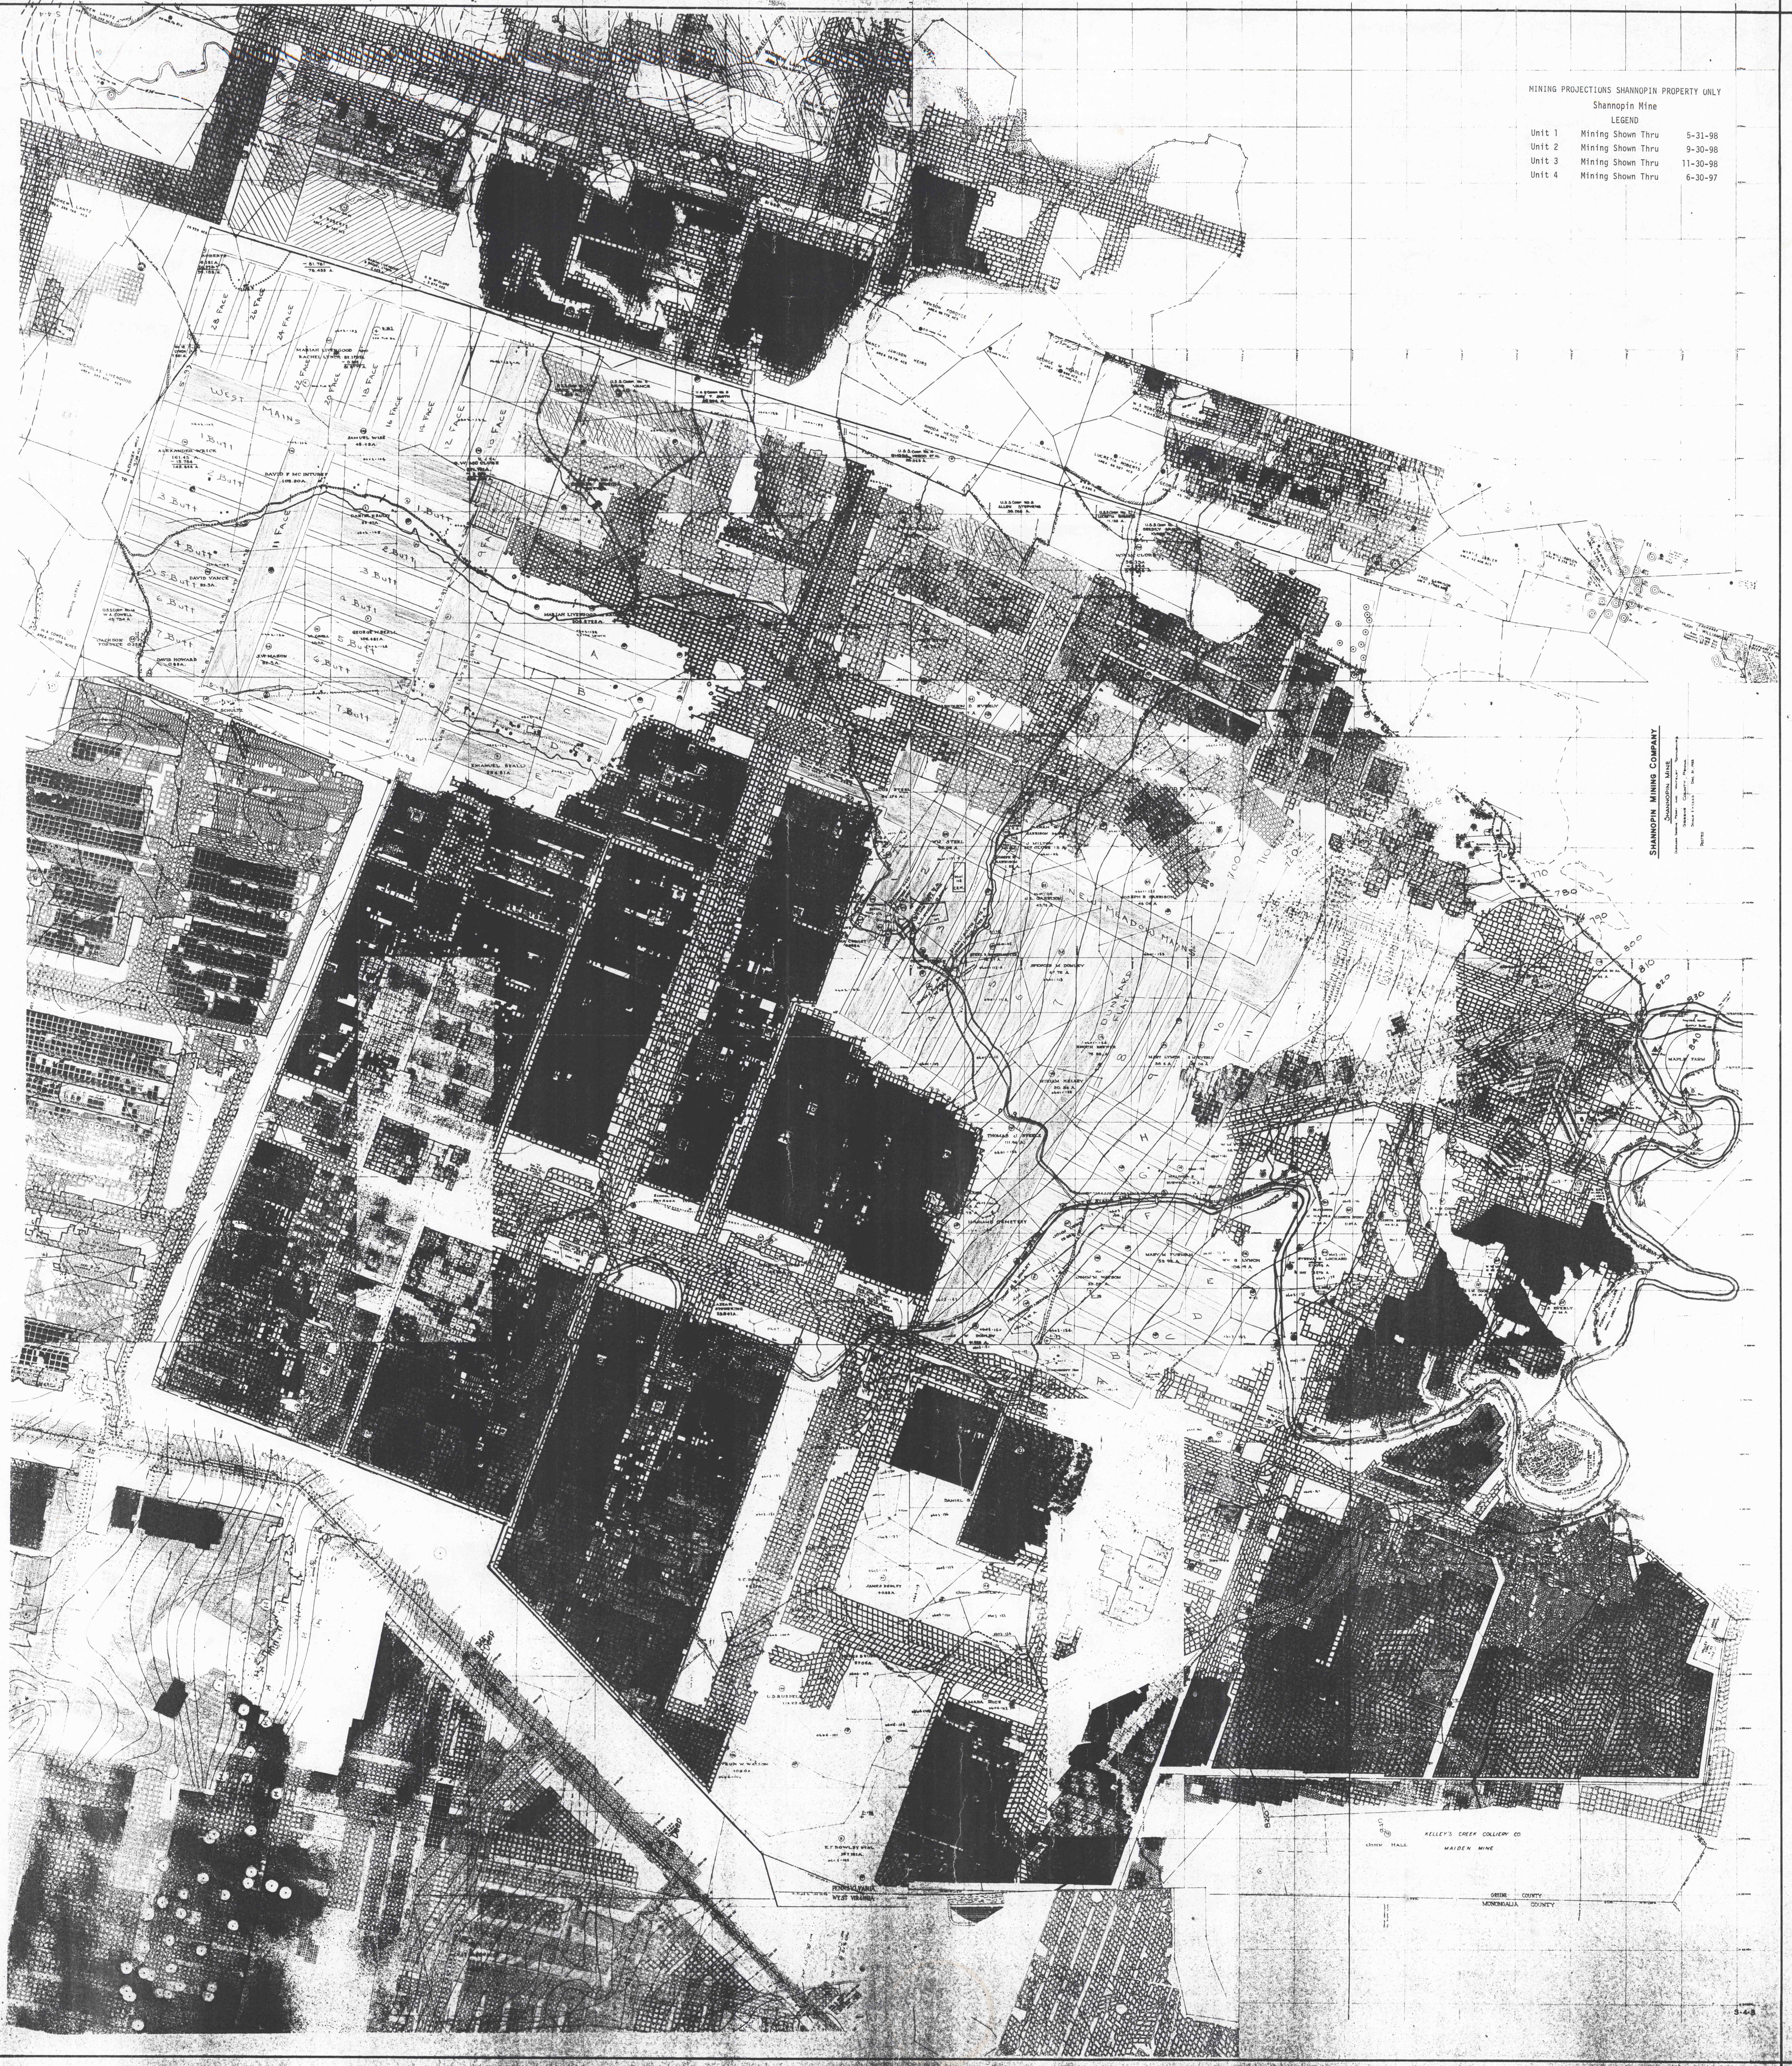

SHANNOPIN MINING COMPANY  
SHANNOPIN MINE

KELLEY'S CREEK COLLIERY CO.  
CHINA HALL  
MAIDEN MINE  
ORISE COUNTY  
MORGANTHA COUNTY