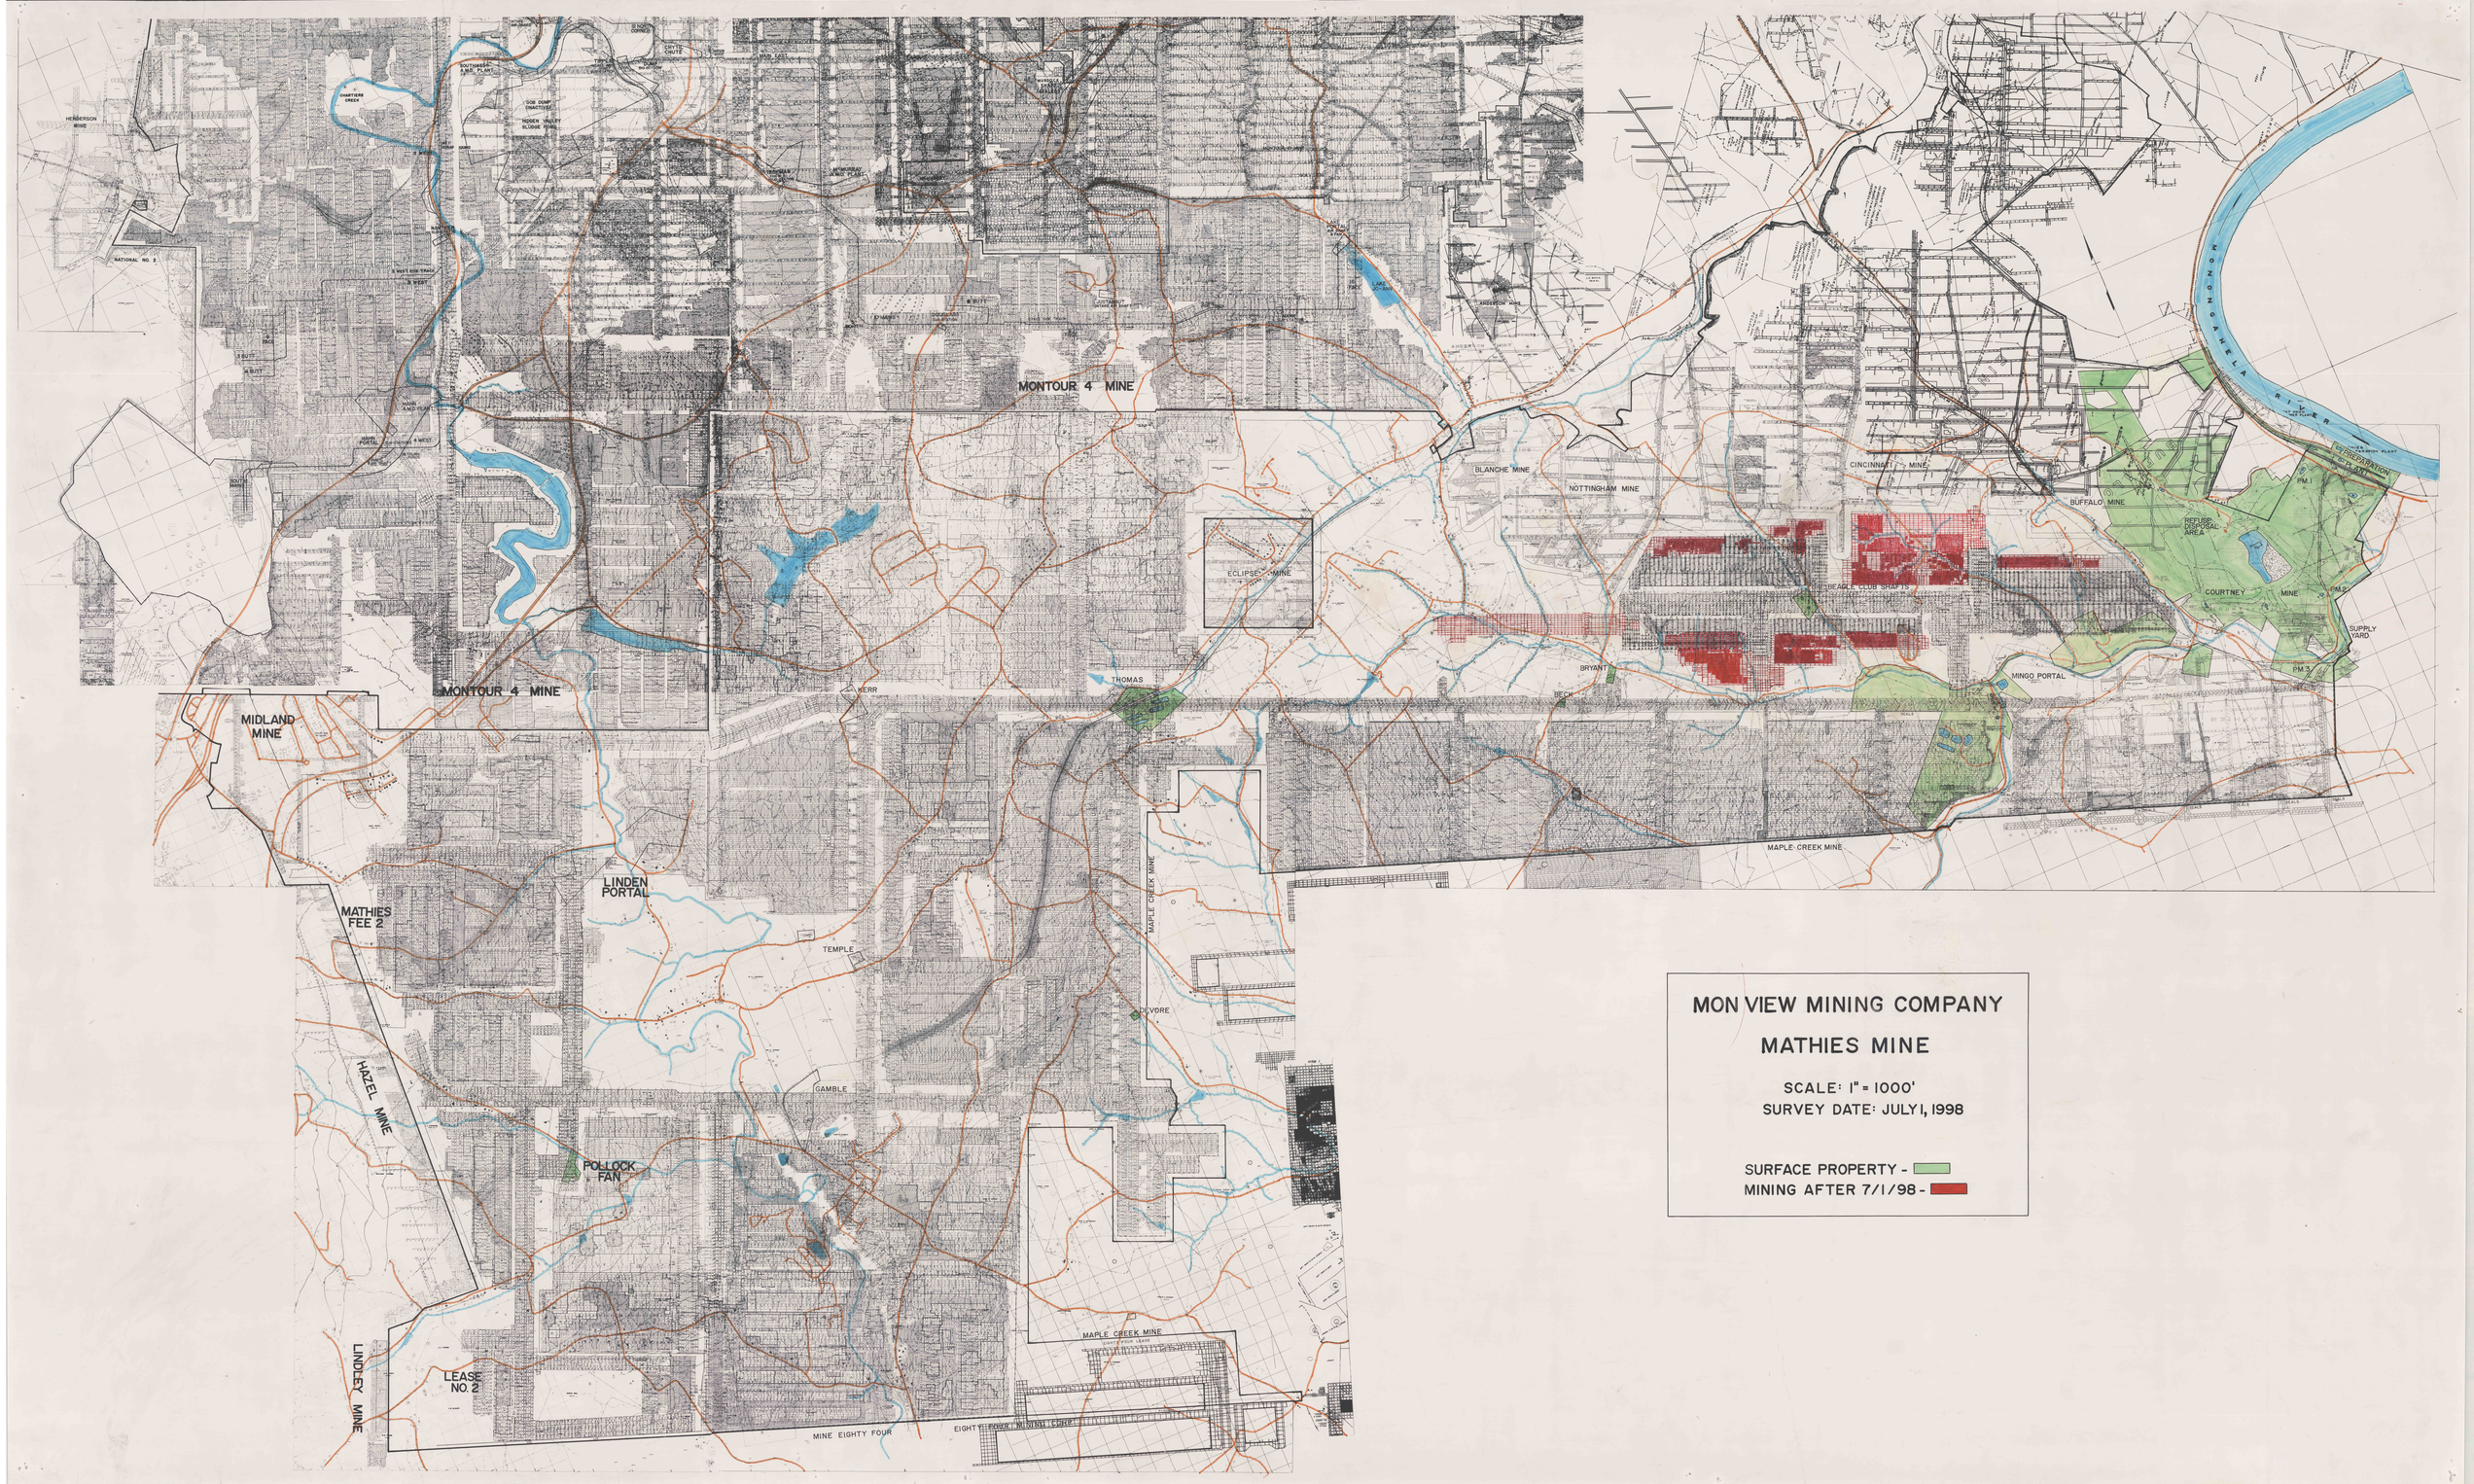
MON VIEW MINING COMPANY
MATHIES MINE
SCALE: 1" = 1000'
SURVEY DATE: JULY 1, 1998
SURFACE PROPERTY -
MINING AFTER 7/1/98 -
MONONGAHELA RIVER
MONTOUR 4 MINE
MIDLAND MINE
MATHIES FEE 2
HAZEL MINE
LINDLEY MINE
LEASE NO. 2
LINDEN PORTAL
POLLOCK FAN
MINE EIGHTY FOUR
MAPLE CREEK MINE
ECLIPSE MINE
BLANCHE MINE
NOTTINGHAM MINE
CINCINNATI MINE
BUFFALO MINE
BEABLE CLUB SHAFTS
COURTNEY MINE
REFUSE DISPOSAL AREA
SUPPLY YARD
MINGO PORTAL
THOMAS
KERR
BRYANT
BECK
TEMPLE
GAMBLE
DEVORE
HENDERSON MINE
NATIONAL NO. 2
PREPARATION PLANT