

J O A N N A
D U N P H Y

P A T T E R S O N
H E I R S

S W I R E S
E S T A T E

S A M U E L
B E R G E R


G I L M O R E
H I L D E B R A N D

A . A . S T E P H E N S
E S T A T E



MAP SHOWING
WERTZ BROS. COAL CO.
 ACCO NO 1

SITUATE IN
 Dean Township, Cambria County, Pennsylvania
 SCALE: 1 IN. = 100 FT. DATE OF SURVEY: NOV. 2, 1964

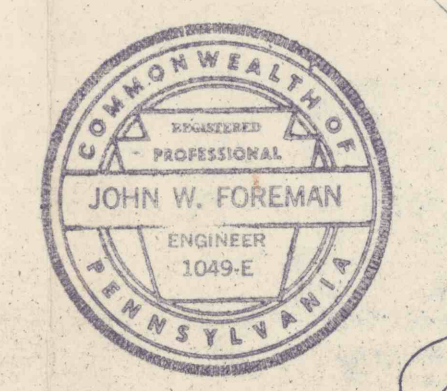

LEWIS L. GWIN - CONSULTING ENGINEERS
 ALTOONA, PENNA.
 JOHN W. FOREMAN, MINING ENGINEER

#5
 5-24-64
 C.C.