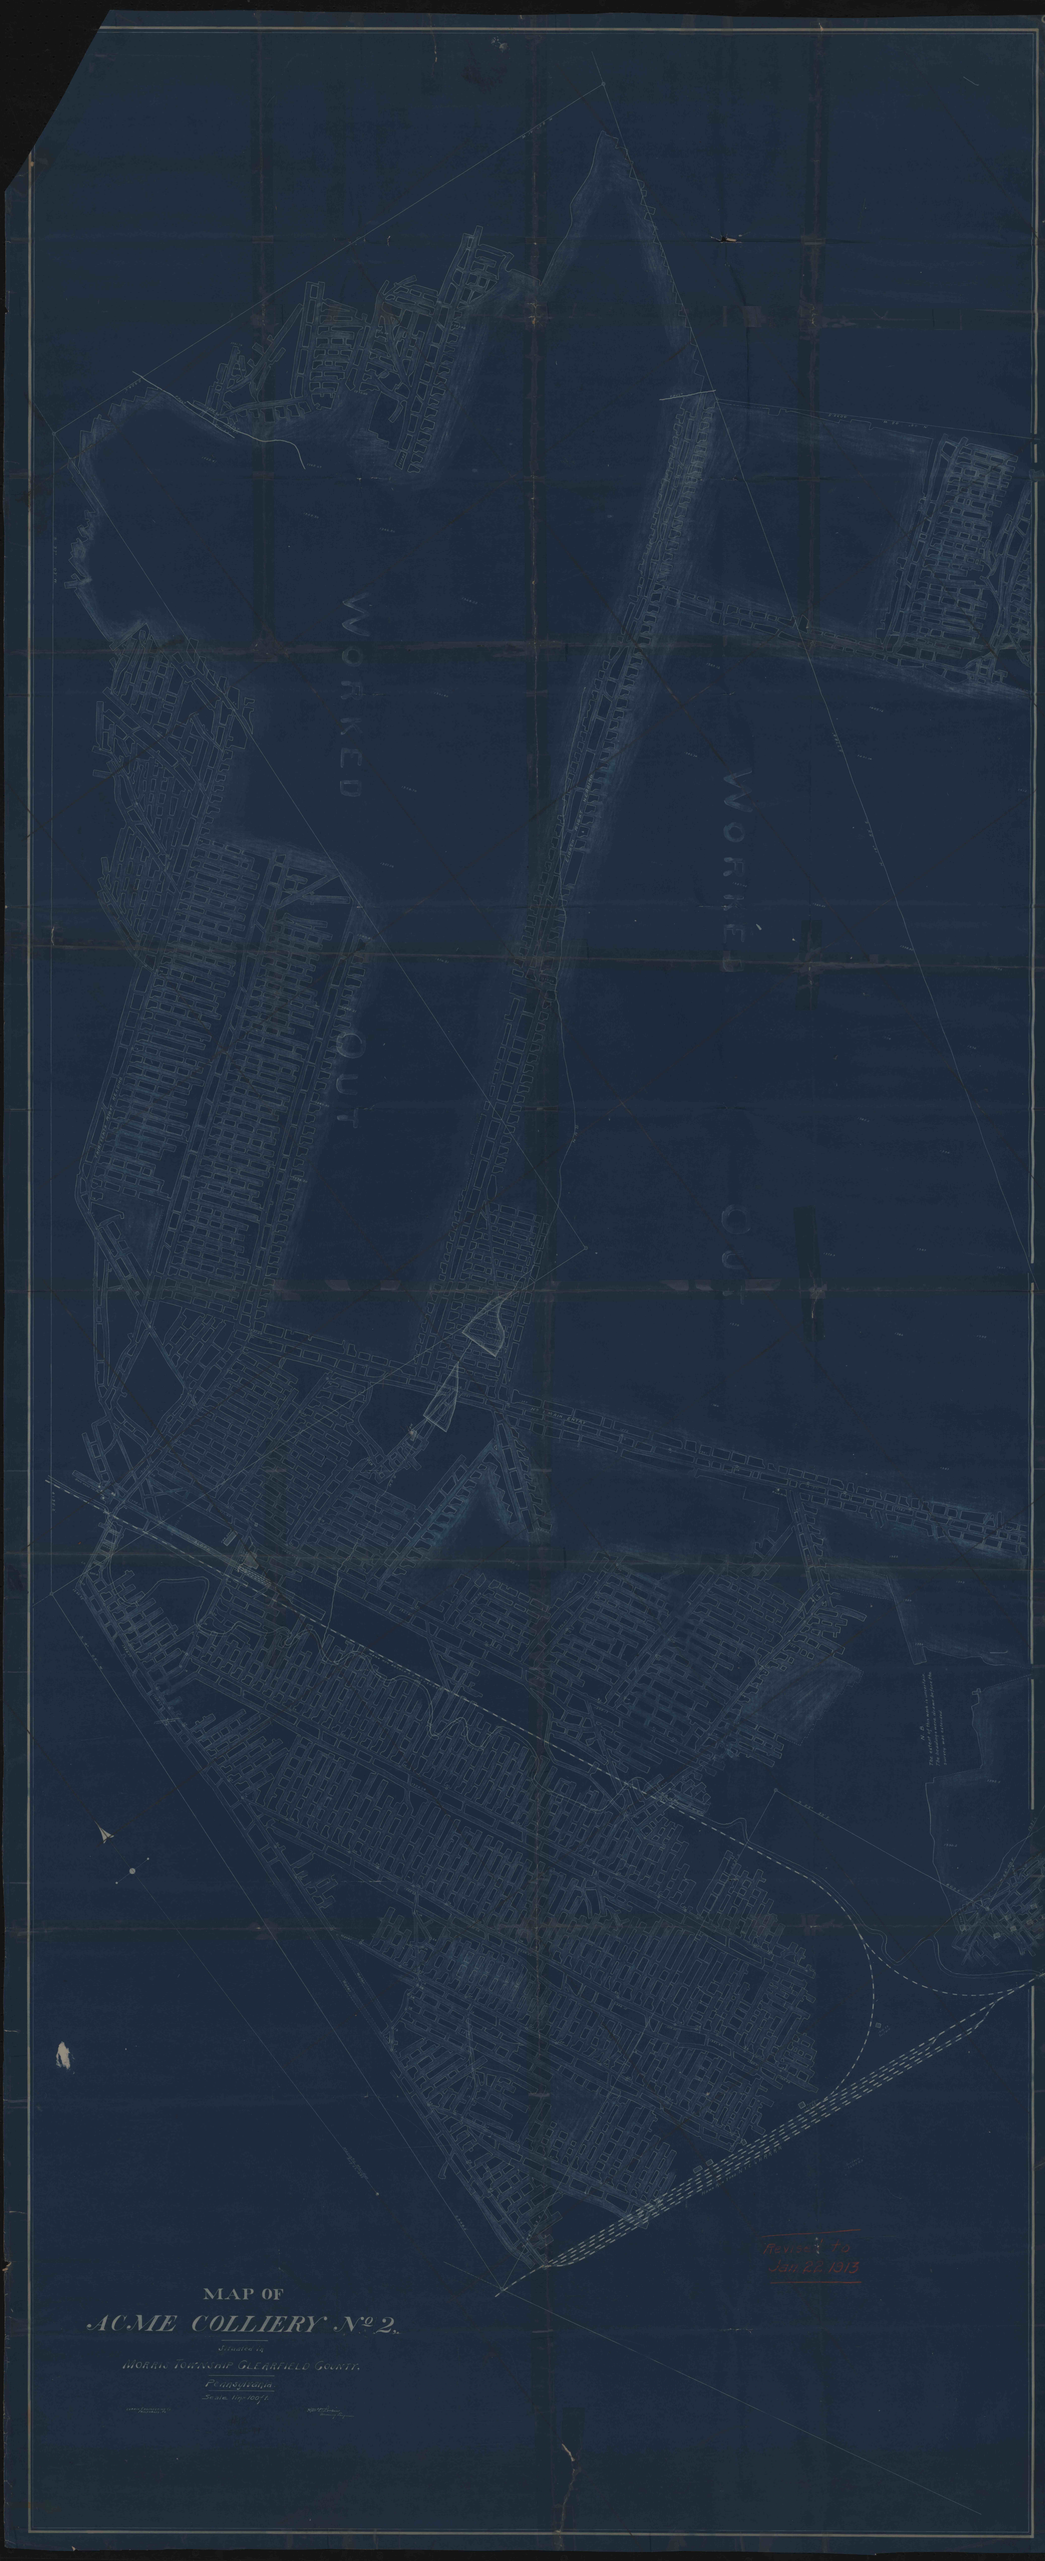

MAP OF

ACME COLLIERY No 2.

Situated in


Pennsylvania

Scale 1 in = 100 ft.

Revised to
