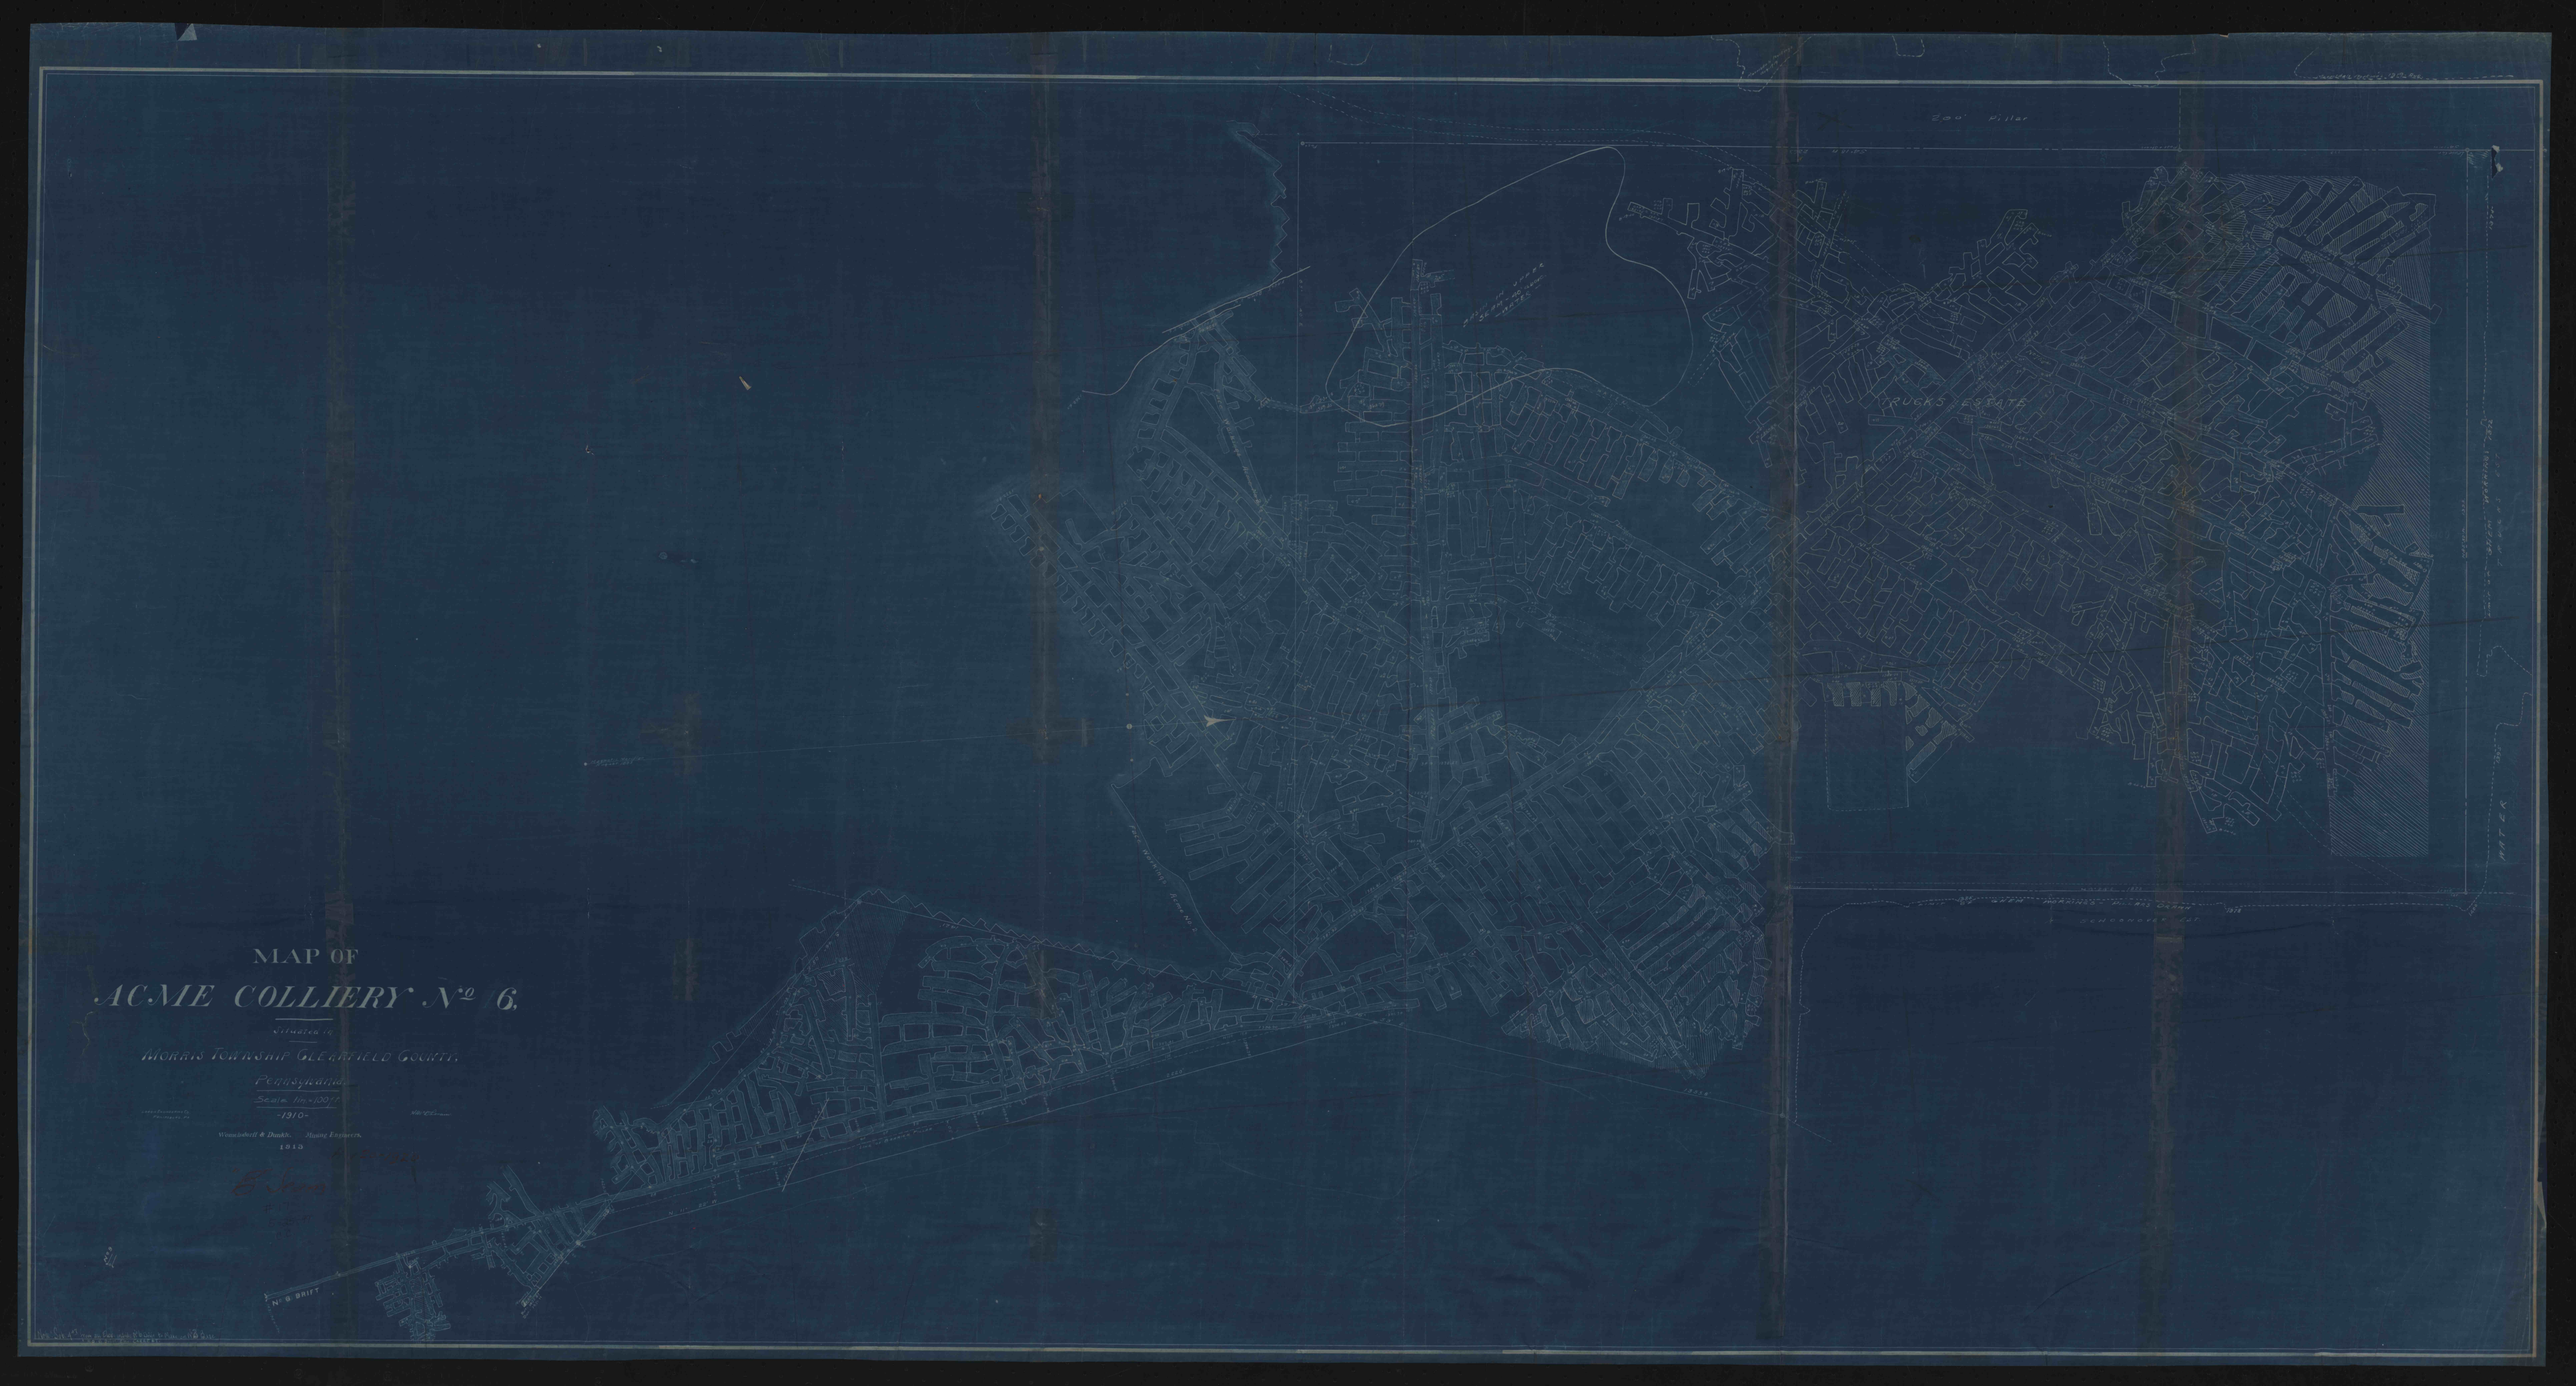
MAP OF
ACME COLLIERY No 6.
Situated in
MORRIS TOWNSHIP CLEARFIELD COUNTY,
Pennsylvania.
Scale 1in.=100ft.
1910
Wooselsdorff & Dunkle. Mining Engineers.
1913
TRUCKS ESTATE
No 6 DRIFT