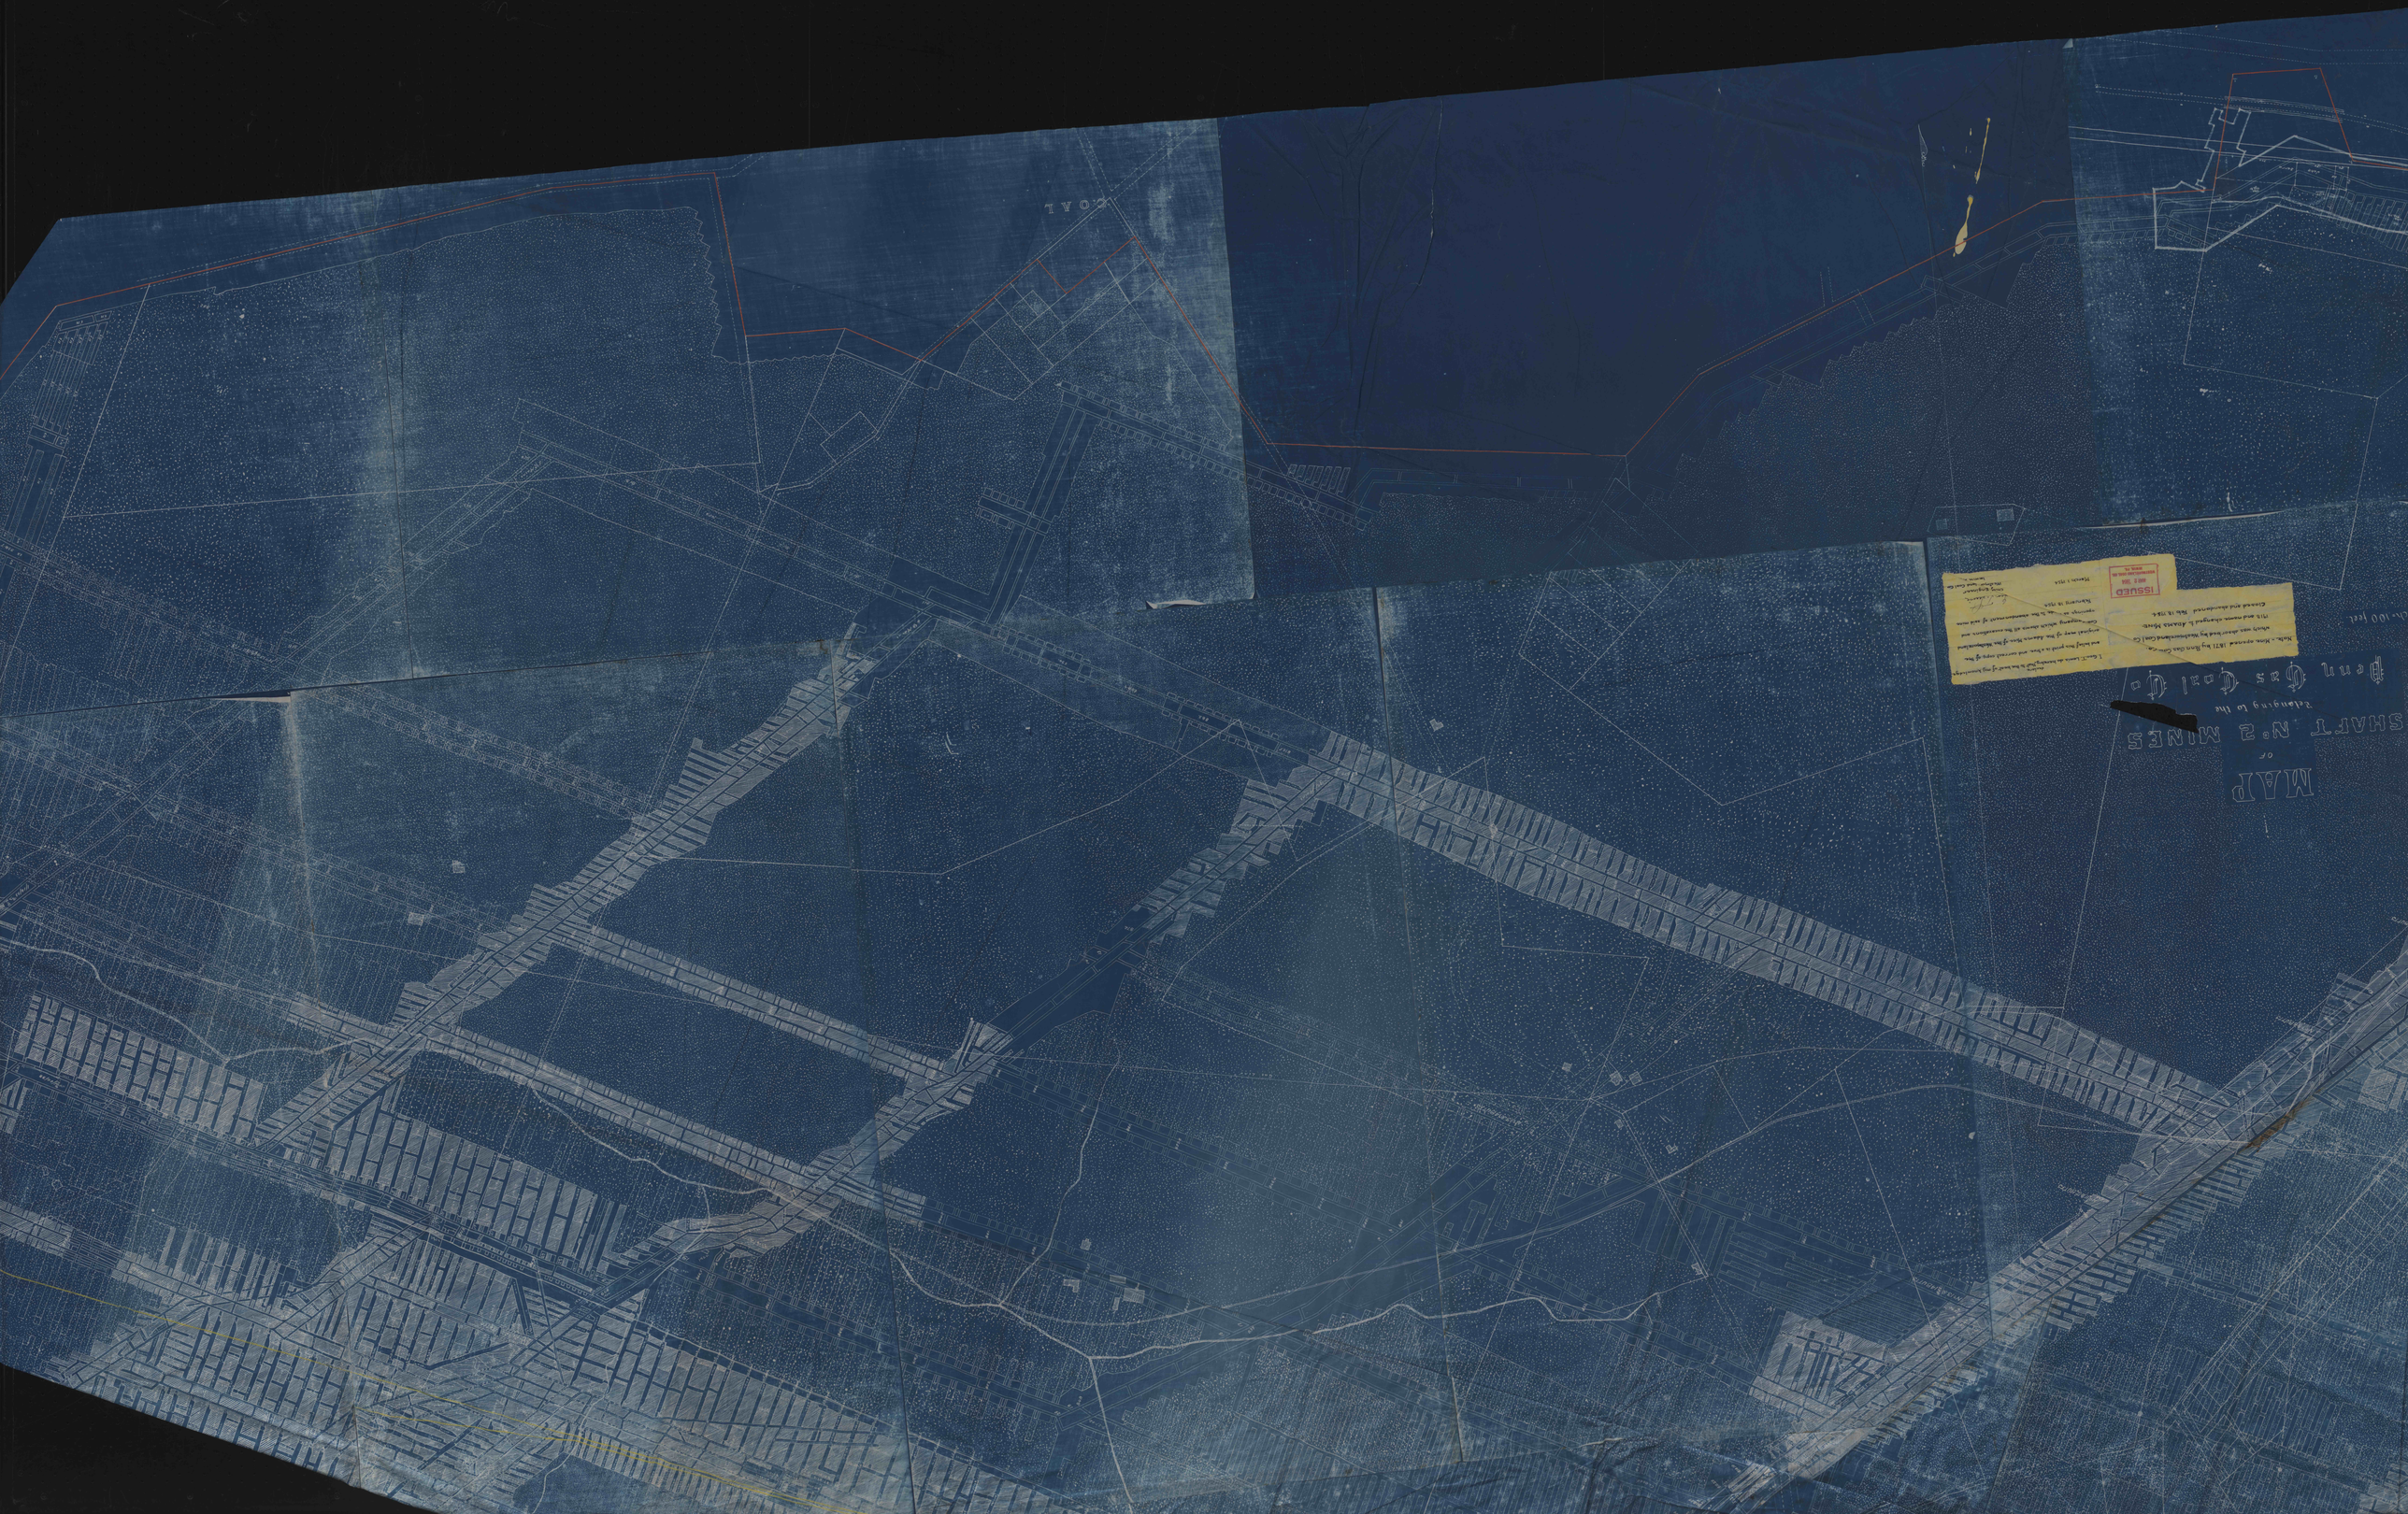
MAP
of
SHAFT N°2 MINES
Belonging to the
Penn Gas Coal Co
Scale - Three inches to the mile
Surveyed in 1871 by Thomas Cole Civil Engineer
Surveyed and drawn by Edward L. Adams Mining
Engineer in 1874
Examined and authenticated Feb. 18 1874
Mining Engineer
Pittston, Pa.
ISSUED
MAR 2 1874
MINING ENGINEER
PITTSTON, PA.
COAL