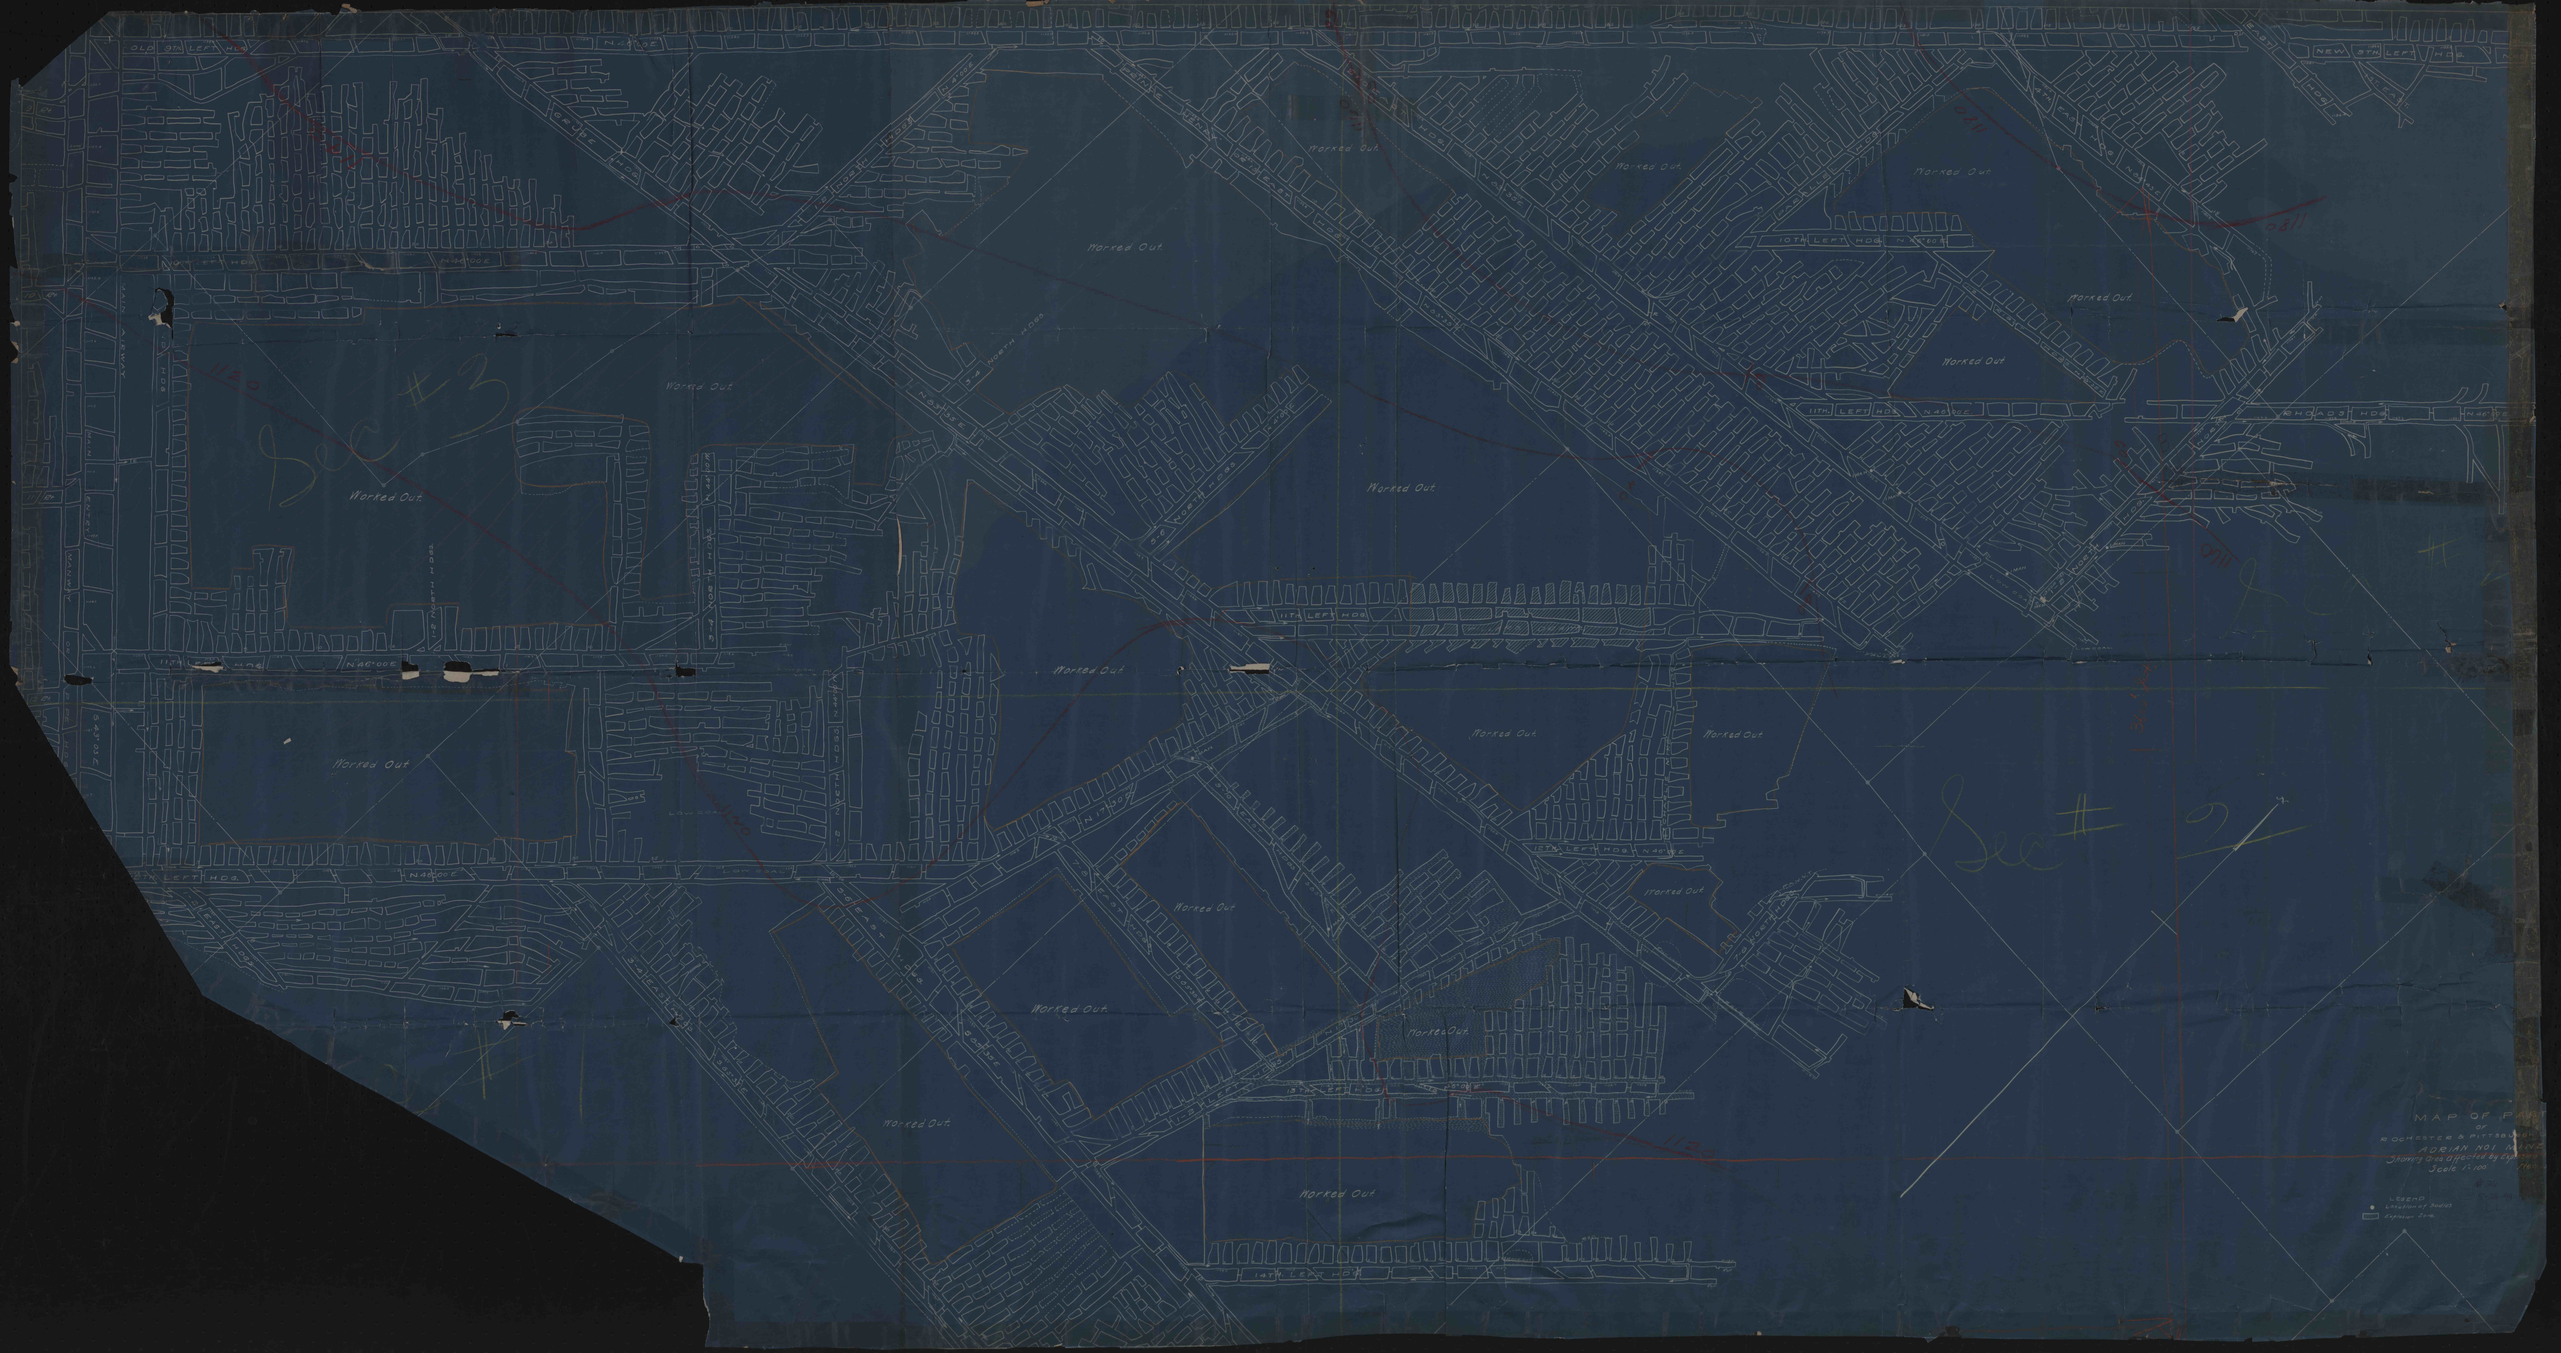
Worked Out
Worked Out
Worked Out