



SONMAN No. 2 "B" SEAM MINE

WASHINGTON TOWNSHIP


CAMBRIA COUNTY PA.

SCALE 1"=100'

REVISED 6-30-1967

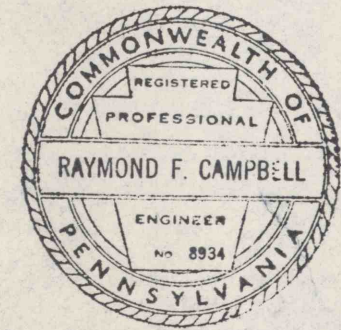 


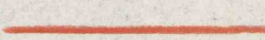
#29
5-25-99
C.C.

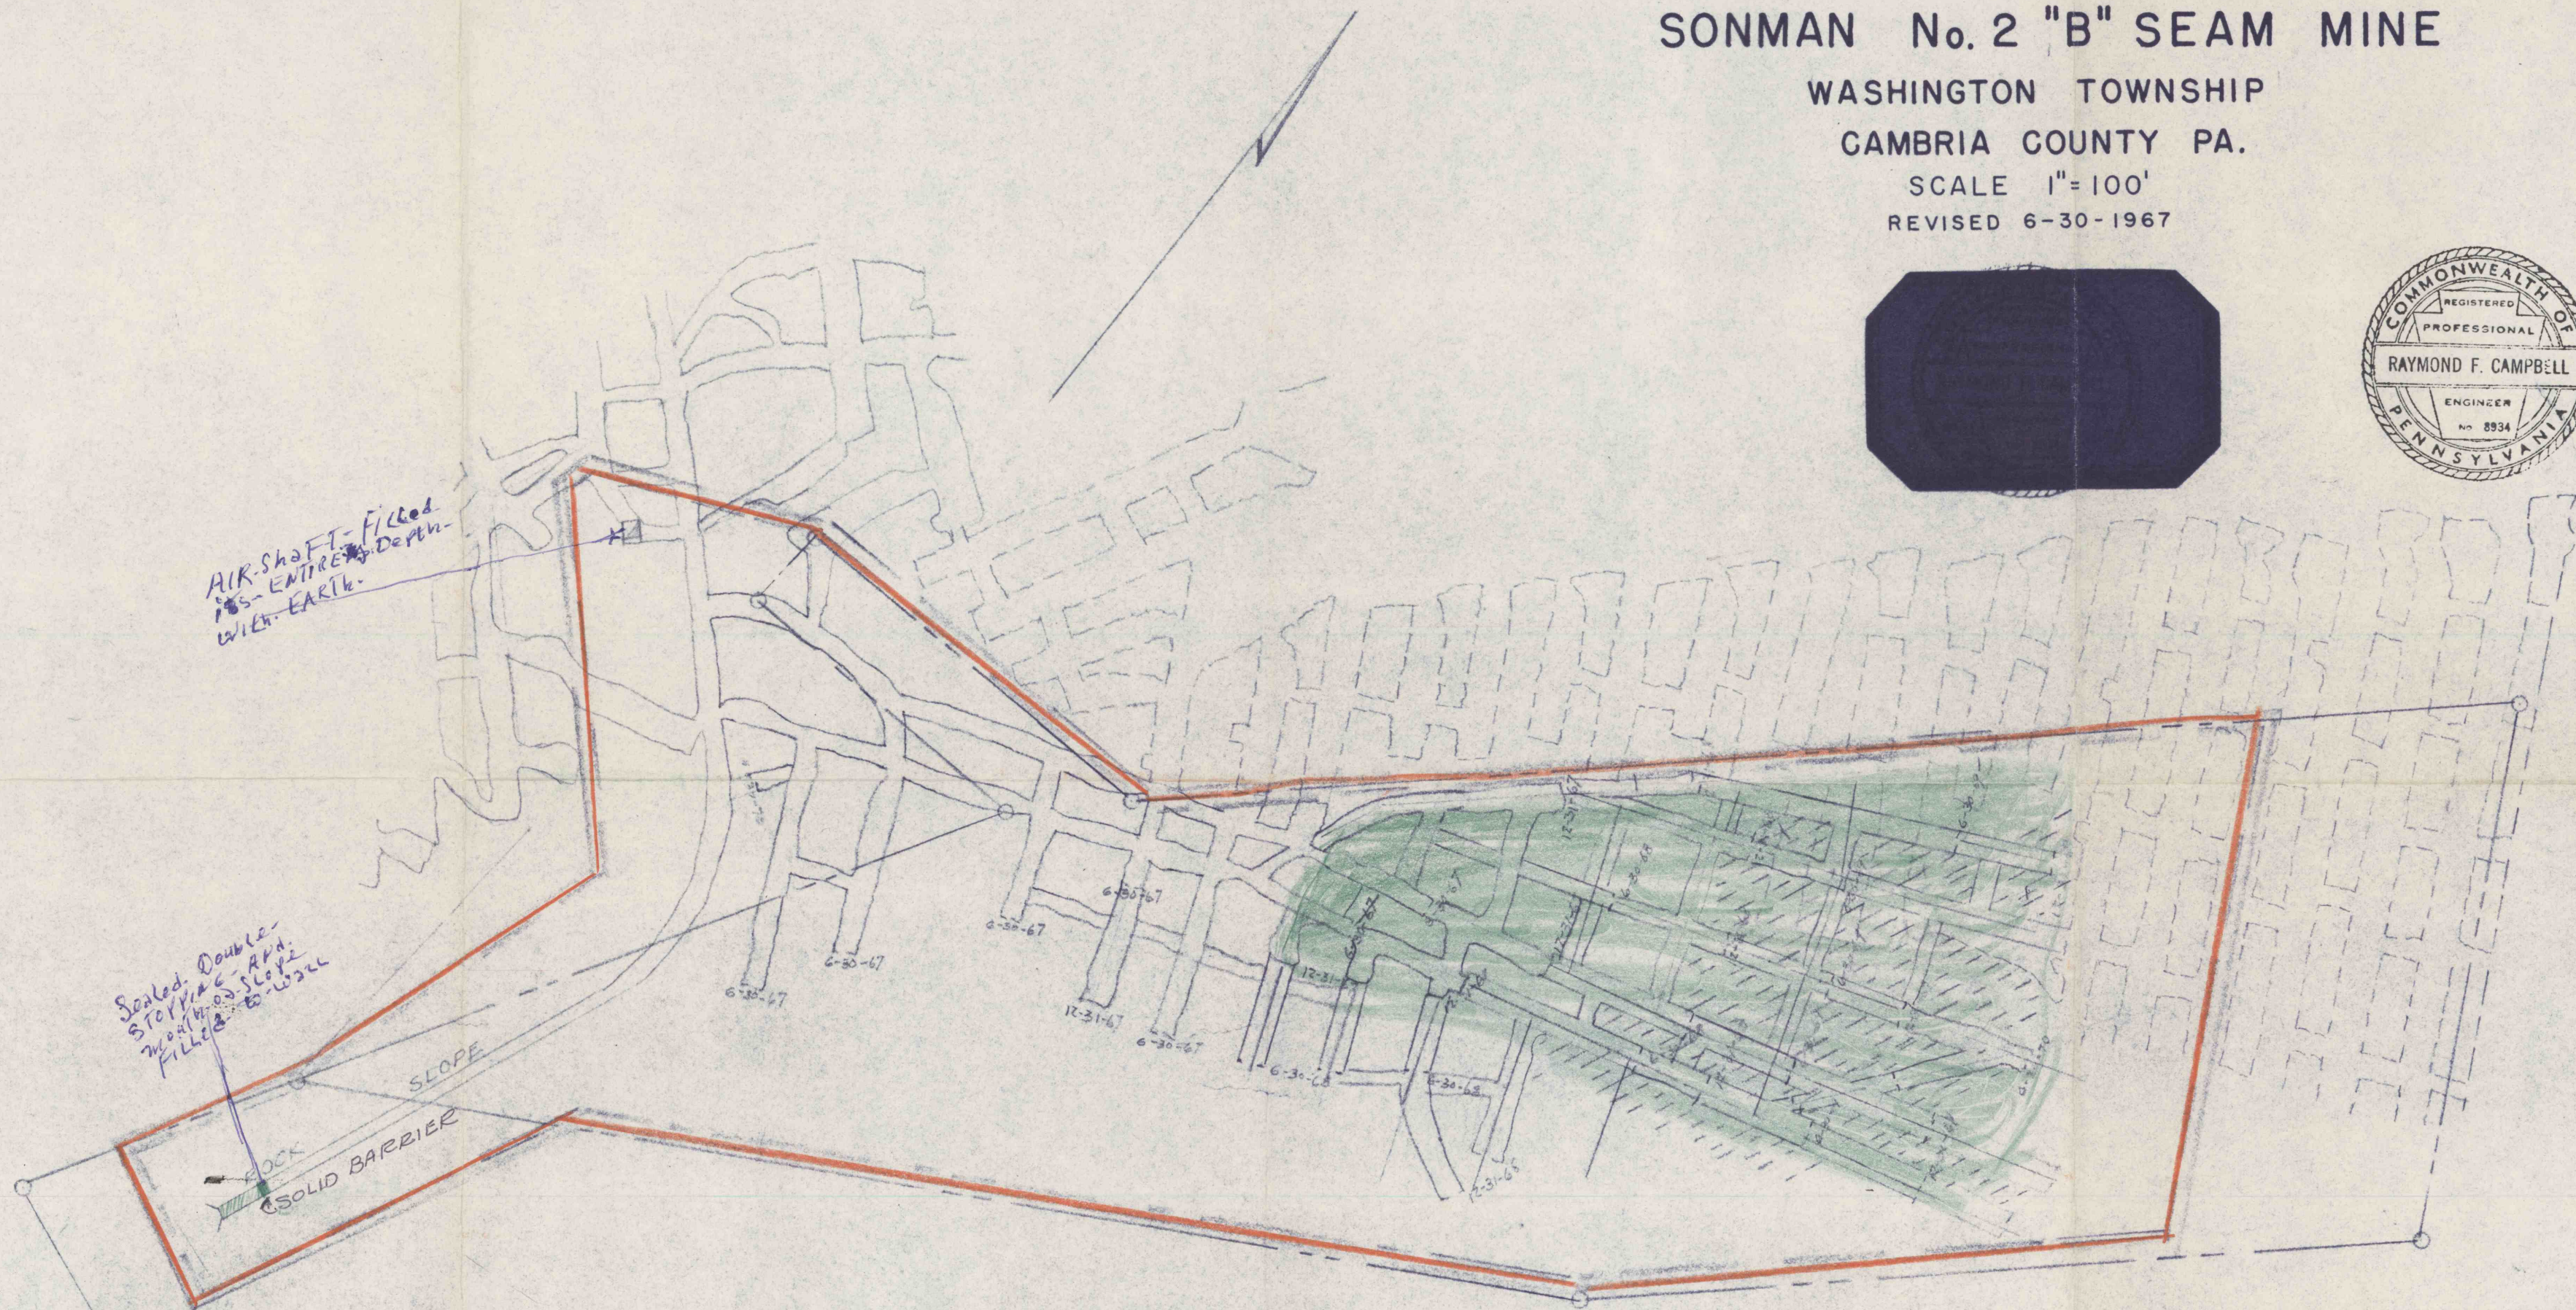


LEGEND

BOUNDARIES OF SURFACE

MINING OPERATIONS COMPLETED  FINAL 3-5-71

PROPOSED OPERATIONS UNDER PERMIT 

PROPOSED WORK NEXT SIX MONTHS 

PERMIT No. 286-1