


SAMUEL CORNMAN

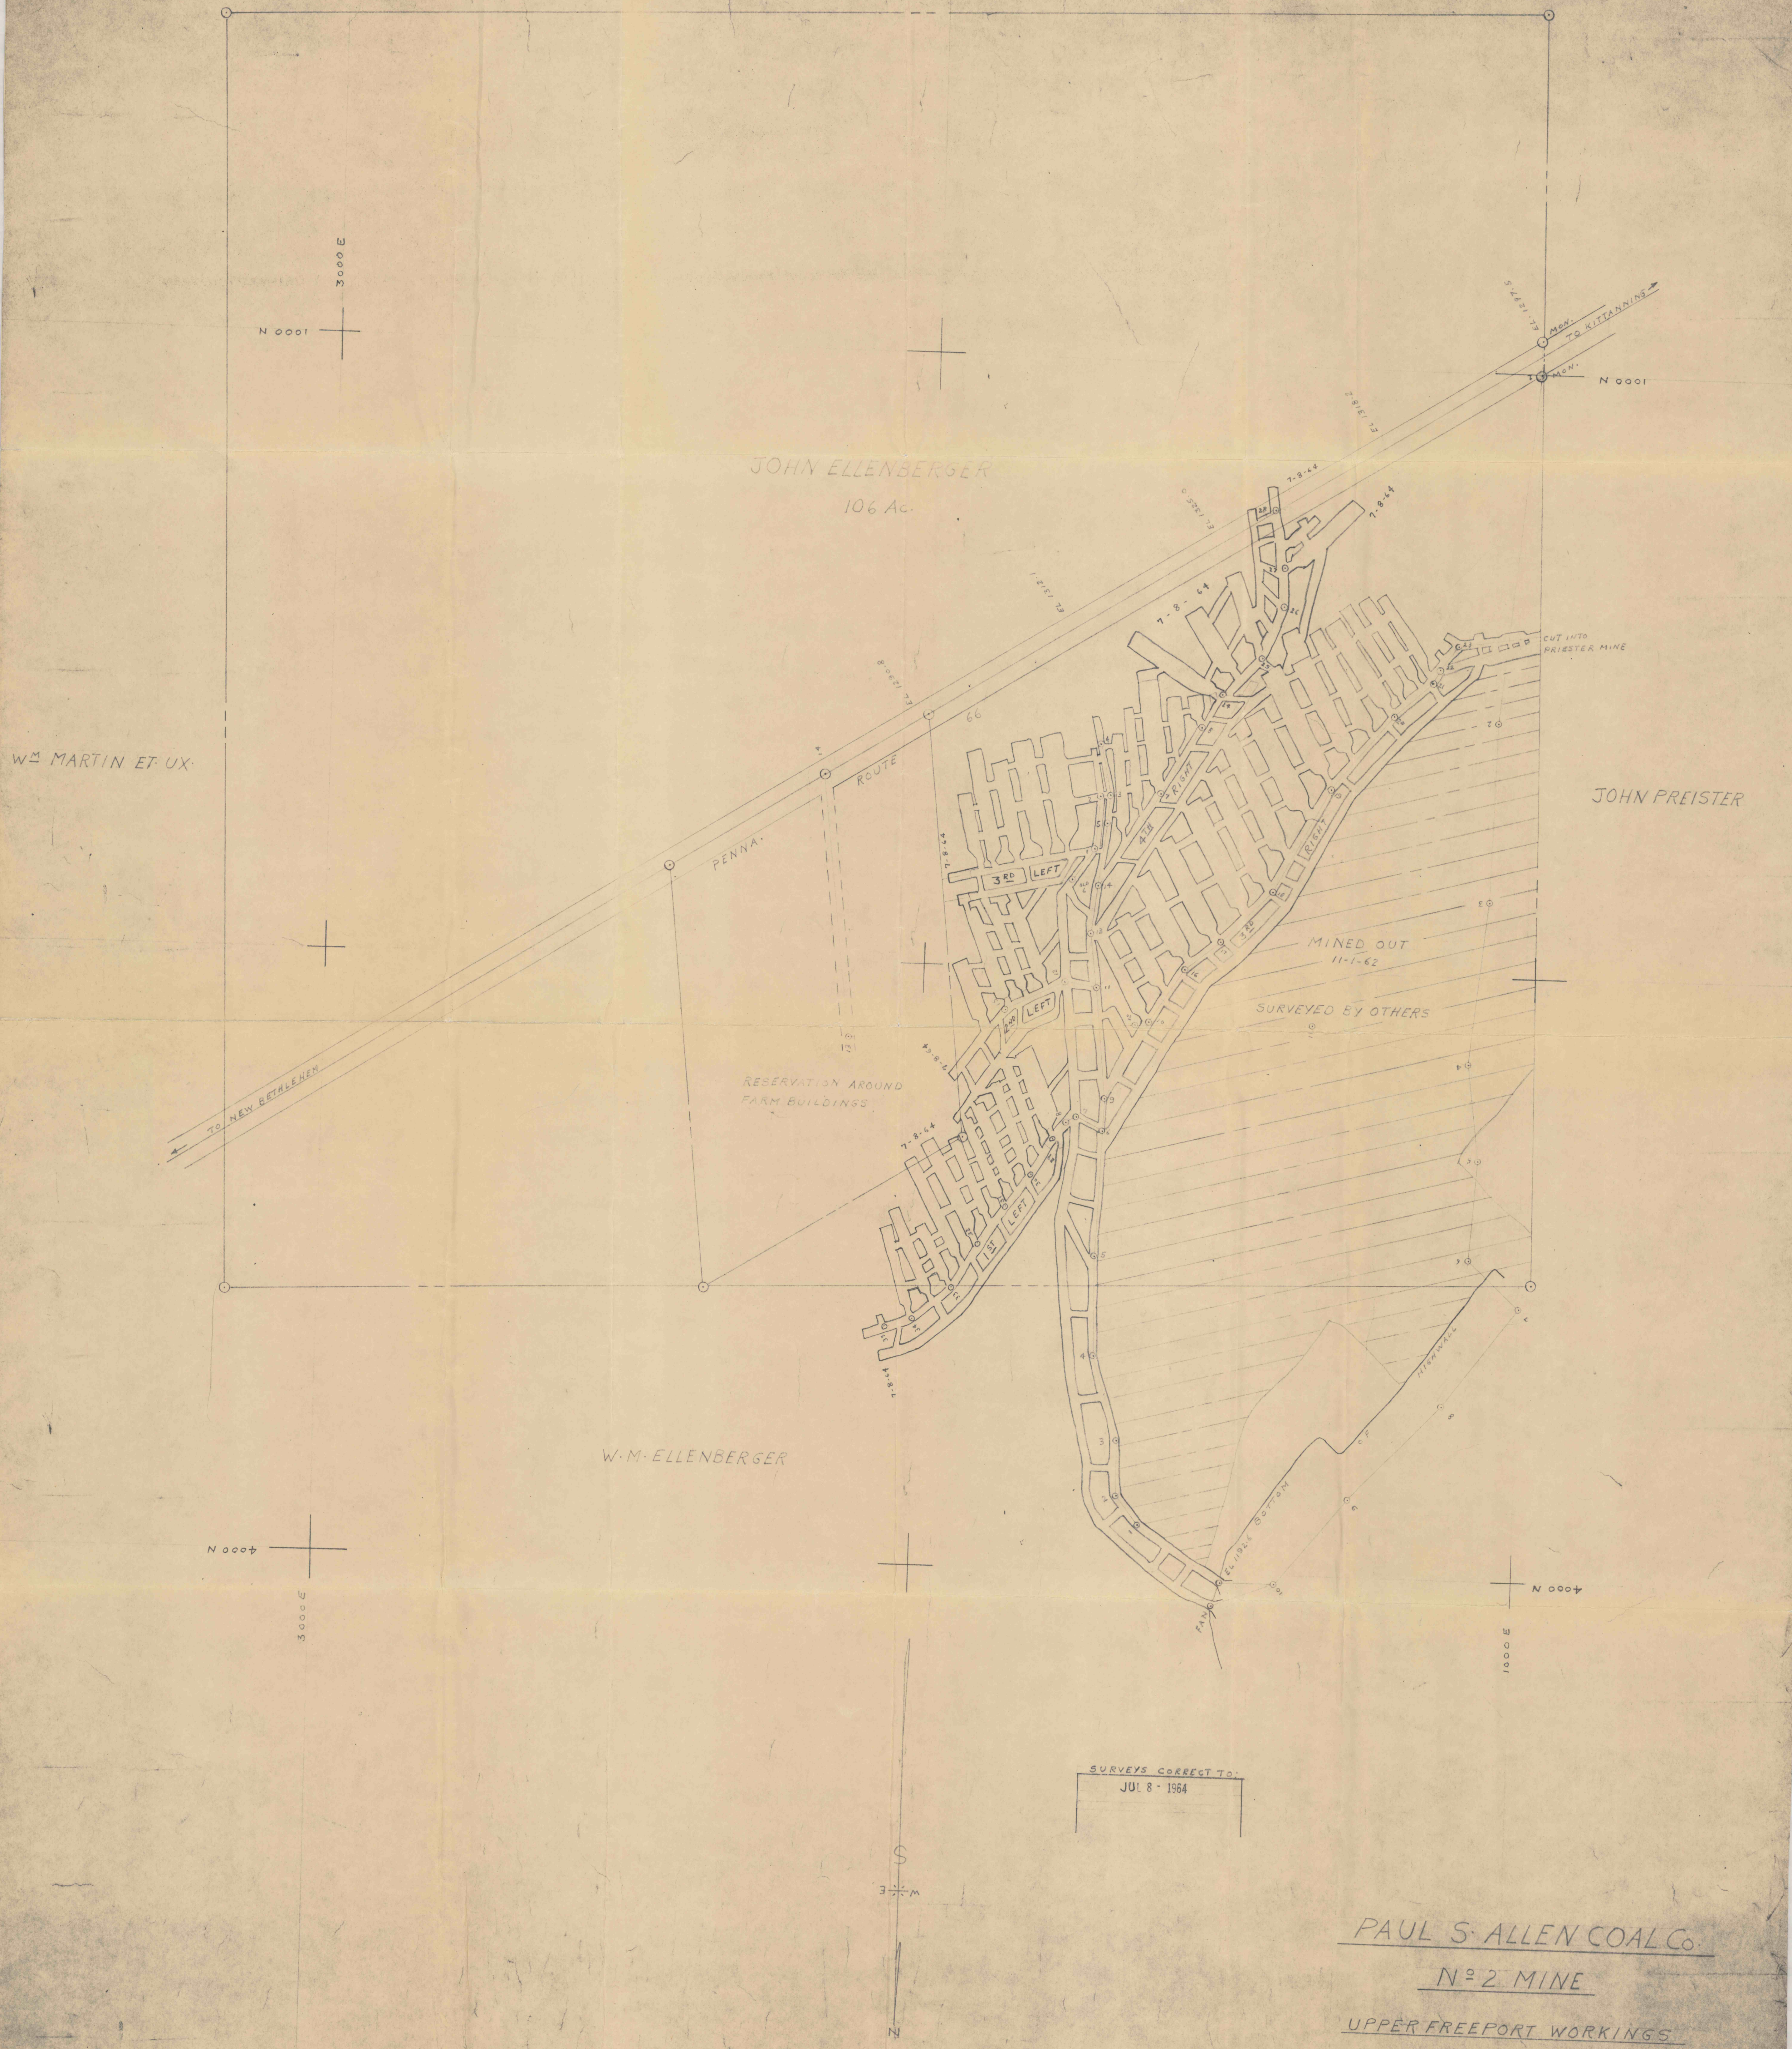

W^M MARTIN ET UX

JOHN ELLENBERGER
106 Ac.

JOHN PREISTER

W.M. ELLENBERGER

SURVEYS CORRECT TO: JUL 8 - 1964

PAUL S. ALLEN COAL CO.

N^o 2 MINE

UPPER FREEPORT WORKINGS

BOGGS TWP. ARMSTRONG COUNTY PA.

SCALE: 1" = 100' DATE: NOV. 1 1962

#48
5-26-62
C.C.