


PITTSBURGH & ERIE COAL CO.

M. T. HOPE COKE CO.
ELISBALEY TRACT

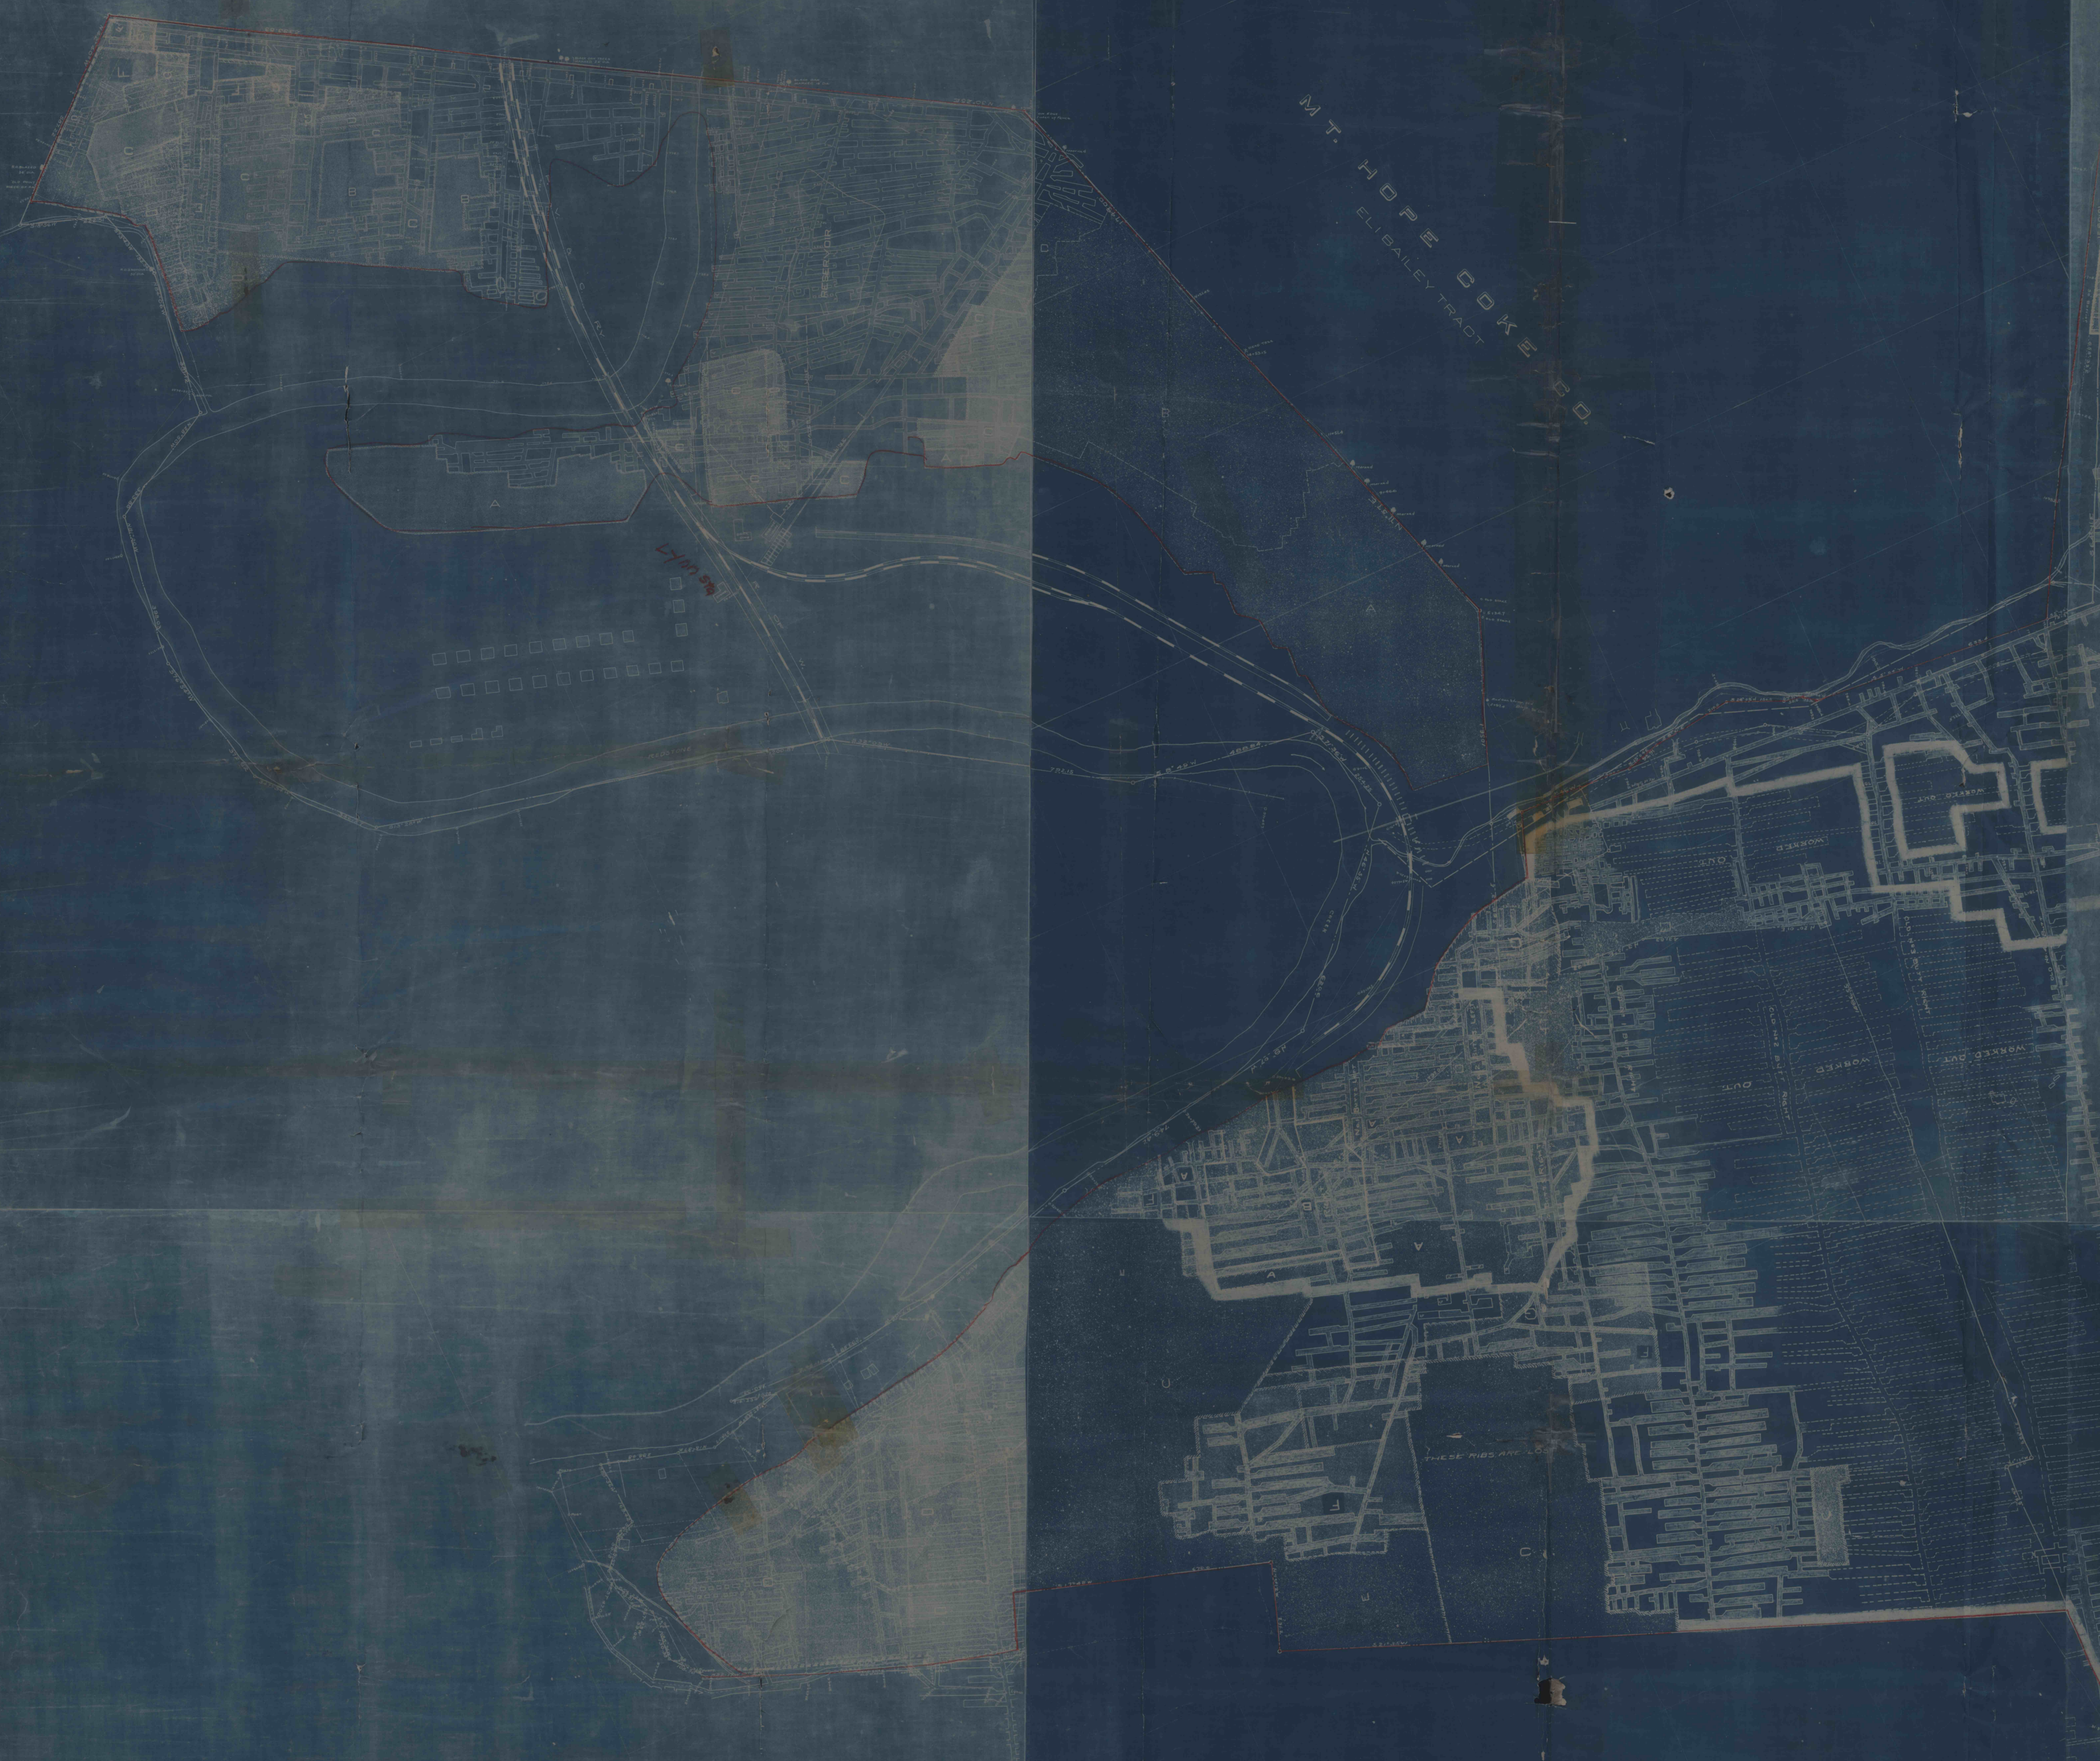

MAP OF M. R. C. C. & C. CO.
MINES NO. 1 & 2 AT
CYRILLA OR NO. 5 WORKS
NOW AMERICAN NO. 1
AMERICAN CONNELLSVILLE COAL & COKE CO.
REDSTONE & BROWNSVILLE TWPS.
FAYETTE CO., PA.

SCALE 1 INCH = 100 FEET
FEBRUARY 1910


HOMER L. BROWN, DRAWN
PITTSBURGH, PA.

*Pittsburg 1017
Average Height 70*