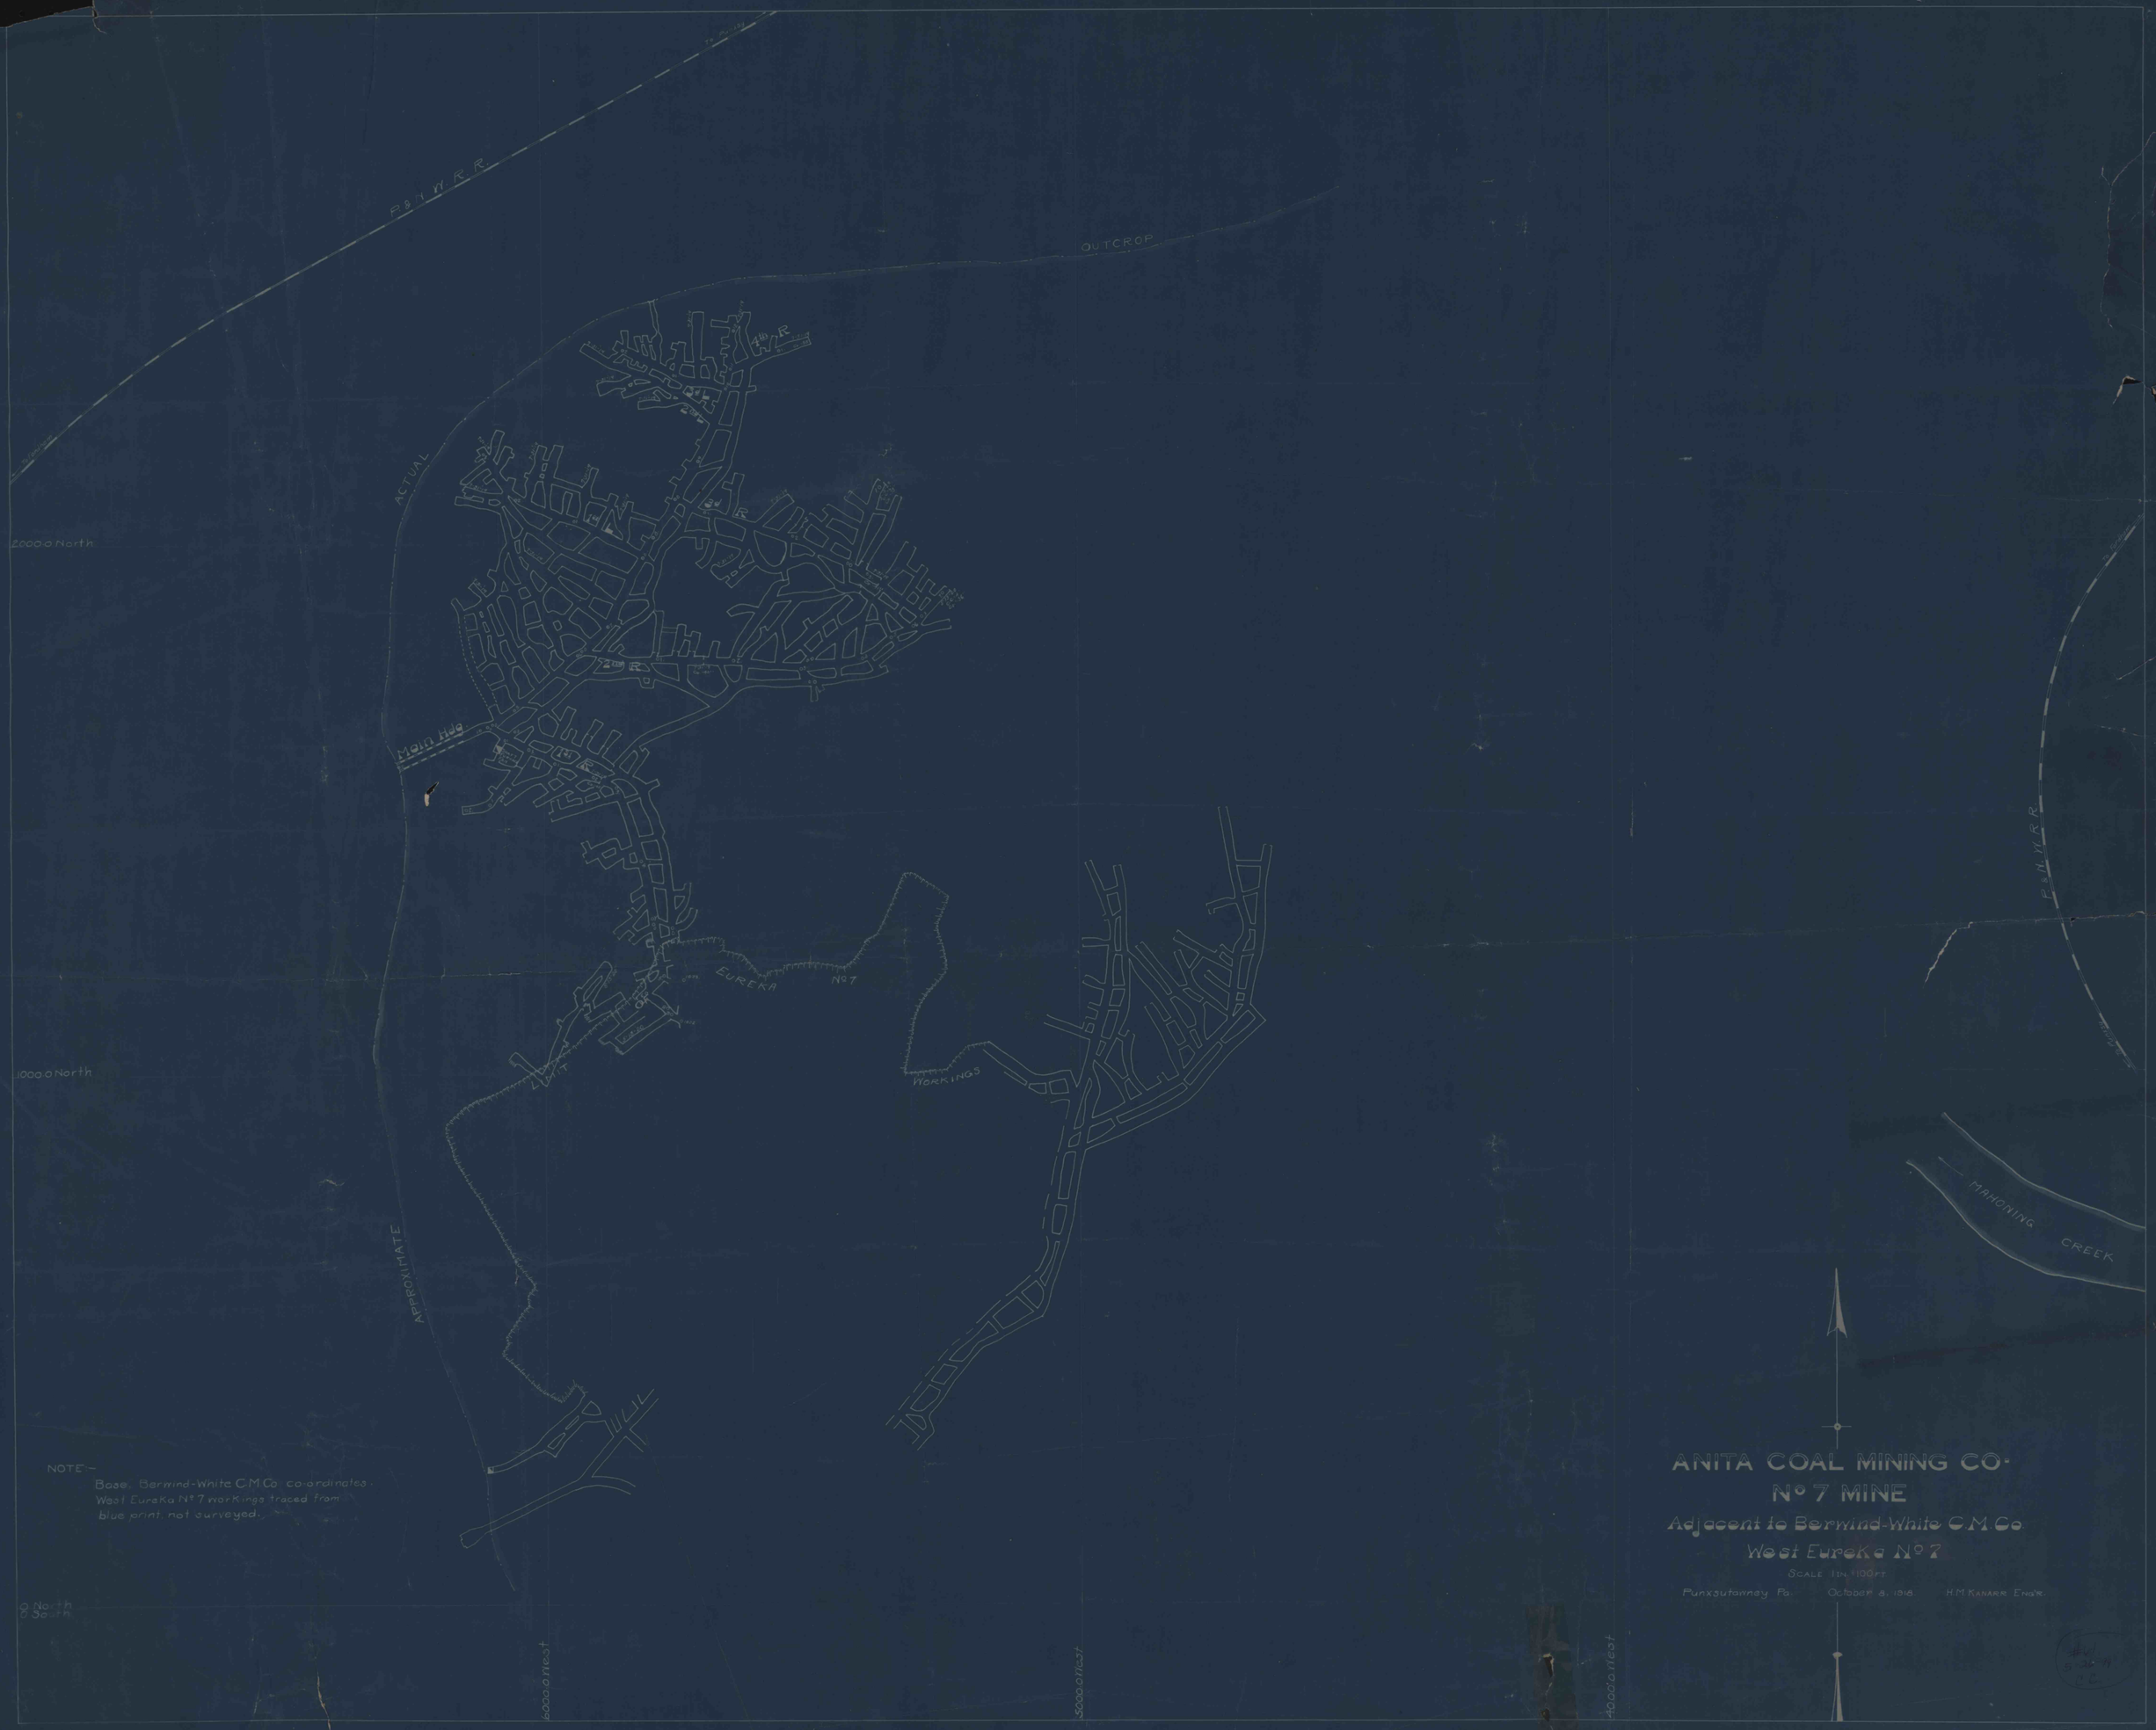

NOTE:—
Base. Berwind-White C.M.Co. co-ordinates.
West Eureka No 7 workings traced from
blue print, not surveyed.

ANITA COAL MINING CO.
No 7 MINE
Adjacent to Berwind-White C.M.Co.
West Eureka No 7

SCALE 1 IN. = 100 FT.

Punxsutawney Pa. October 8, 1918. H.M. KANARR ENG'R.