Coal exhausted in
Area shaded in Yellow
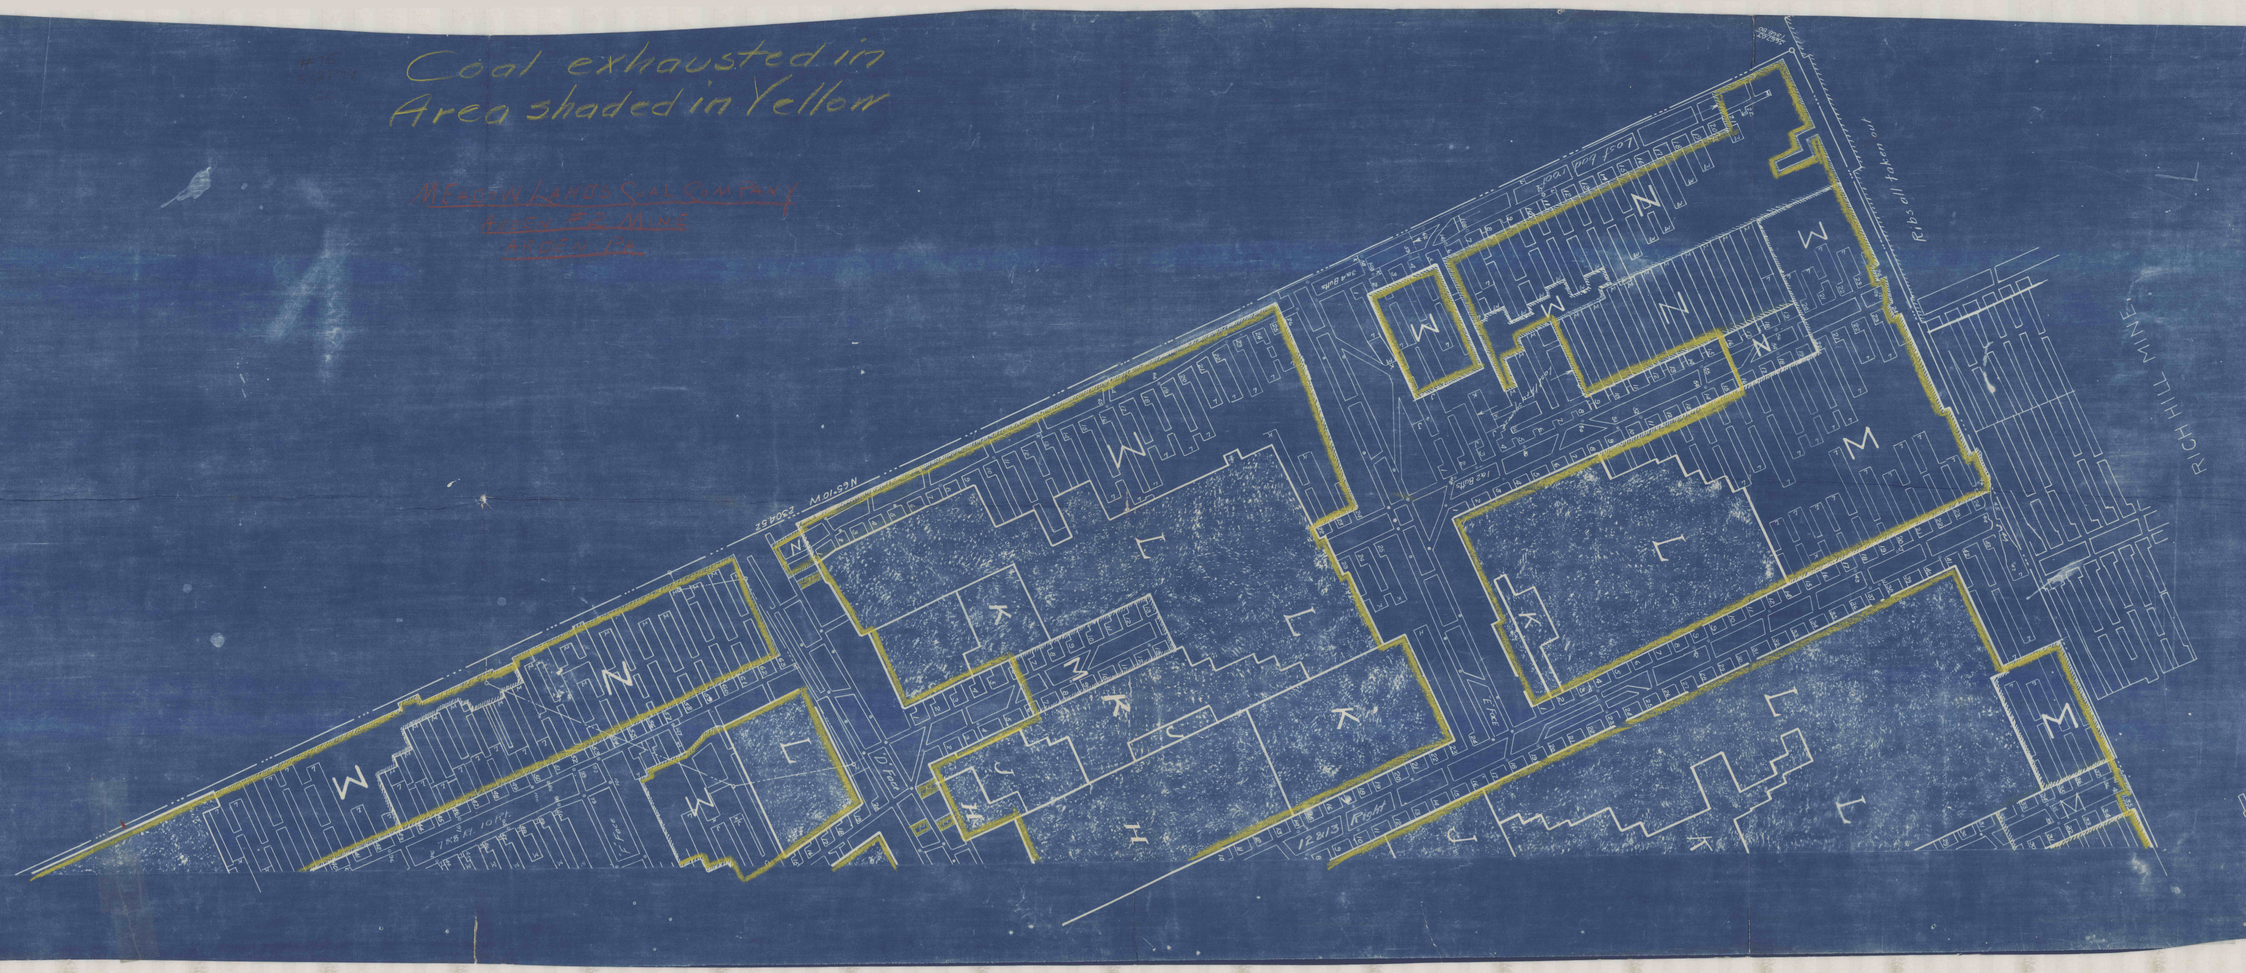
McEwen Land & Coal Company
Arden #2 Mine
Arden, Ca.