


MARTIN-MARIETTA CO.


MARTIN-MARIETTA CO.

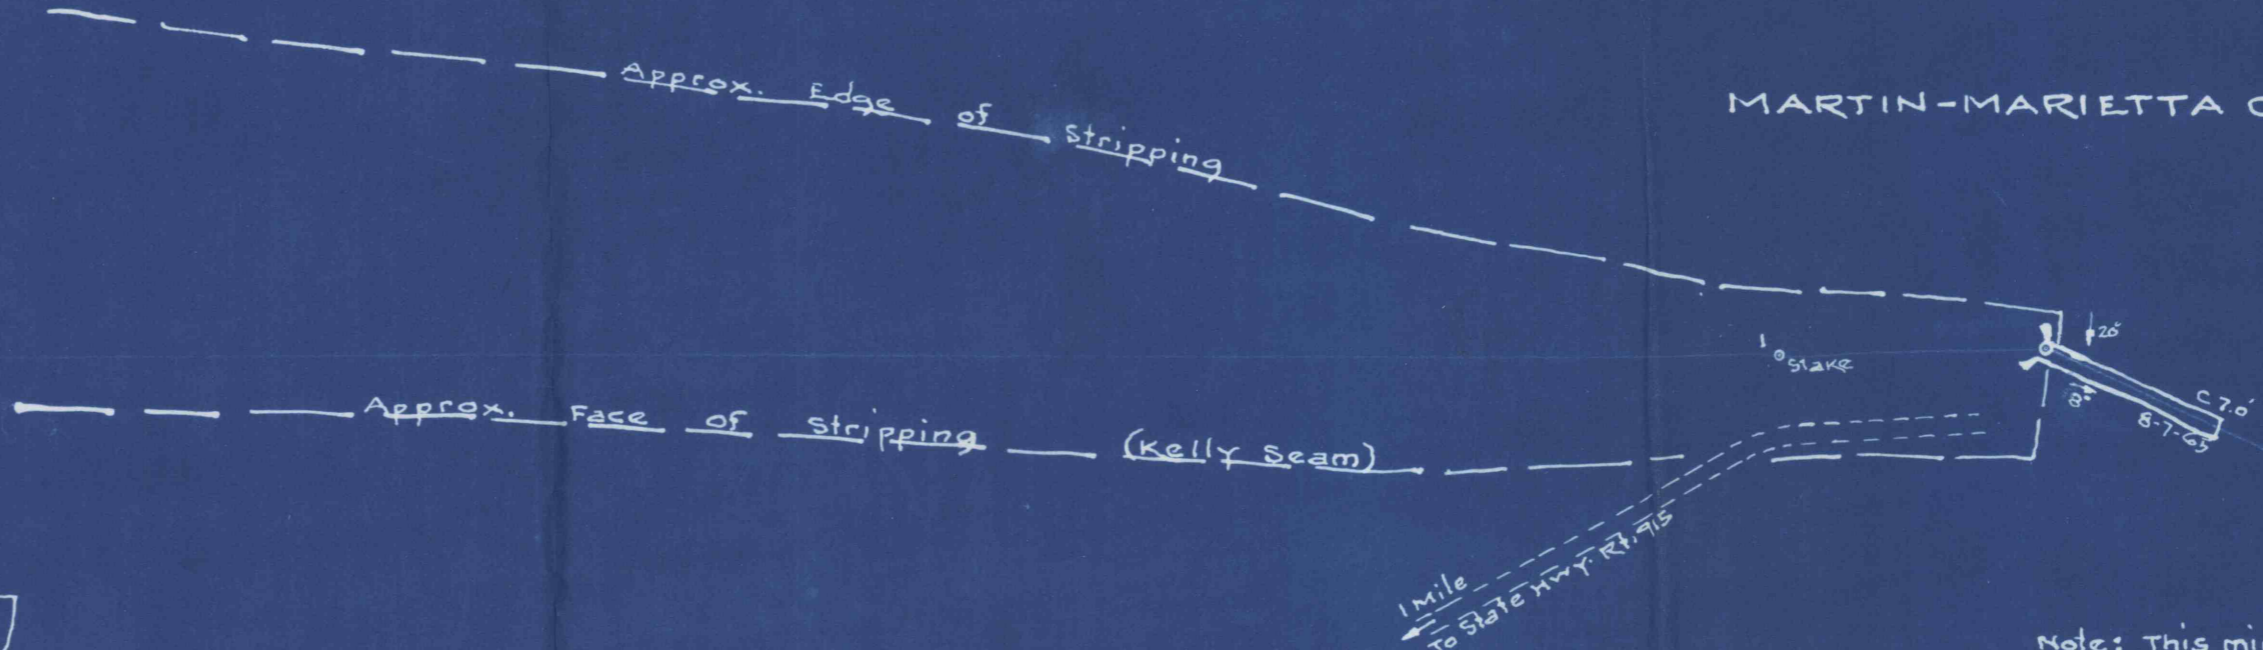

Face of

MARTIN-MARIETTA CO.

Note: This mine was abandoned by
O.J. Shaw August 7-1965

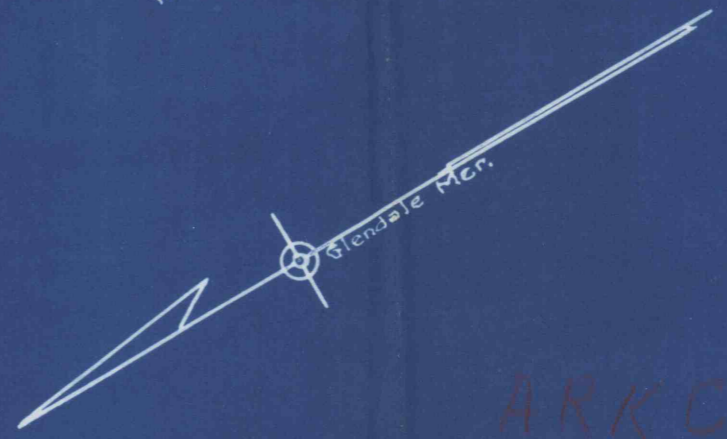


ARKCOALCO
ARKH MINE

MINE ON FACE OF STRIPPING
OPERATED BY O.J. SHAW
BROAD TOP TOWNSHIP - BEDFORD COUNTY
Scale: 1"=100'

Guy C. ASKEY, P.E.
Bedford, Pa.

Aug. 1965

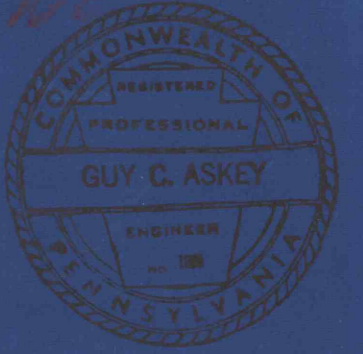

#78
5-27-99

Manway