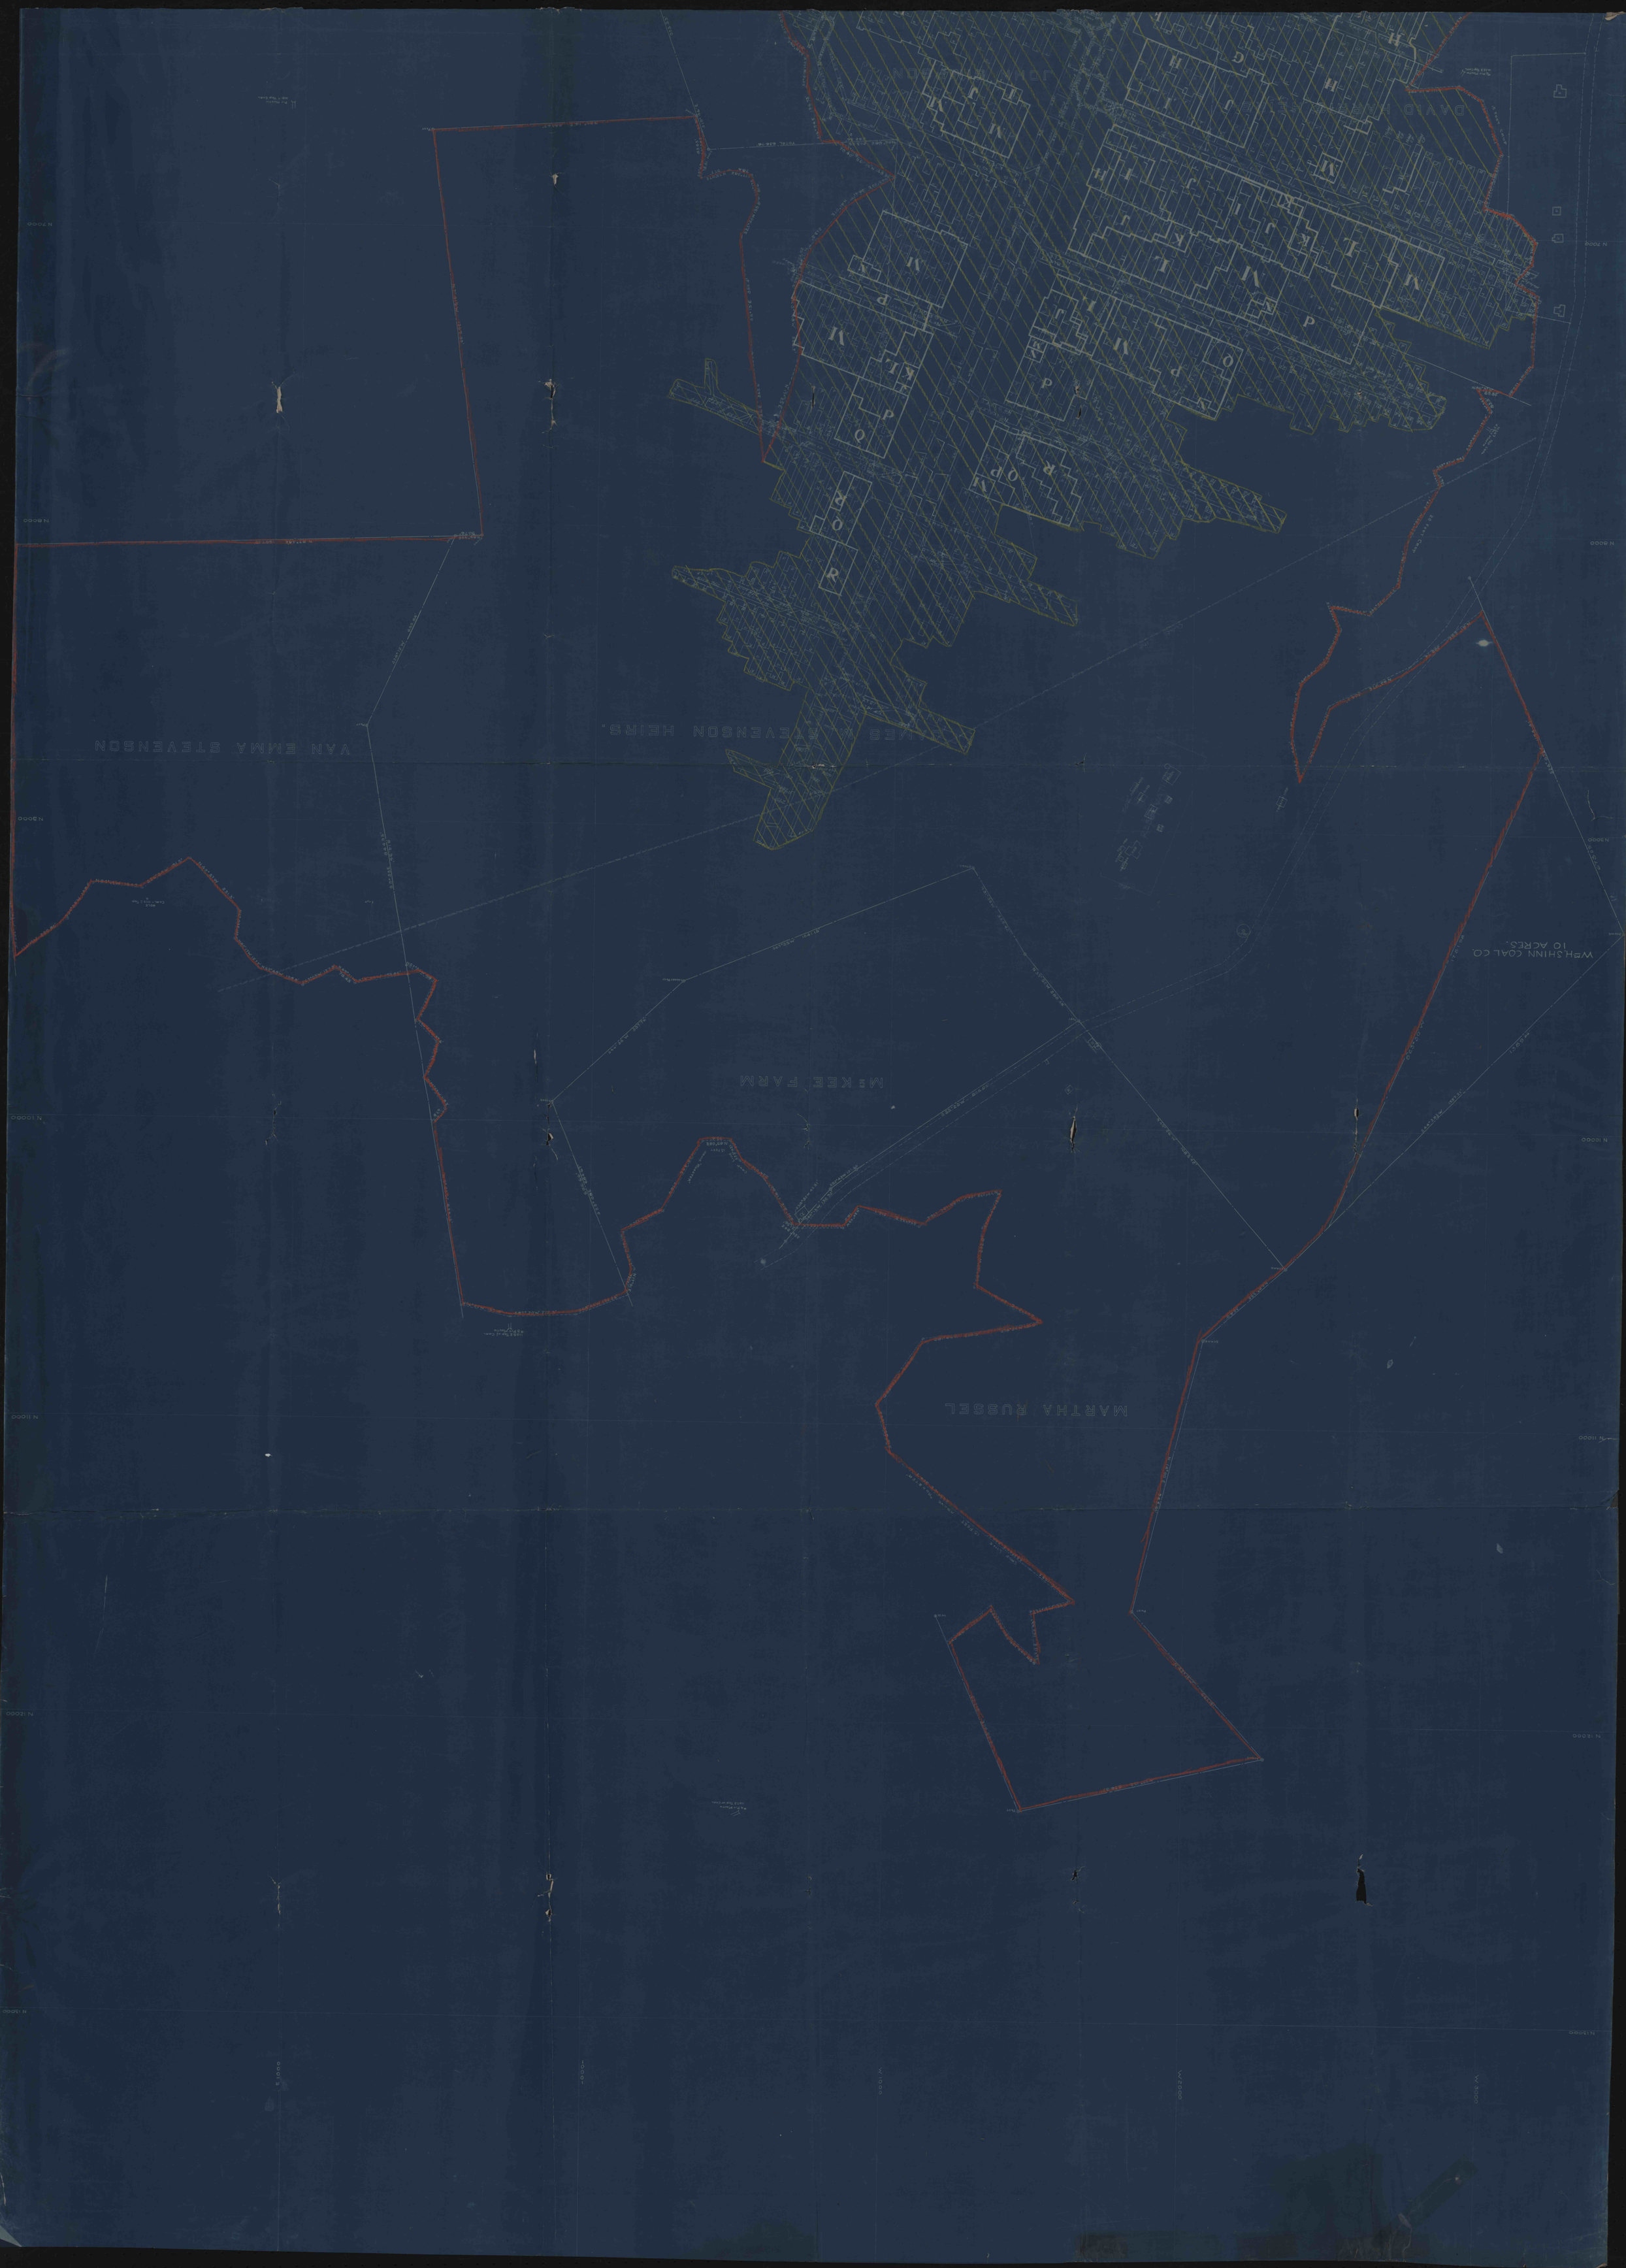
DAVID H. STEVENSON
VAN EMMA STEVENSON
JAMES M. STEVENSON HEIRS.
M. KEE FARM
MARTHA RUSSEL
W. H. SHINN COAL CO.
10 ACRES.
N 7000
N 8000
N 9000
N 10000
N 11000
N 12000
N 13000
E 1000
W 1000
W 2000
W 3000