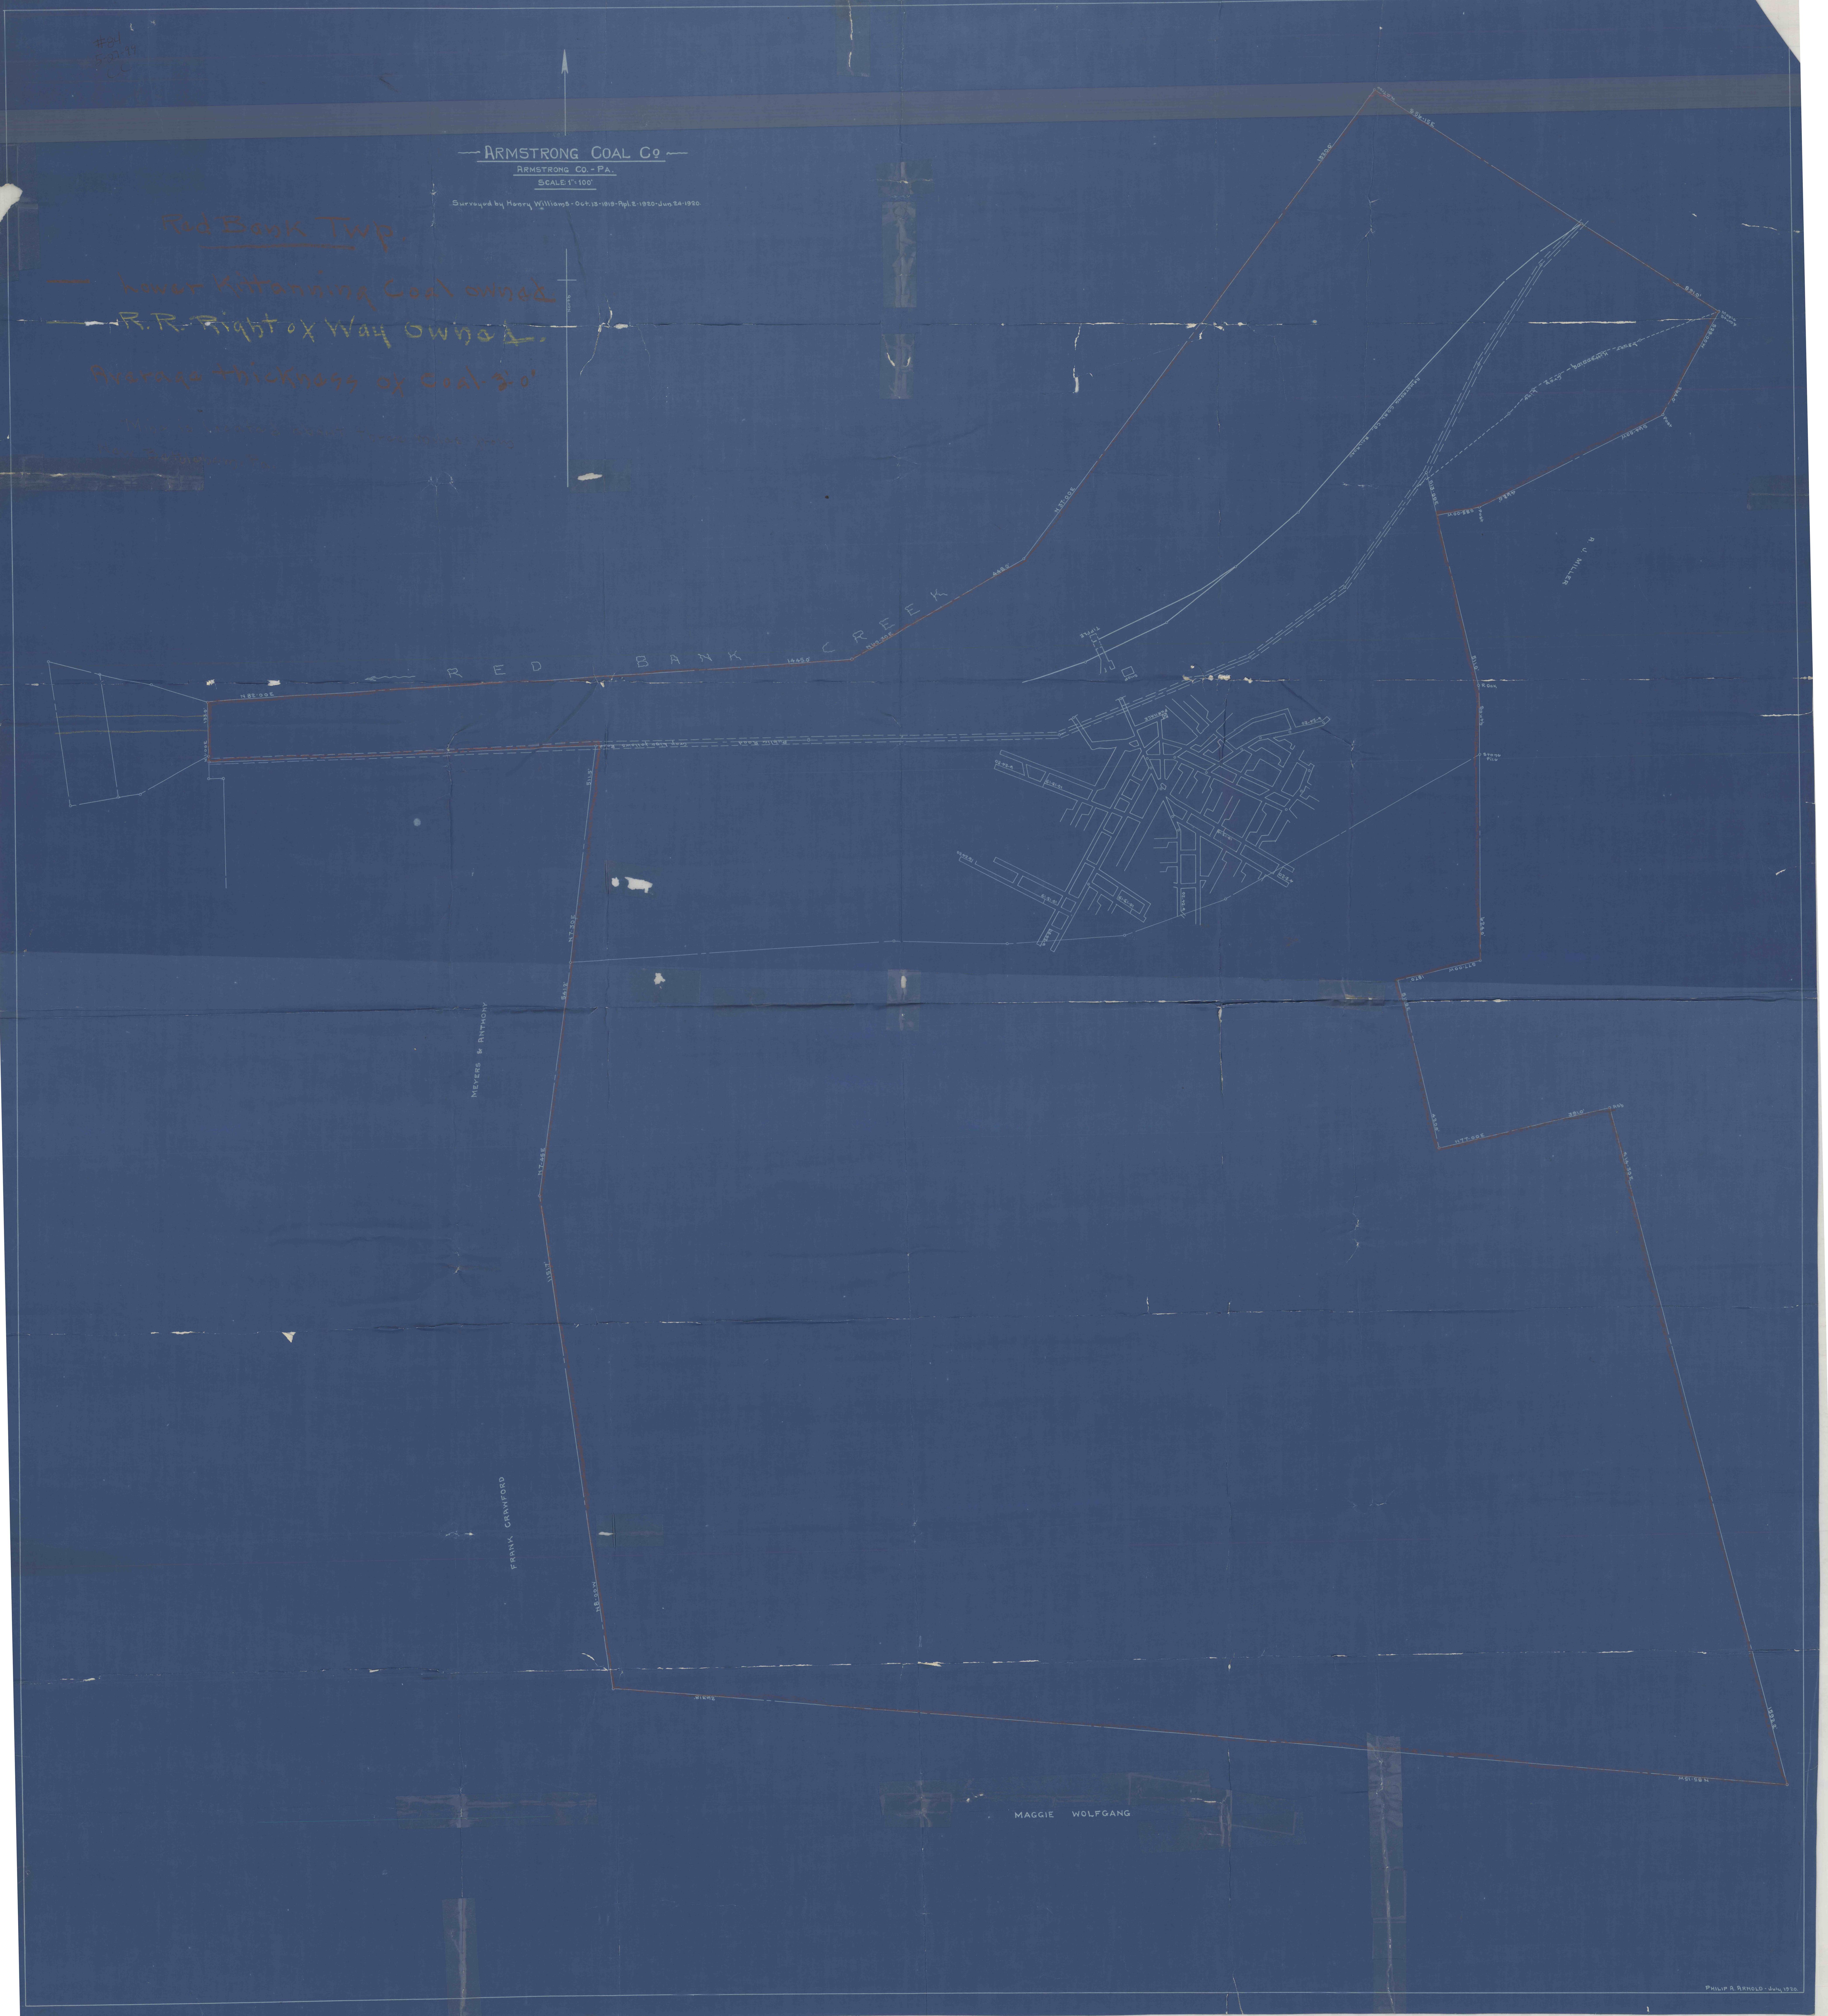
#84
5-22-99
CC
ARMSTRONG COAL Co
ARMSTRONG CO. - PA.
SCALE: 1" = 100'
Surveyed by Henry Williams - Oct. 13-1919 - Apl. 2-1920 - Jun. 24-1920.
Red Bank Twp.
Lower Kittanning Coal owned
R.R. Right of Way owned.
Average thickness of Coal 3-0'
North
RED BANK CREEK
N82-00E
133.0'
N1-00E
1445.0'
N40-30E
448.0'
N37-00E
1320.0'
S56-15E
891.0'
Maple Stump
S28-00W
240.0'
Post
S64-00W
447.0'
S85-00W
Post
S13-00E
511.0'
R. Oak
South
Stone Pile
624.0'
S77-00W
187.0
420.0'
N77-00E
391.0'
S14-30E
1592.8'
N85-15W
2431.8'
N8-00W
1151.7'
N7-45E
541.2'
N7-30E
511.5'
Public Road
Armstrong Coal Co. Railroad
Lower Kittanning Crop Line
TIPPLE
SHOP
FURNACE
R. J. MILLER
MEYERS & ANTHONY
FRANK CRAWFORD
MAGGIE WOLFGANG
PHILIP A. ARNOLD - July 1920.