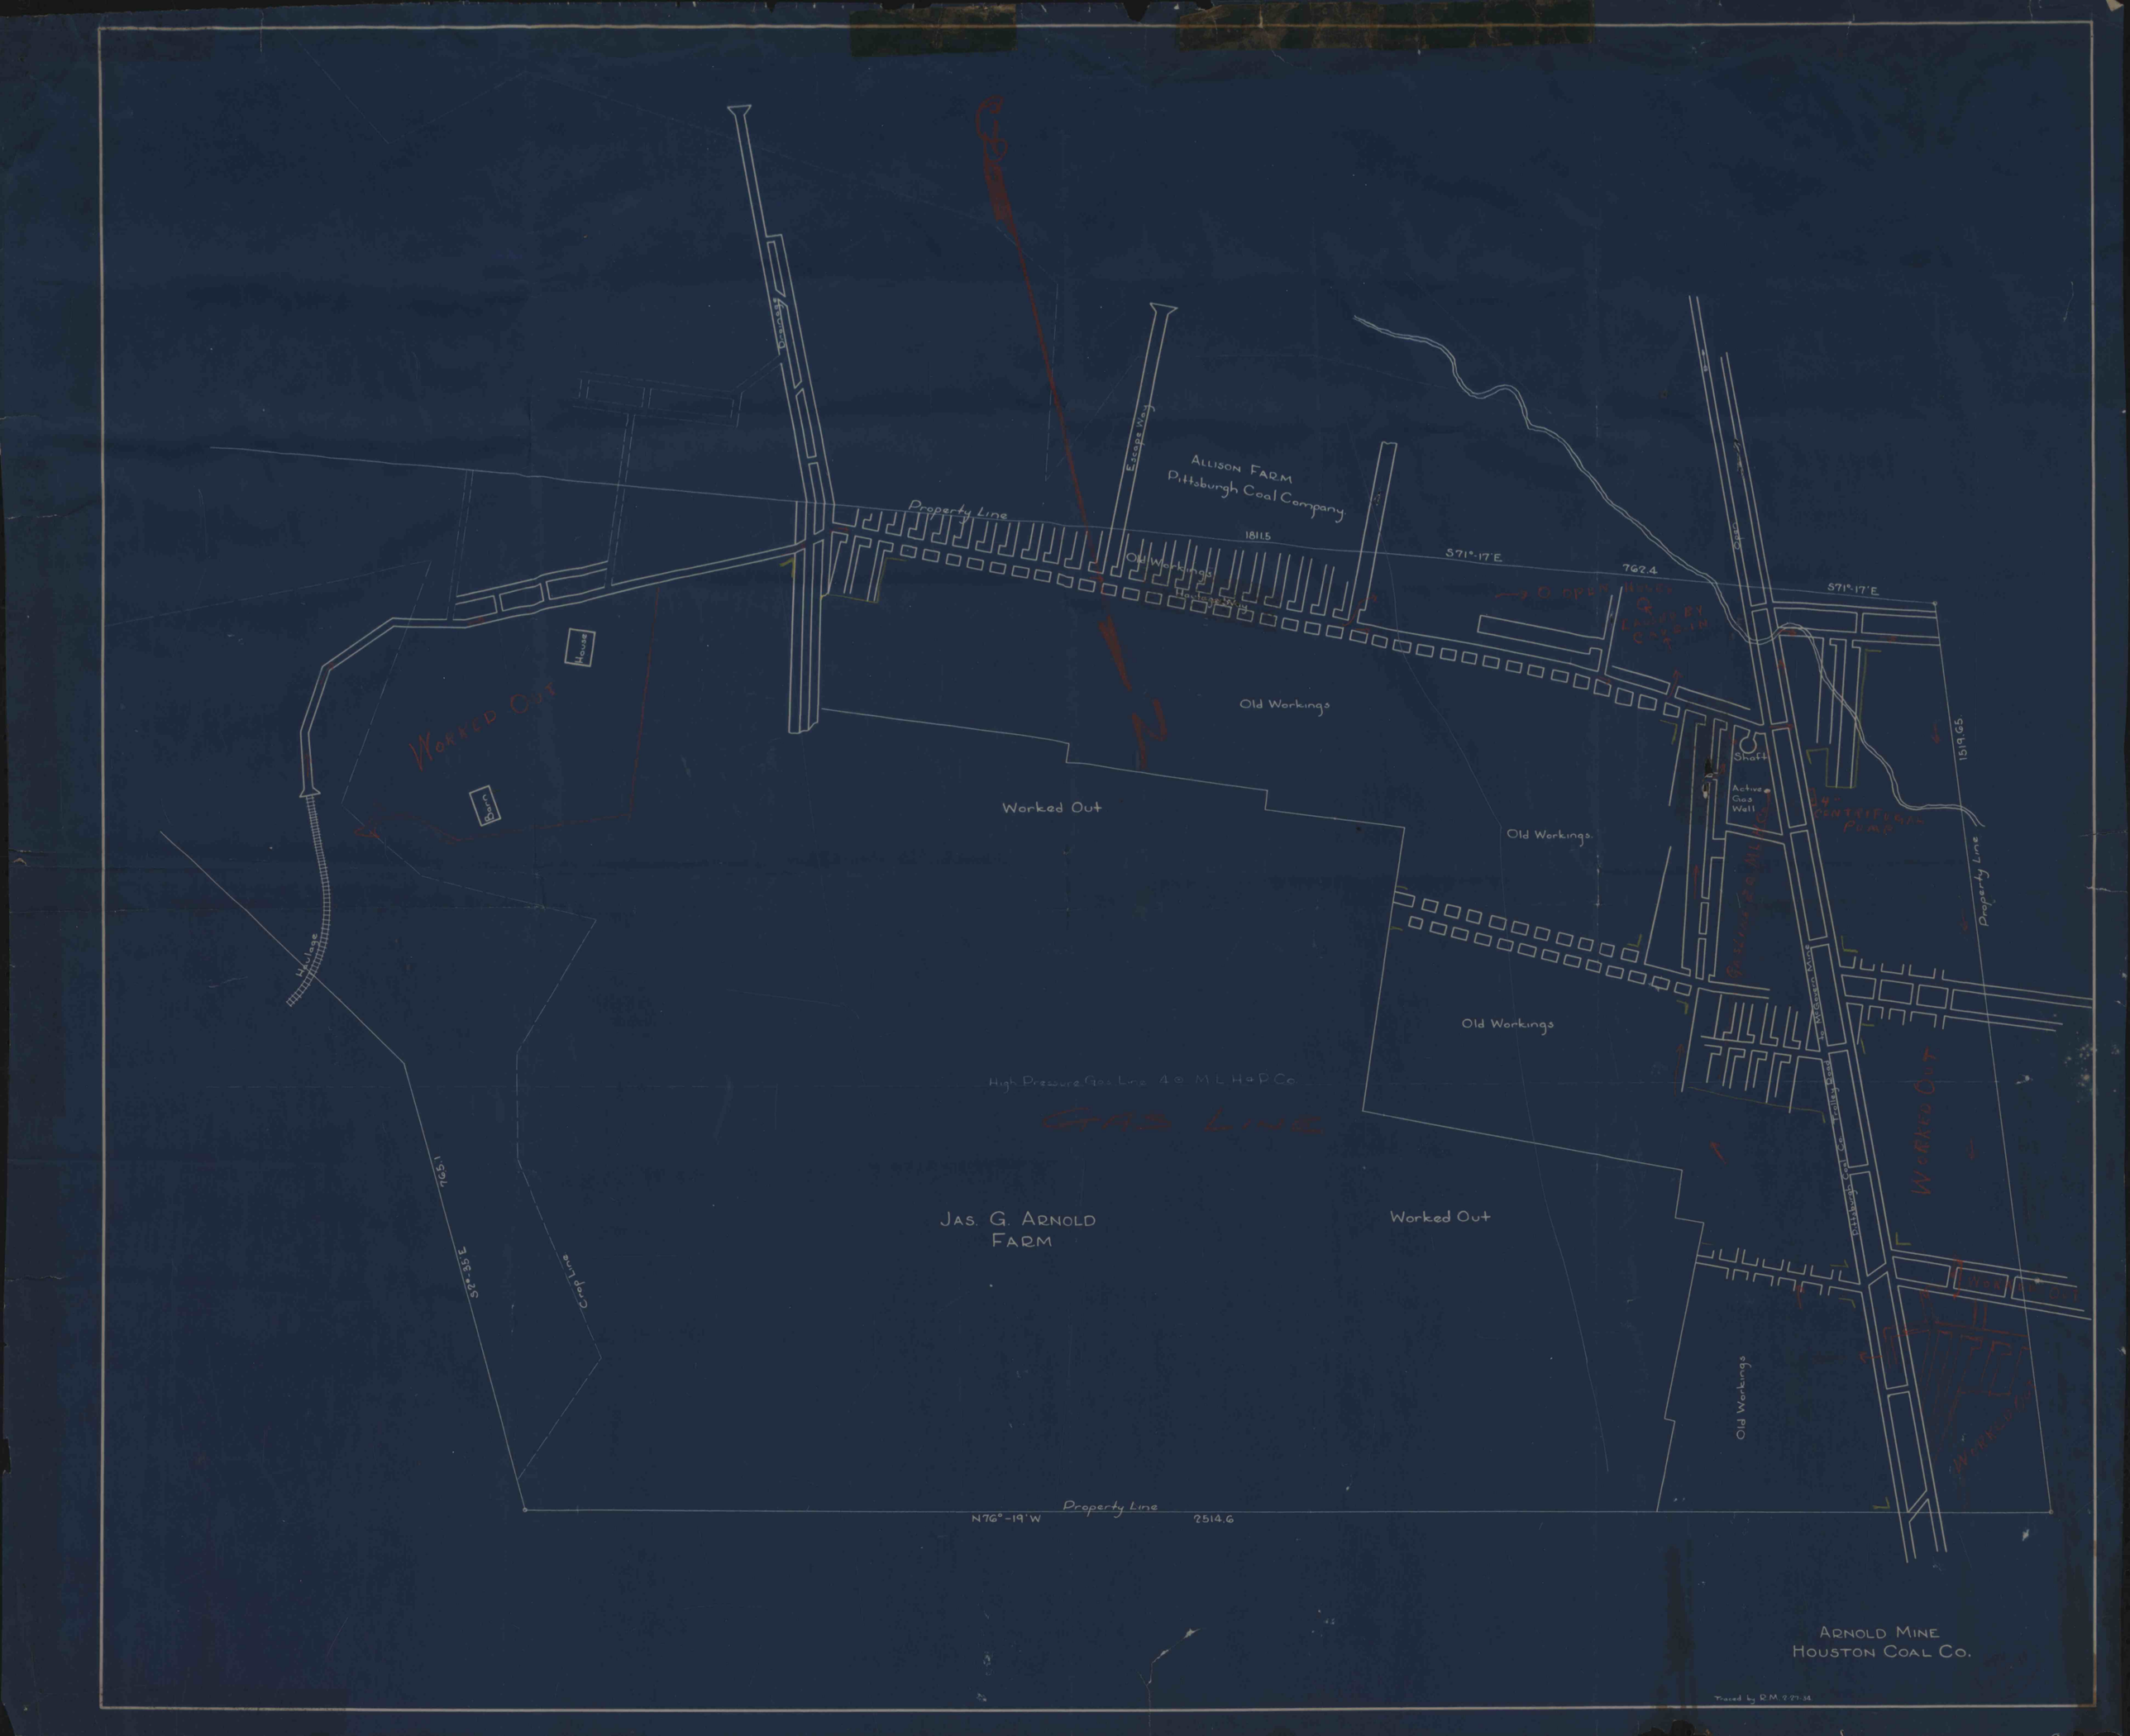

Allison Farm
Pittsburgh Coal Company
Property Line
1811.5
S71°-17'E
762.4
S71°-17'E
Escape Way
Old Workings
Haulage Way
Old Workings
Worked Out
Old Workings
Old Workings
Worked Out
Worked Out
Shaft
Active Gas Well
4" Centrifugal Pump
1519.65
Property Line
Haulage
Crop Line
765.1
S2°-35'E
High Pressure Gas Line 4 @ M.L.H.&P.Co.
Gas Line
Jas. G. Arnold Farm
Worked Out
Old Workings
Property Line
N76°-19'W
2514.6
Arnold Mine
Houston Coal Co.