


Magnetic Meridian  
April 23, 1902

WORKED OUT

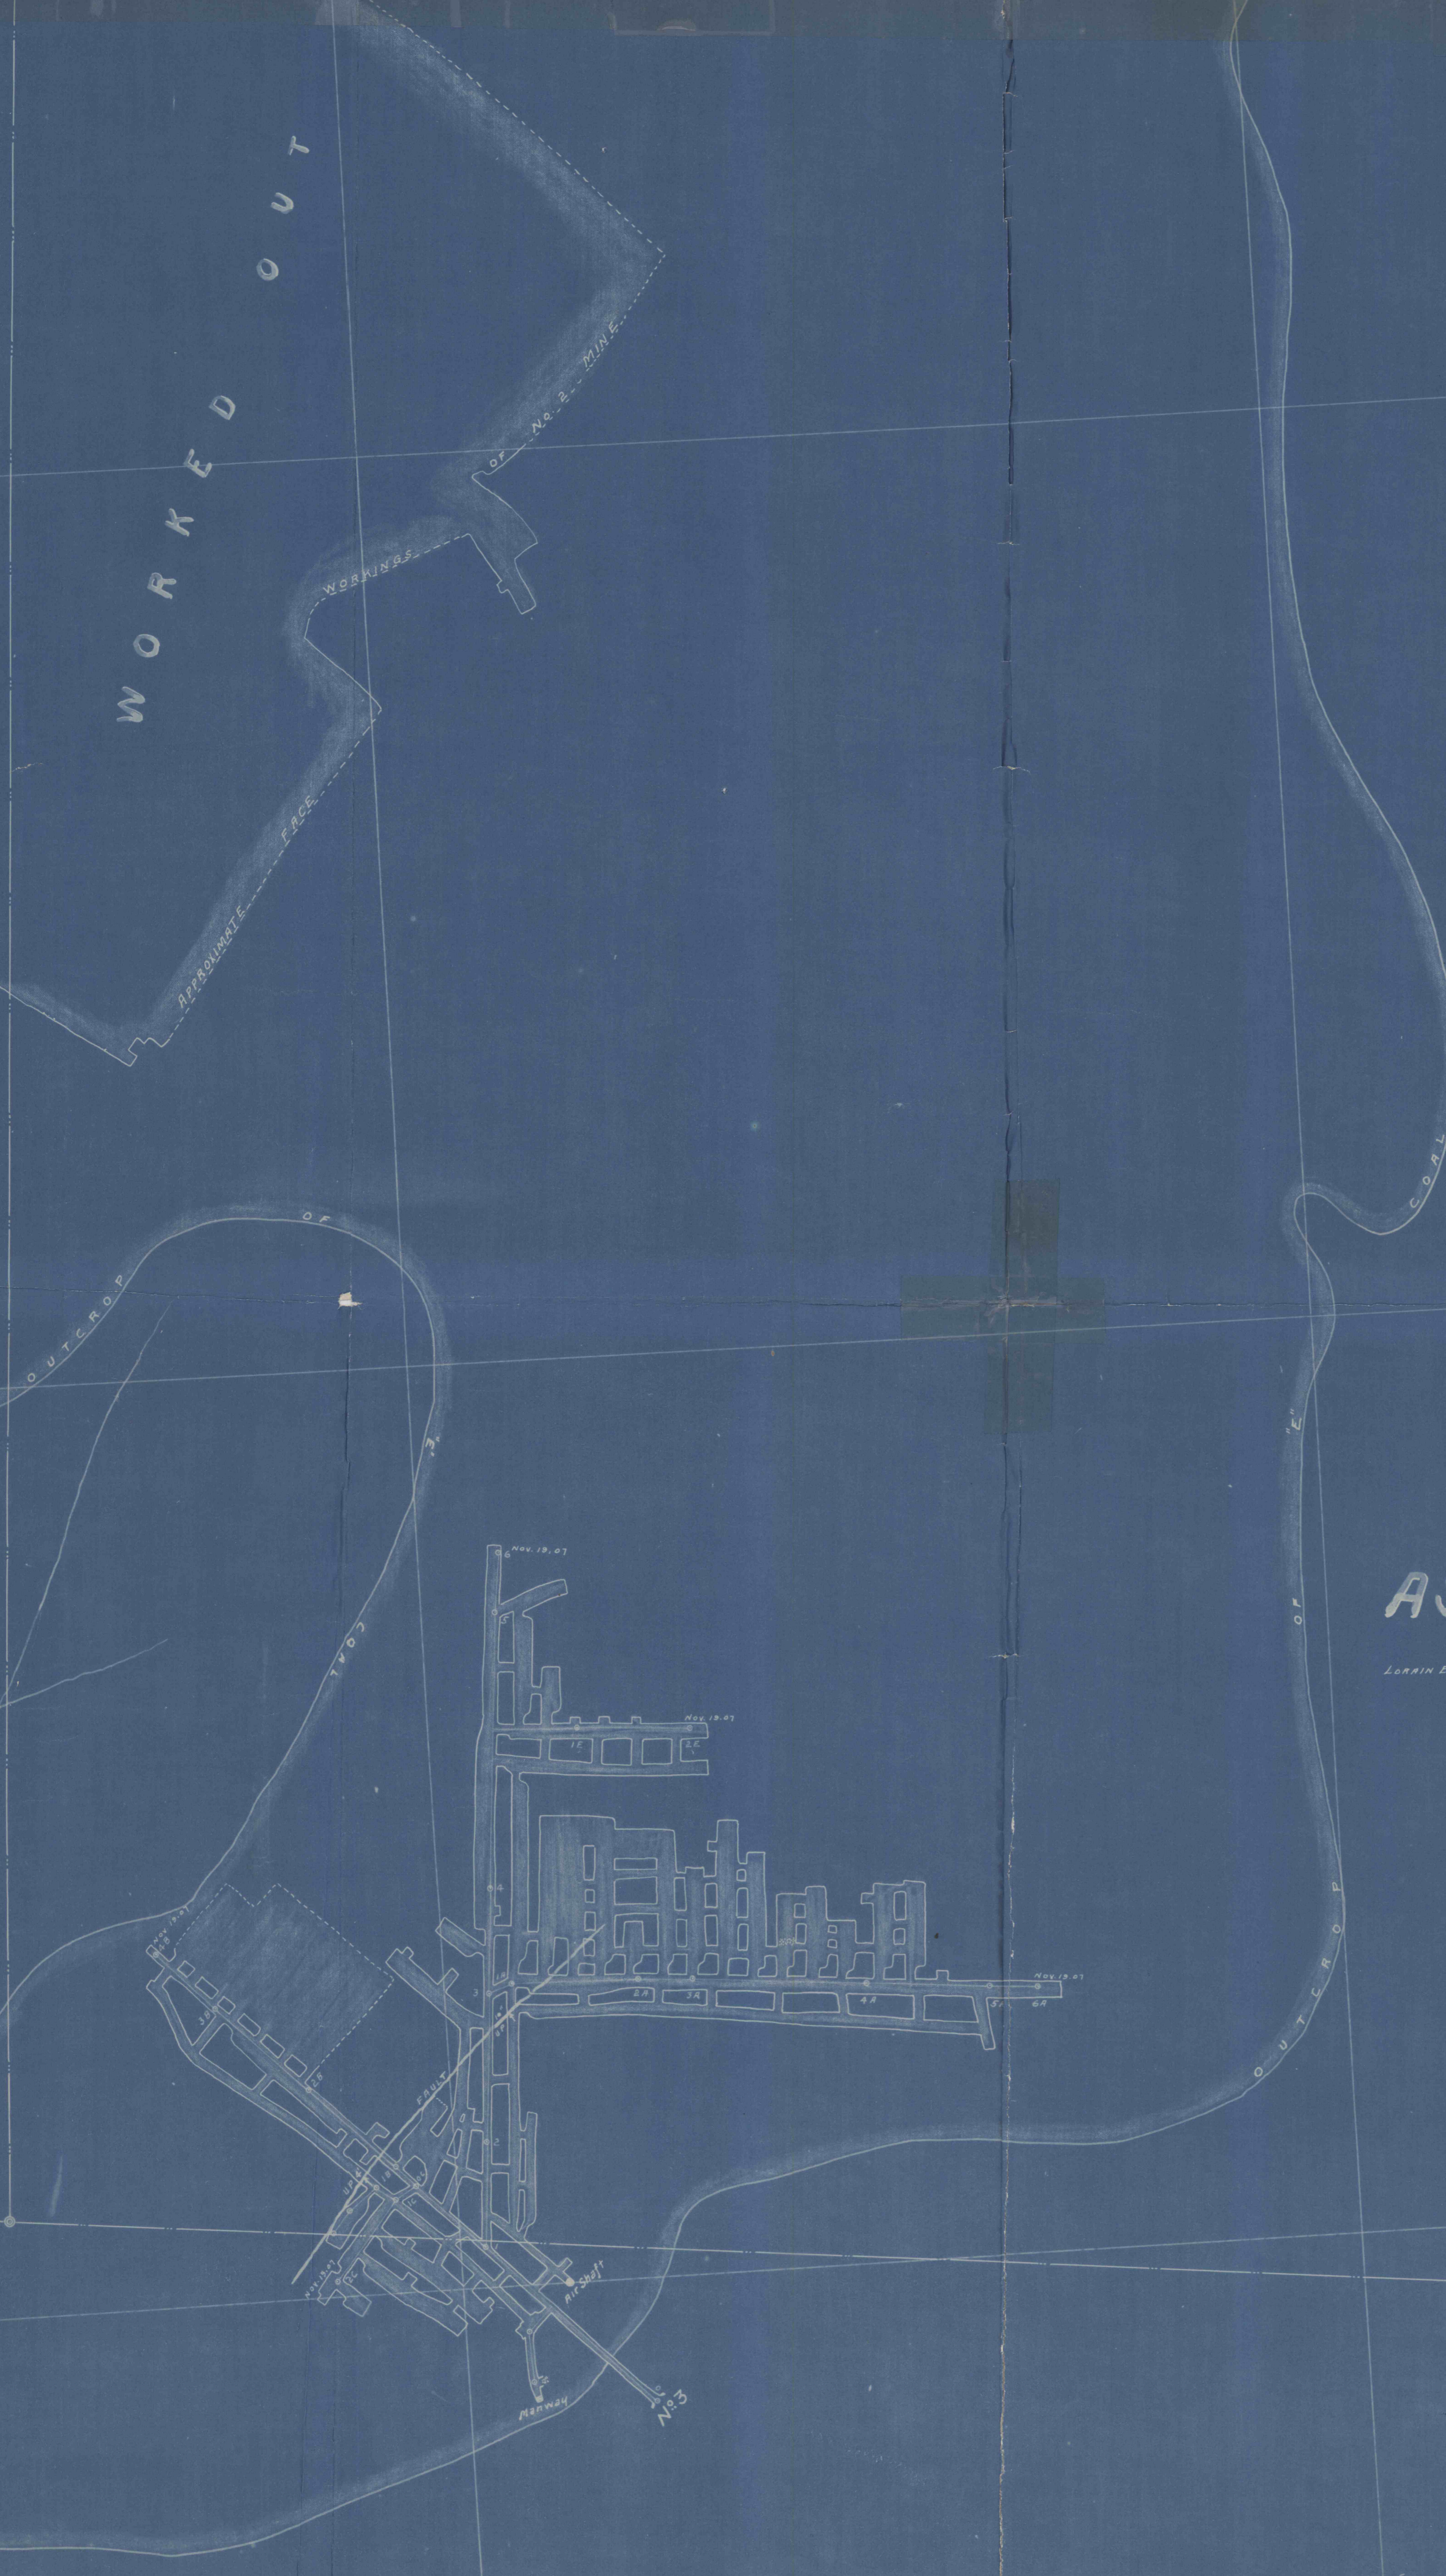

STONE

24.0866'

N. 85° 58' W.

STONE

#92  
5-28-79  
C.L.