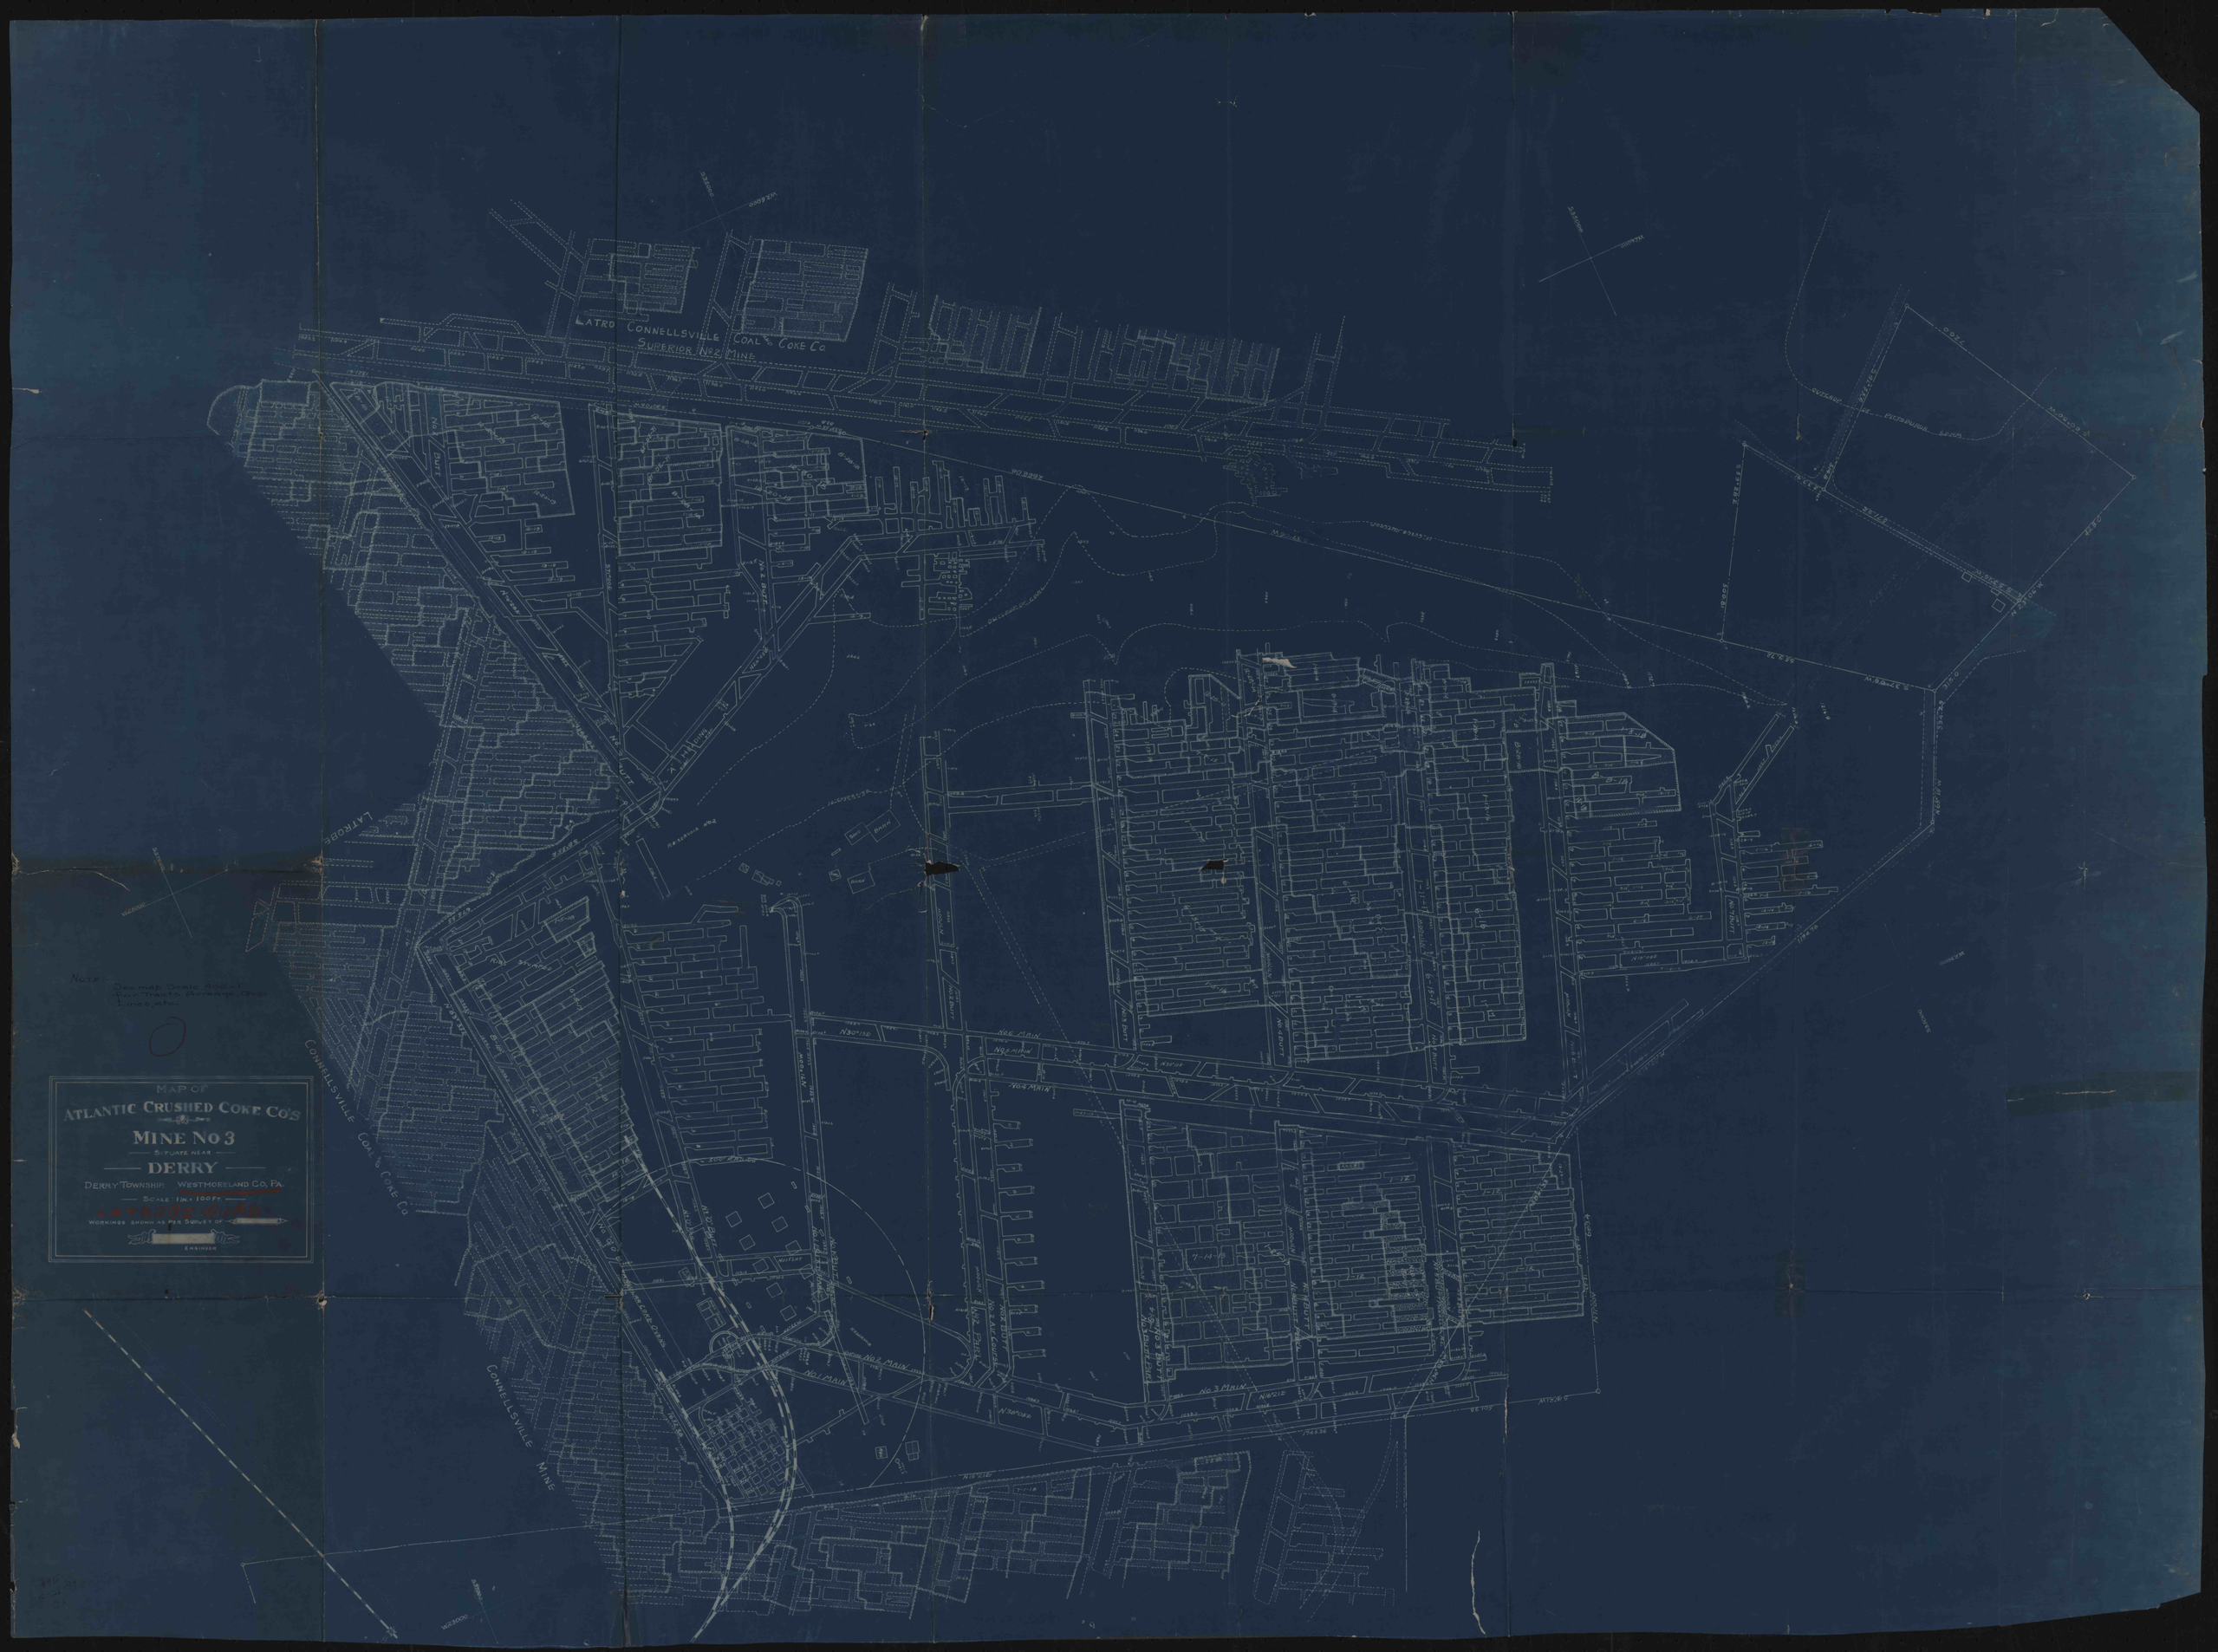

LATRO CONNELLSVILLE COAL & COKE CO.
SUPERIOR No 2 MINE
MAP OF
ATLANTIC CRUSHED COKE CO'S
MINE No 3
SITUATE NEAR
DERRY
DERRY TOWNSHIP WESTMORELAND CO, PA.
SCALE: 1 IN. = 100 FT.
WORKINGS SHOWN AS PER SURVEY OF
ENGINEER
CONNELLSVILLE COAL & COKE CO
CONNELLSVILLE MINE
No 1 MAIN
No 2 MAIN
No 3 MAIN
No 4 MAIN
No 5 MAIN
No 6 MAIN